


AS1 #23	09/18/03
AS1 #22	08/01/03
AS1 #18	04/18/03
100% Construction Documents	09/27/02
Issue	Date
*New sheet. Former details now on A362, A363	

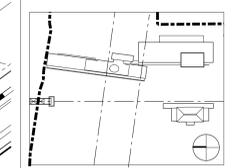


Job No. 9908
Scale 3" = 1'-0"
Date September 27, 2002
Title


**WALL SYSTEM C
GLAZING DETAILS**

Sheet No. **A364**


FOR OFFICIAL USE ONLY

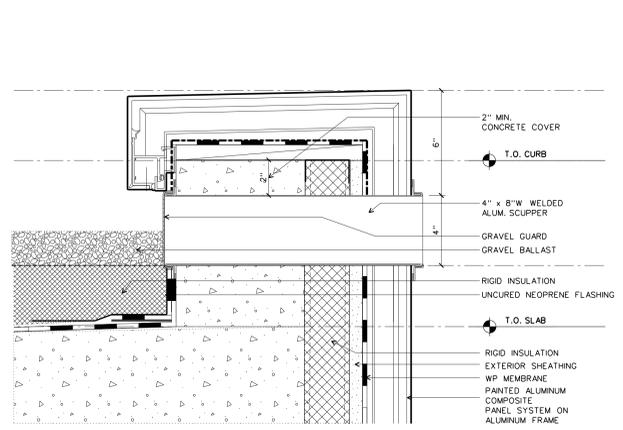


WALL SYSTEM C: GENERIC DETAIL SECTION FOR SCUPPER CONDITION
SCALE: 3" = 1'-0"
D-CWC05 41

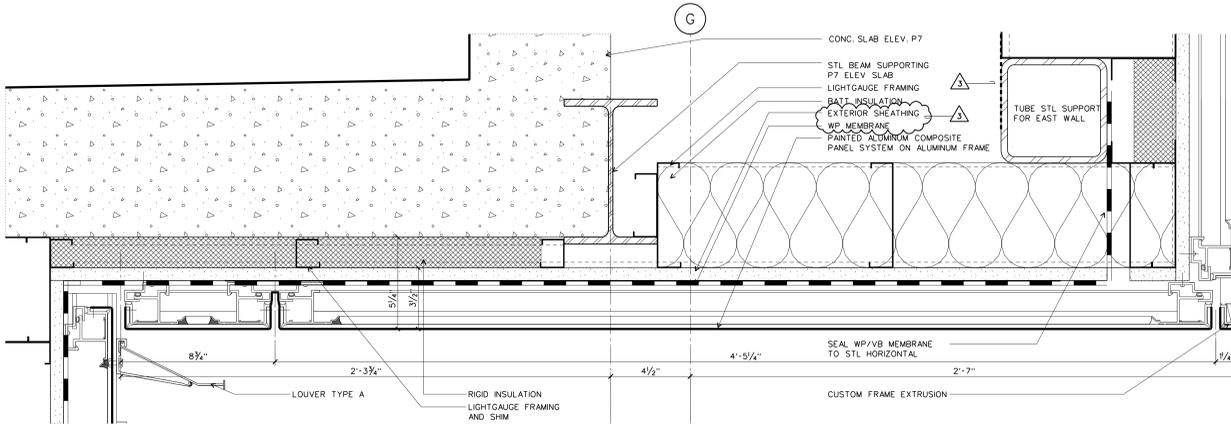


WALL SYSTEM C: SECTION DETAIL @ UNDERSIDE EAST-UNDER PE7
SCALE: 3" = 1'-0"
D-CWC05 40

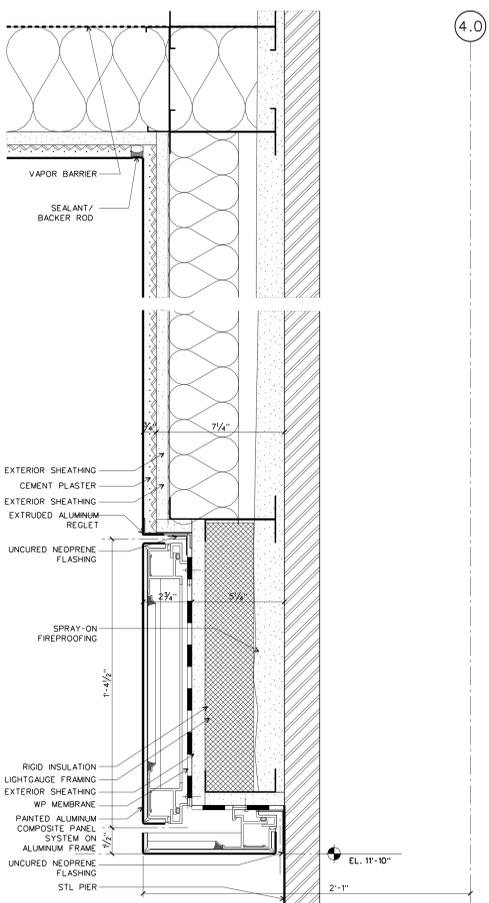


WALL SYSTEM C: DETAIL SECTION @ NORTH PIER/STAIR 2
SCALE: 3" = 1'-0"
D-CWC05 25

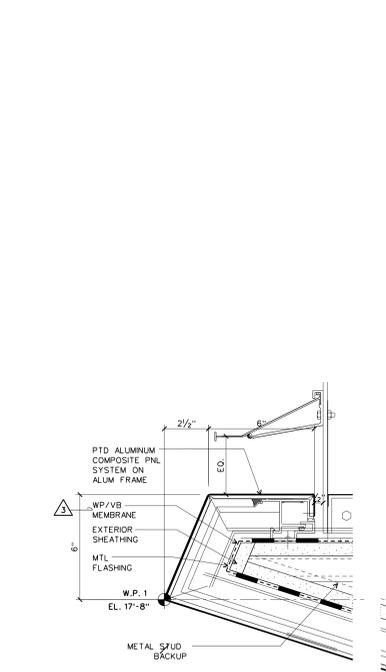


WALL SYSTEM C: SECTION DETAIL @ UNDERSIDE WEST
SCALE: 3" = 1'-0"
D-CWC05 24

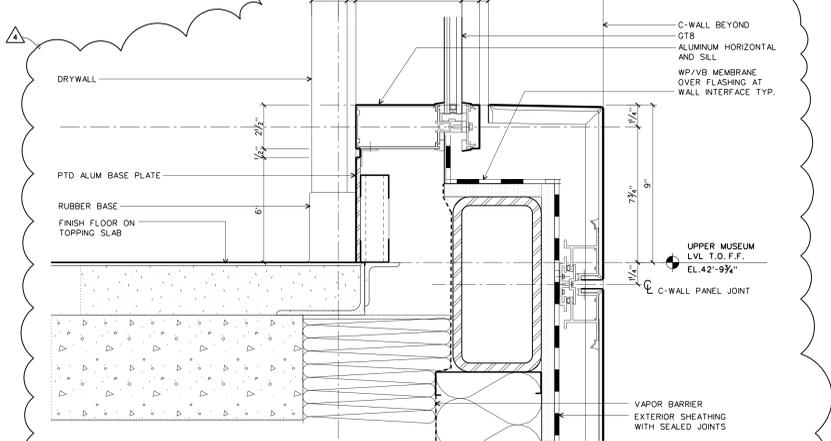


WALL SYSTEM C: SILL DETAIL AT GREEN ROOM WINDOW
SCALE: 3" = 1'-0"
D-CWC05 31

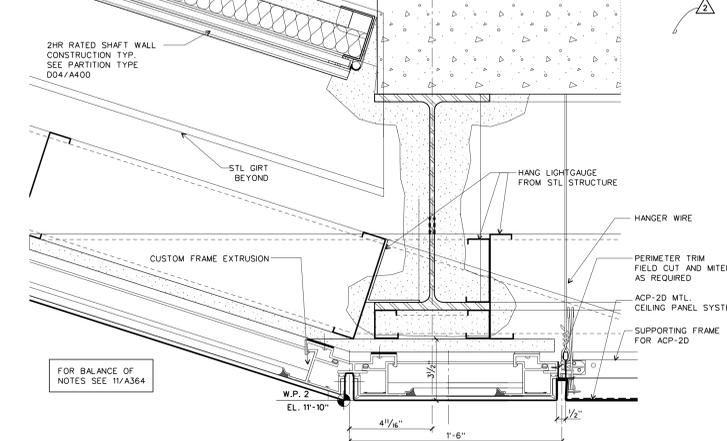


WALL SYSTEM C: SECTION DETAIL @ UNDERSIDE WEST
SCALE: 3" = 1'-0"
D-CWC05 30

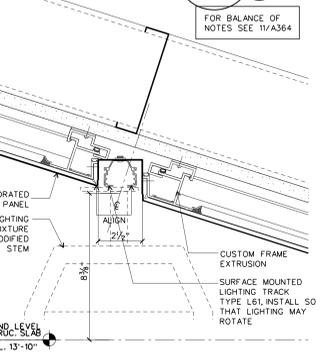


WALL SYSTEM C: SECTION DETAIL @ UNDERSIDE WEST-MID-LIGHTING
SCALE: 3" = 1'-0"
D-CWC05 23

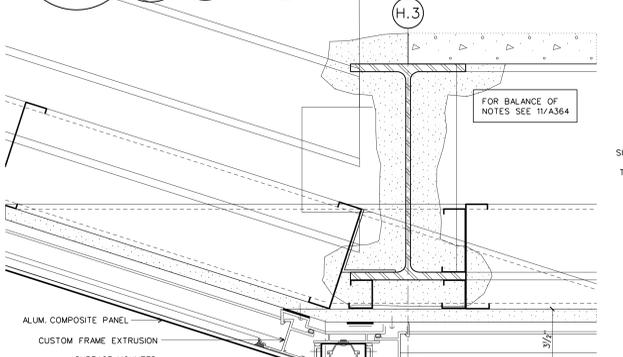


WALL SYSTEM C: SECTION DETAIL @ UNDERSIDE WEST-LIGHTING
SCALE: 3" = 1'-0"
D-CWC05 22

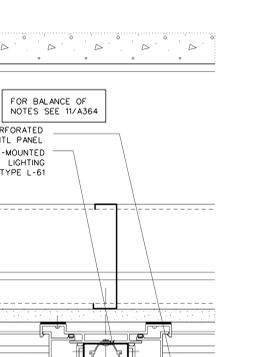


WALL SYSTEM C: SECTION DETAIL @ UNDERSIDE CTR-LIGHTING
SCALE: 3" = 1'-0"
D-CWC05 21

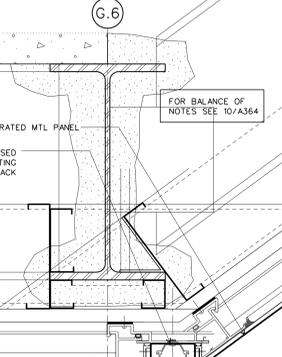


WALL SYSTEM C: SECTION DETAIL @ UNDERSIDE EAST-LIGHTING
SCALE: 3" = 1'-0"
D-CWC05 20

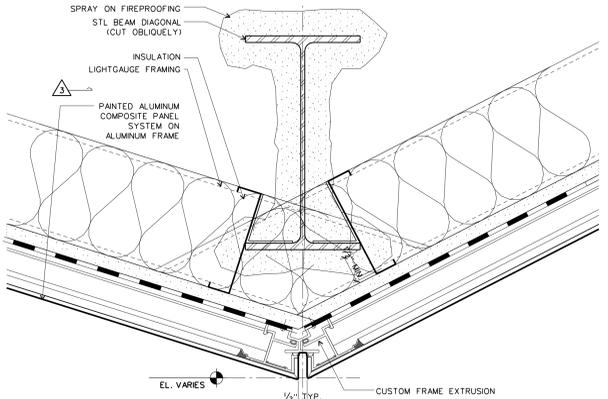


WALL SYSTEM C: SECTION DETAIL @ 2-PLANE INTERSECTION, UNDERSIDE
SCALE: 3" = 1'-0"
D-CWC05 13

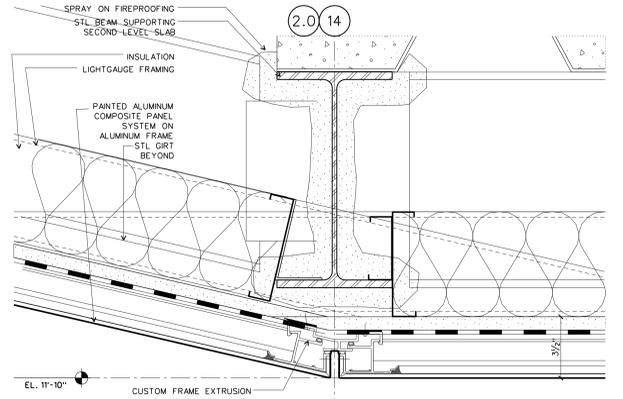

WALL SYSTEM C: SECTION DETAIL @ UNDERSIDE NORTH/SOUTH
SCALE: 3" = 1'-0"
D-CWC05 12

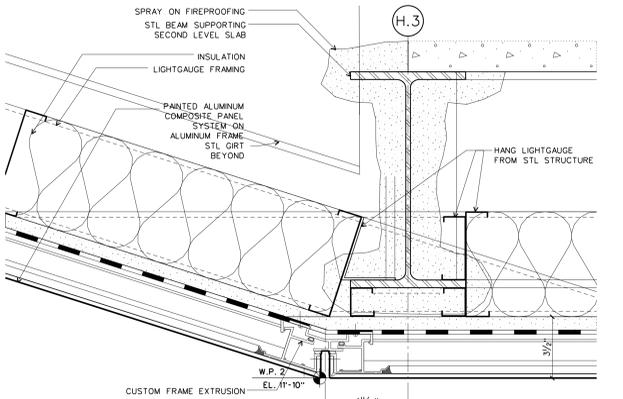

WALL SYSTEM C: SECTION DETAIL @ UNDERSIDE WEST
SCALE: 3" = 1'-0"
D-CWC05 11

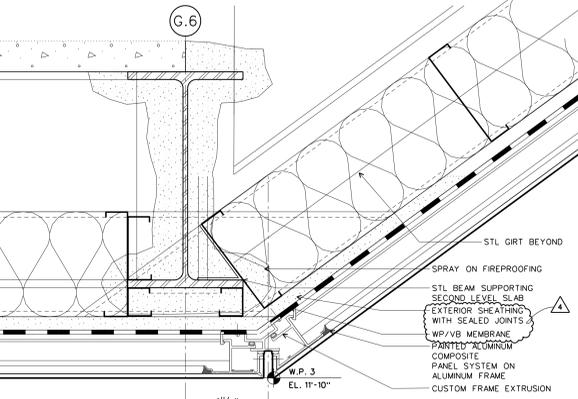

WALL SYSTEM C: SECTION DETAIL @ UNDERSIDE EAST
SCALE: 3" = 1'-0"
D-CWC05 10