

**WILLIAM J. CLINTON
PRESIDENTIAL
CENTER**

LITTLE ROCK, ARKANSAS

Architect

POLSHEK PARTNERSHIP LLP
320 West 13th Street
New York, New York 10014
212.807.7171

Coordinating Architects

POLK STANLEY YEARY ARCHITECTS Ltd
700 South Schiller Street
Little Rock, Arkansas 72201
501.378.0878

WITSELL EVANS RASCO
901 West Third Street
Little Rock, Arkansas 72201
501.374.5300

WOODS CARADINE ARCHITECTS
2200 South Main Street
Little Rock, Arkansas 72206
501.374.4960

Landscape Architects

HARGREAVES ASSOCIATES
118 Magazine Street
Cambridge, Massachusetts 02139
617.661.0070

LANDSCAPE ARCHITECTURE, Inc.
2300 Cottondale Lane Suite 202
Little Rock, Arkansas 72202
501.374.5610

Structural Engineer

LESLIE E. ROBERTSON ASSOC., RLLP
30 Broad Street, 47th Floor
New York, New York 10004
212.750.9000

MEP Engineers

FLACK + KURTZ, Inc.
475 Fifth Avenue
New York, New York 10017
212.532.9600

CROMWELL ARCHITECTS ENGINEERS


101 South Spring Street
Little Rock, Arkansas 72201
501.372.2900

Curtainwall Consultant

R. A. HEINTGES ARCHITECTS
126 Fifth Avenue, 9th Floor
New York, New York 10011
212.652-2968

Seal

▲ ASI #22	08/01/03
▲ ASI #20	08/06/03
▲ ASI #19	05/07/03
▲ Addendum #2	11/15/02
▲ 100% Construction Documents	09/27/02
▲ 90% Progress Printing	08/30/02
▲ 100% Struct./ CD Progress	07/01/02
▲ 100% Design Development	03/01/02
Issue	Date

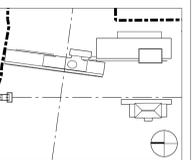

Job No. 9908

Scale 1-1/2" = 1'-0"

Date September 27, 2002


Title

**WALL SYSTEMS D
AND E
DETAIL SECTIONS**


Sheet No.

A365


FOR OFFICIAL USE ONLY

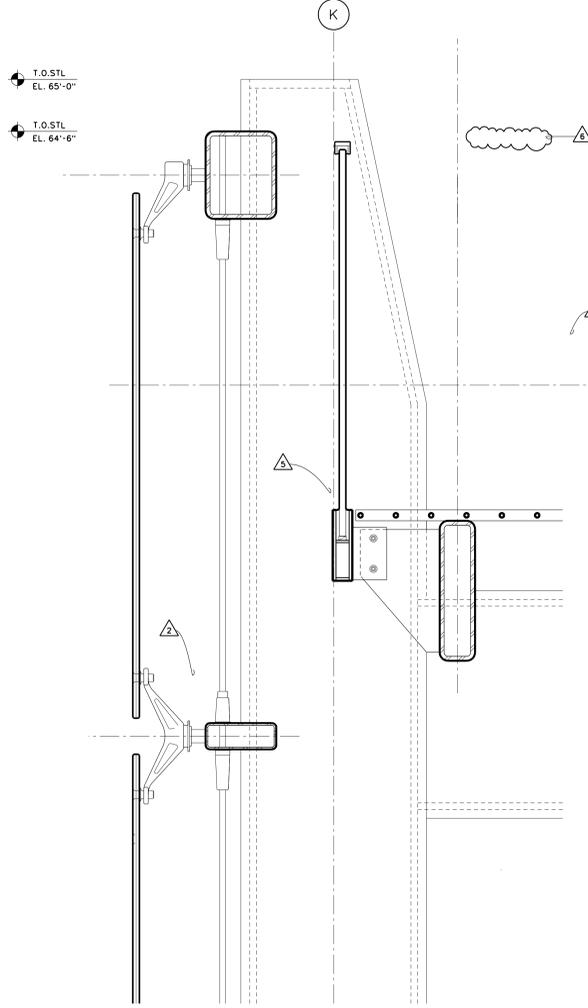


WALL SYSTEM E: DETAIL SECTION AT UPPER GRATING 22
SCALE: 1-1/2" = 1'-0" D-CWDE01

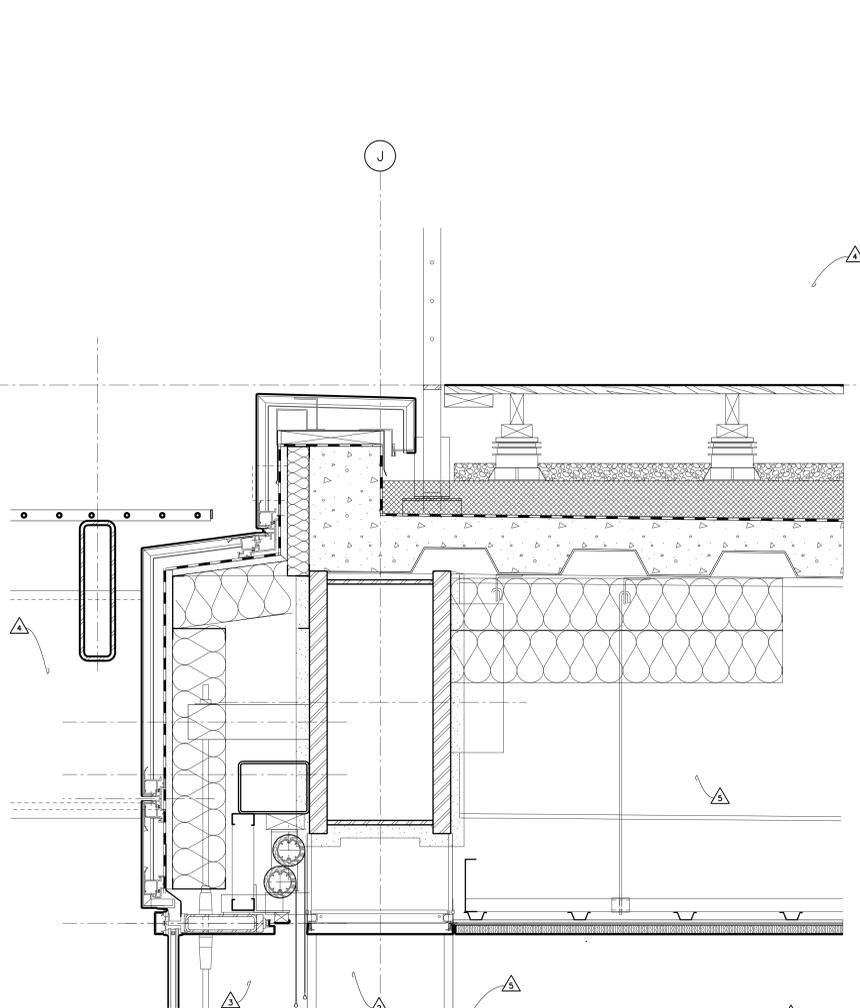


WALL SYSTEM D: DETAIL SECTION AT MUSEUM WEST HEAD 21
SCALE: 1-1/2" = 1'-0" D-CWDE01

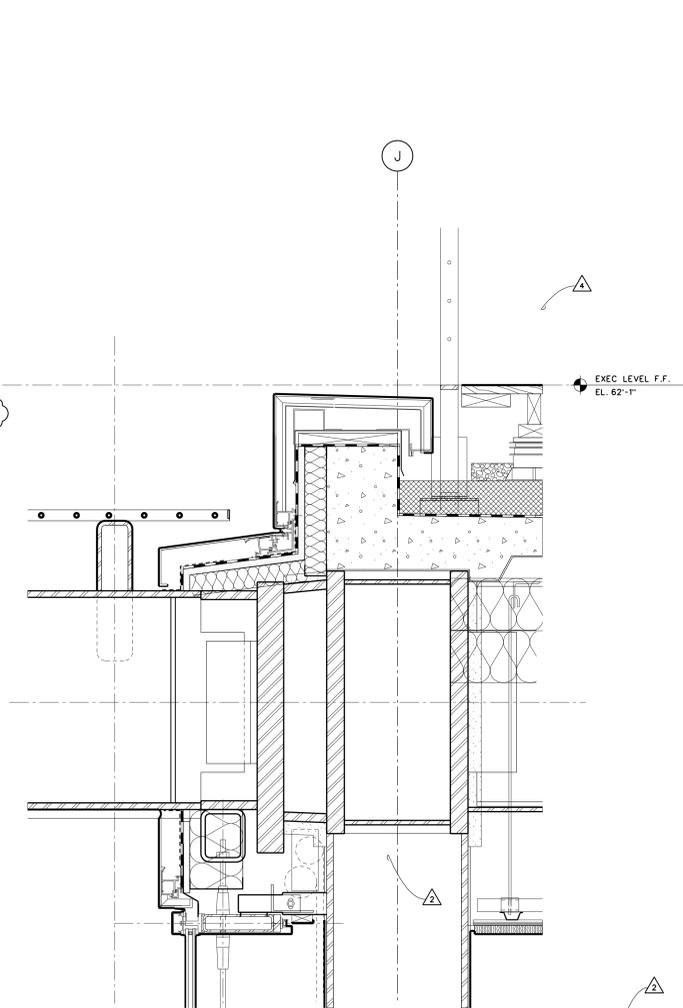


WALL SYSTEM D: SECTION AT WEST HEAD @ 30' MODULE 20
SCALE: 1-1/2" = 1'-0" D-CWDE01

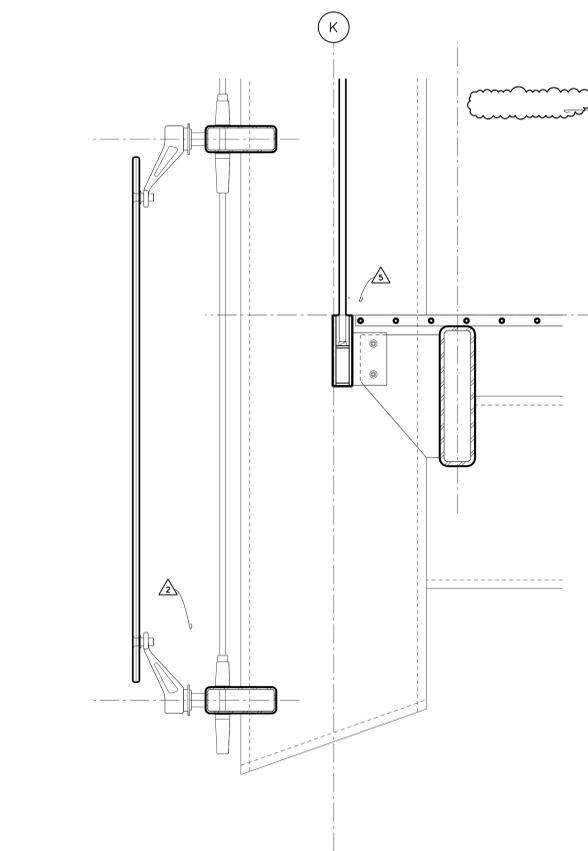

WALL SYSTEM E: DETAIL SECTION AT LOWER GRATING 12
SCALE: 1-1/2" = 1'-0" D-CWDE01

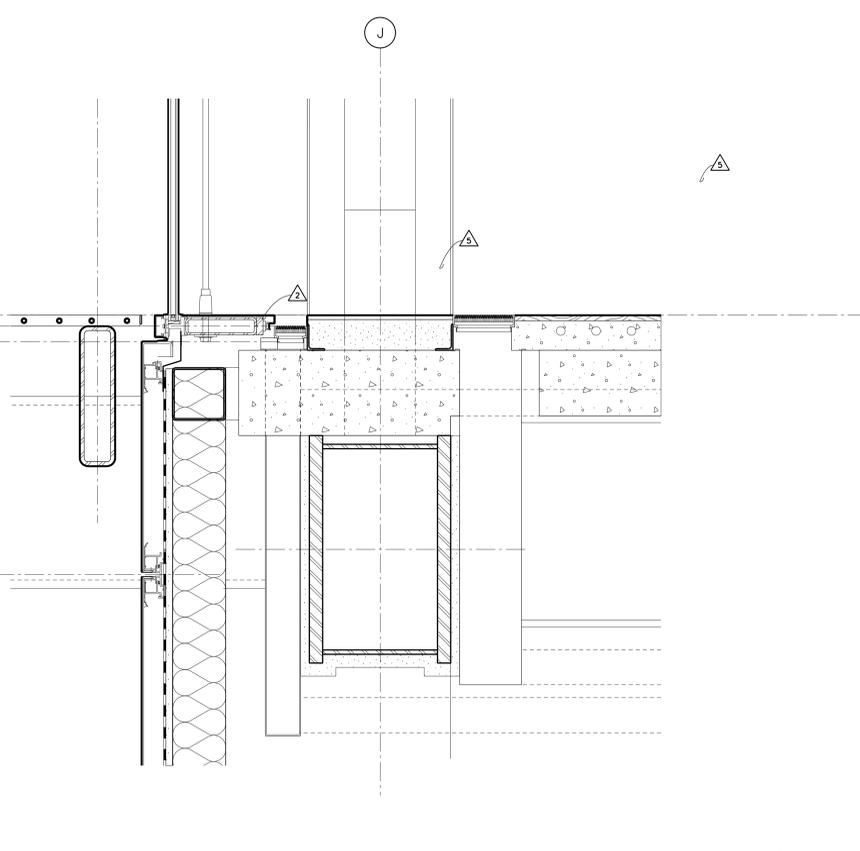

WALL SYSTEM D: DETAIL SECTION AT WEST SILL 11
SCALE: 1-1/2" = 1'-0" D-CWDE01

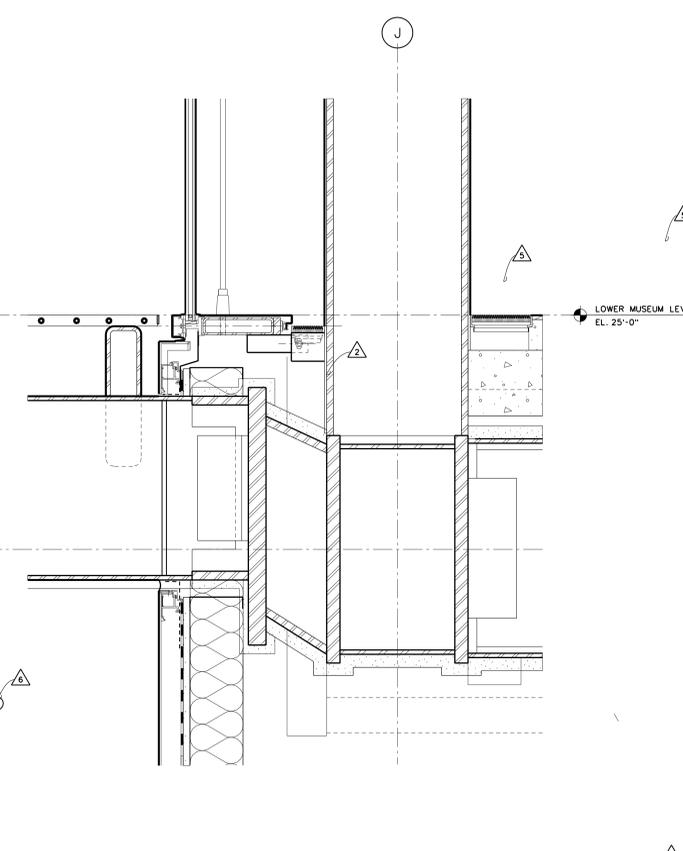

WALL SYSTEM D: SECTION AT WEST SILL @ 30' MODULE 10
SCALE: 1-1/2" = 1'-0" D-CWDE01