

**WILLIAM J. CLINTON  
PRESIDENTIAL  
CENTER**

LITTLE ROCK, ARKANSAS

Architect

**POLSHEK PARTNERSHIP LLP**  
320 West 13th Street  
New York, New York 10014  
212.807.7171

Coordinating Architects

**POLK STANLEY YEARY ARCHITECTS Ltd**  
700 South Schiller Street  
Little Rock, Arkansas 72201  
501.378.0878

**WITSELL EVANS RASCO**  
901 West Third Street  
Little Rock, Arkansas 72201  
501.374.5300

**WOODS CARADINE ARCHITECTS**  
2200 South Main Street  
Little Rock, Arkansas 72206  
501.374.4060

Landscape Architects

**HARGREAVES ASSOCIATES**  
118 Magazine Street  
Cambridge, Massachusetts 02139  
617.661.0070

**LANDSCAPE ARCHITECTURE, Inc.**  
2300 Cottondale Lane Suite 202  
Little Rock, Arkansas 72202  
501.374.5810

Structural Engineer

**LESLIE E. ROBERTSON ASSOC., RLLP**  
30 Broad Street, 47th Floor  
New York, New York 10004  
212.750.9000

MEP Engineers

**FLACK + KURTZ Inc.**  
475 Fifth Avenue  
New York, New York 10017  
212.532.9600


**CROMWELL ARCHITECTS ENGINEERS**  
101 South Spring Street  
Little Rock, Arkansas 72201  
501.372.2900

Curtainwall Consultant

**R. A. HEINTGES ARCHITECTS**  
126 Fifth Avenue, 9th Floor  
New York, New York 10011  
212.652.2968

Seal

ASI #22	08/01/03
Addendum #2	11/15/02
100% Construction Documents	09/27/02
90% Progress Printing	08/30/02
100% Struct./CD Progress	07/01/02
100% Design Development	03/01/02
Issue	Date

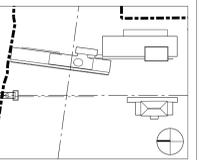


Job No.	9908
Scale	1-1/2" = 1'-0"
Date	September 27, 2002
Title	

**WALL SYSTEMS D  
SECTION DETAILS**

Sheet No.

**A366**

**FOR OFFICIAL USE ONLY**

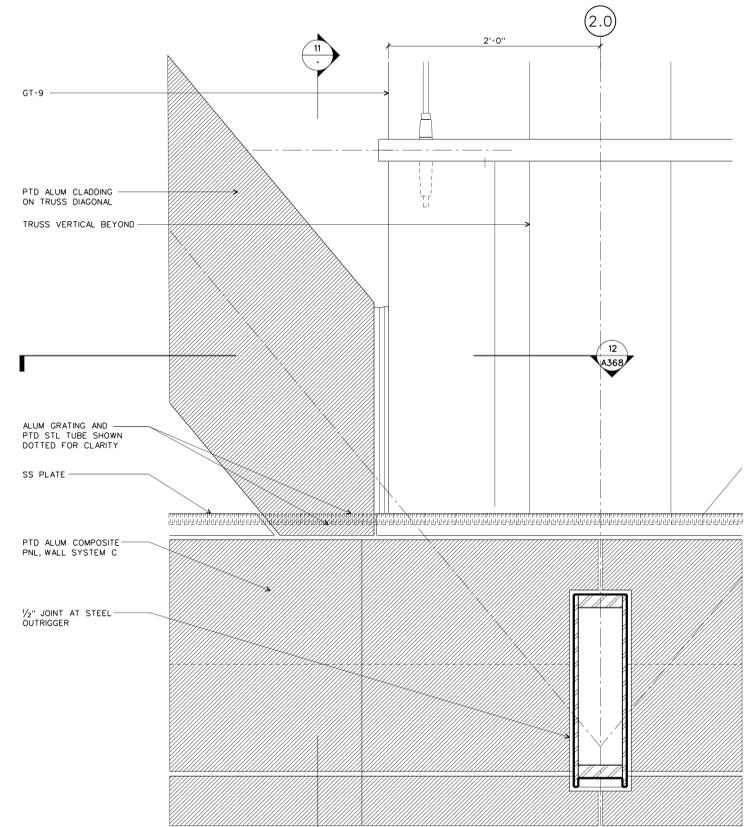


**WALL SYSTEM D: ELEVATION OF SILL AT TRUSS**

SCALE: 1-1/2" = 1'-0"

D-CWD01

20

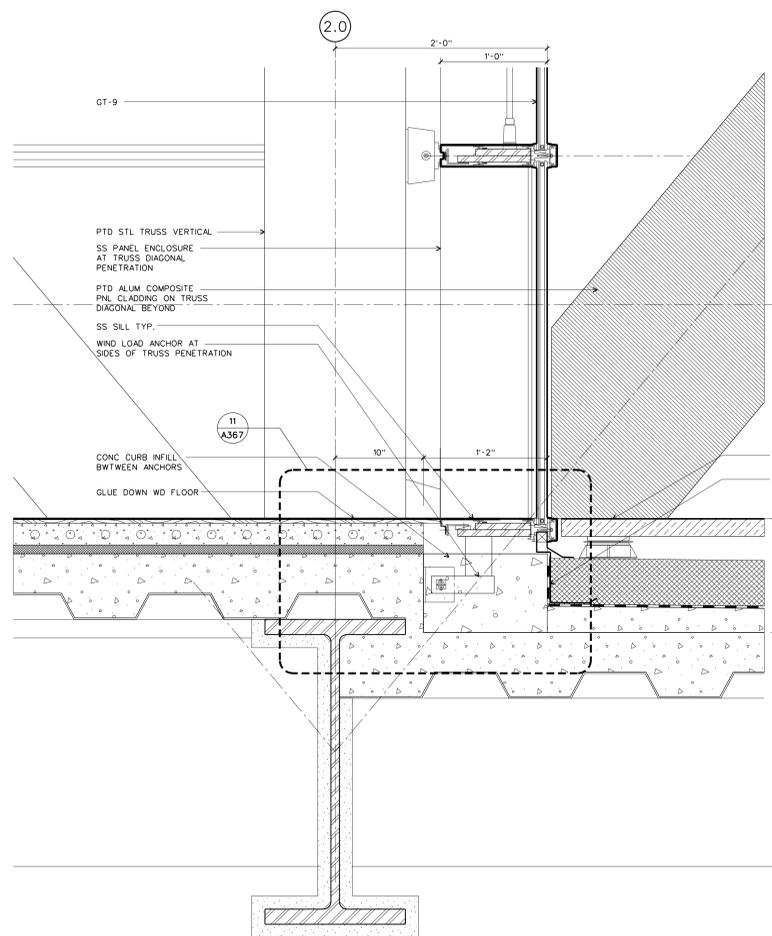


**WALL SYSTEM D: SECTION OF SILL AT NORTH WALL**

SCALE: 1-1/2" = 1'-0"

D-CWD01

12

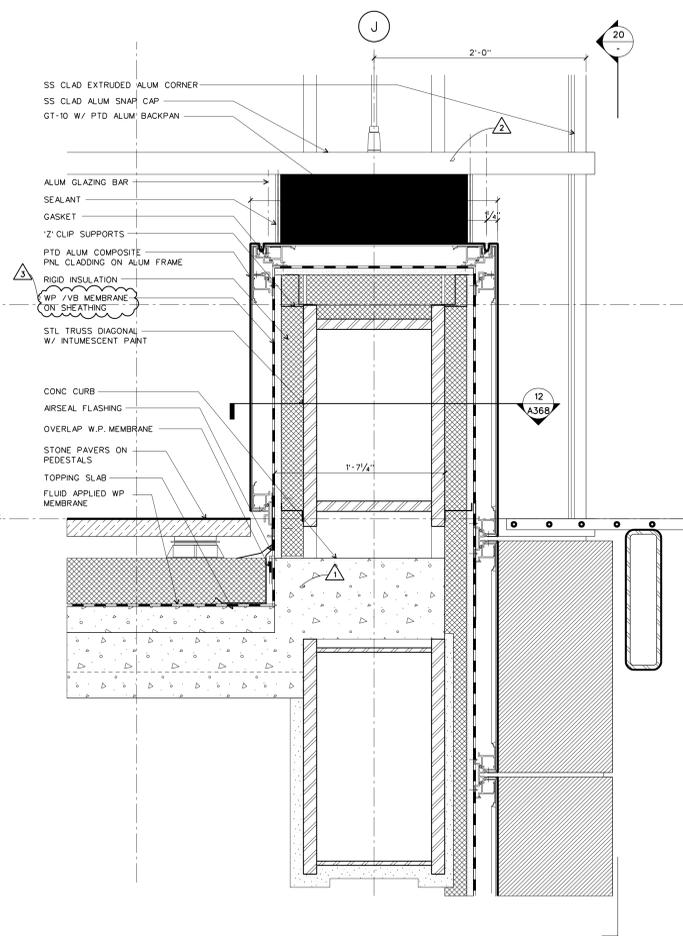


**WALL SYSTEM D: SECTION AT TRUSS DIAGONAL**

SCALE: 1-1/2" = 1'-0"

D-CWD01

11

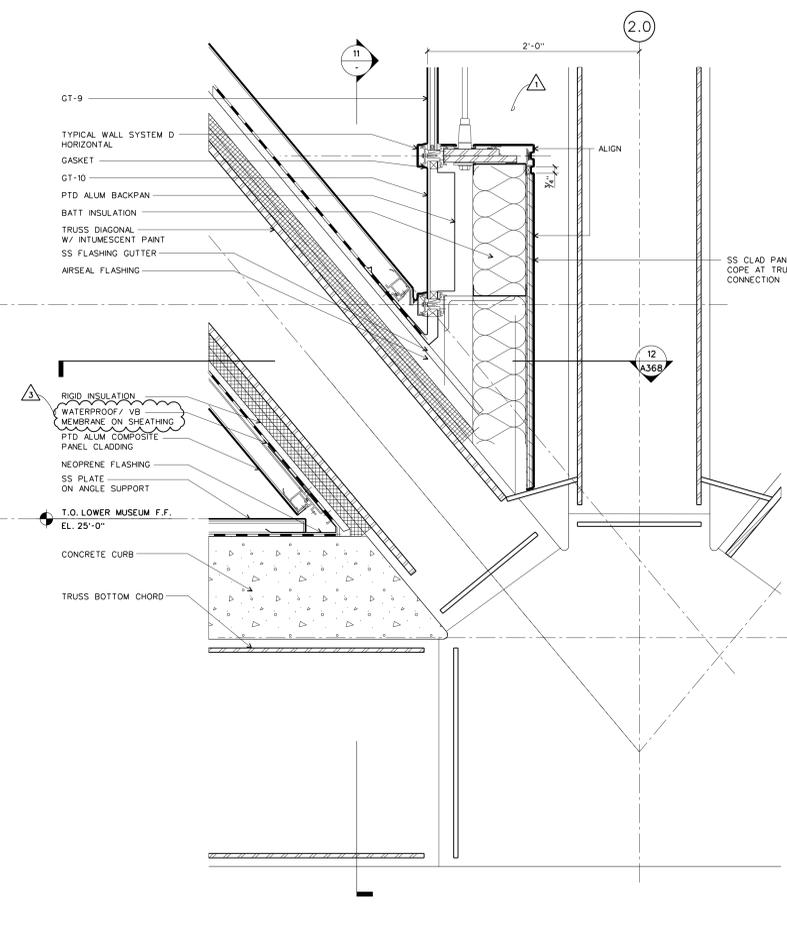

**WALL SYSTEM D: SECTION OF SILL AT TRUSS**

SCALE: 1-1/2" = 1'-0"

D-CWD01

10