


Seal

ASI #22	08/01/03
ASI #20	06/06/03
Addendum #2	11/15/02
100% Construction Documents	09/27/02
90% Progress Printing	08/30/02
100% Struct./CD Progress	07/01/02
100% Design Development	03/01/02
Issue	Date

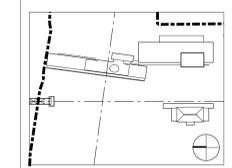

Job No. 9908

Scale 3" = 1'-0"

Date September 27, 2002


Title

**WALL SYSTEMS D
SECTION DETAILS**


Sheet No.

A367


FOR OFFICIAL USE ONLY

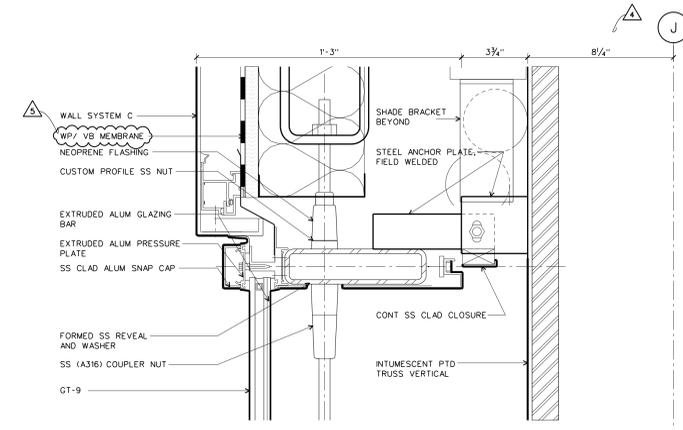


WALL SYSTEM D: DETAIL SECTION AT HEAD
SCALE: 3" = 1'-0" D-CWDE02 40

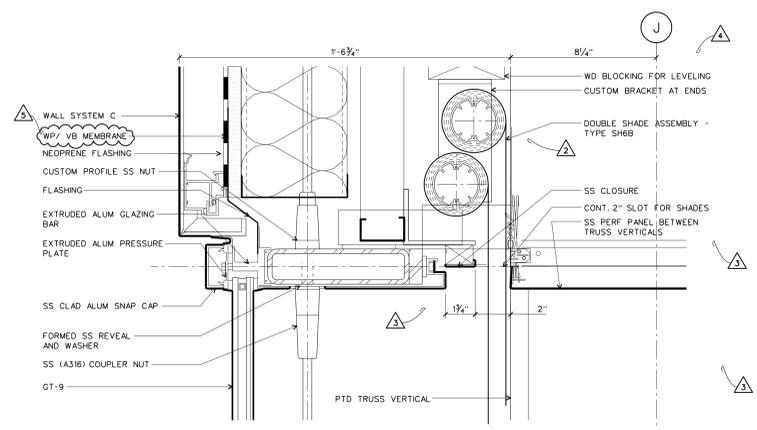


WALL SYSTEM D: SECTION AT HEAD AT 30' MODULE
SCALE: 3" = 1'-0" D-CWDE02 41

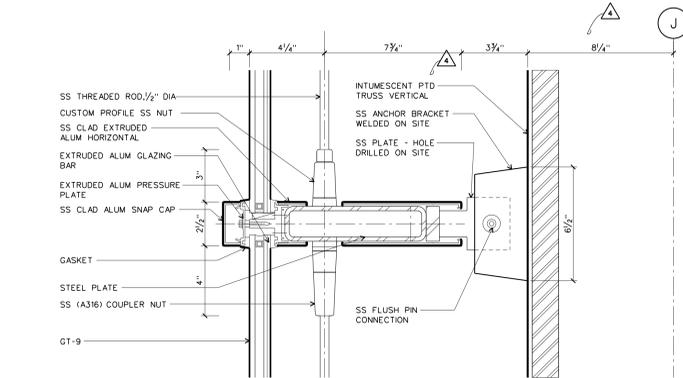


WALL SYSTEM D: DETAIL SECTION AT ANCHOR
SCALE: 3" = 1'-0" D-CWDE02 30

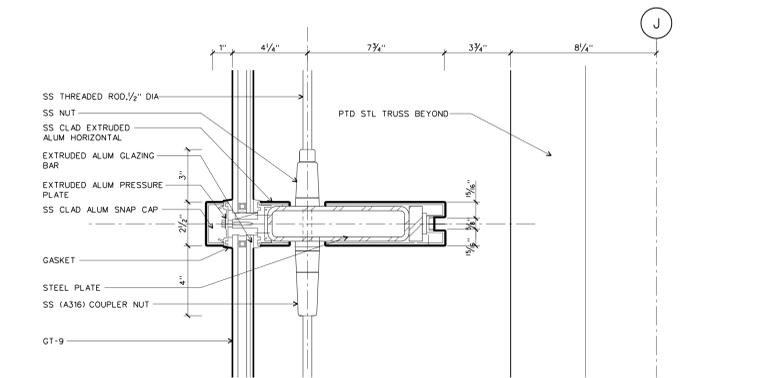


WALL SYSTEM D: SECTION AT TYPICAL HORIZONTAL
SCALE: 3" = 1'-0" D-CWDE02 31

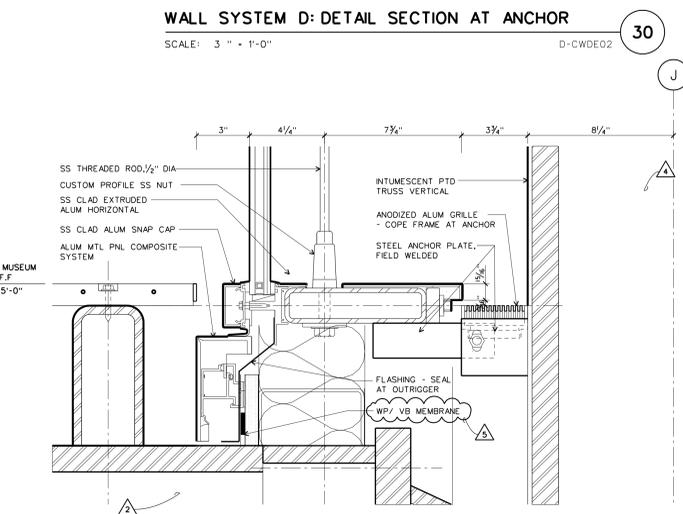


WALL SYSTEM D: DETAIL SECTION AT SILL
SCALE: 3" = 1'-0" D-CWDE02 20

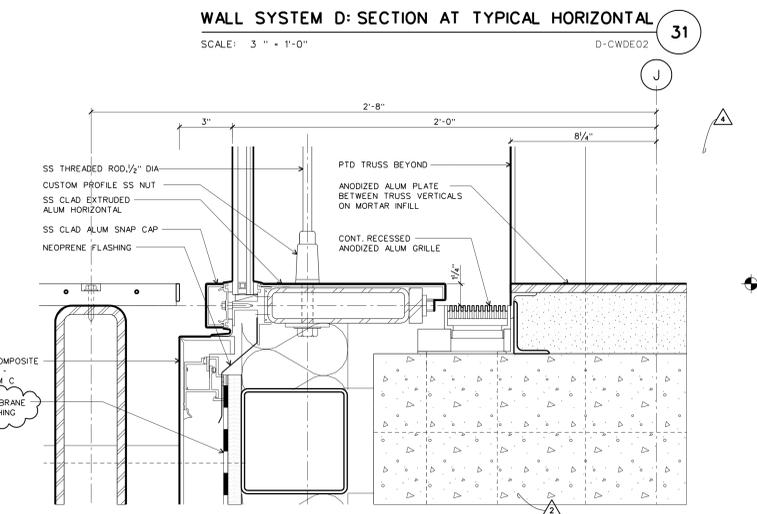


WALL SYSTEM D: SECTION AT SILL AT 30' MODULE
SCALE: 3" = 1'-0" D-CWDE02 21

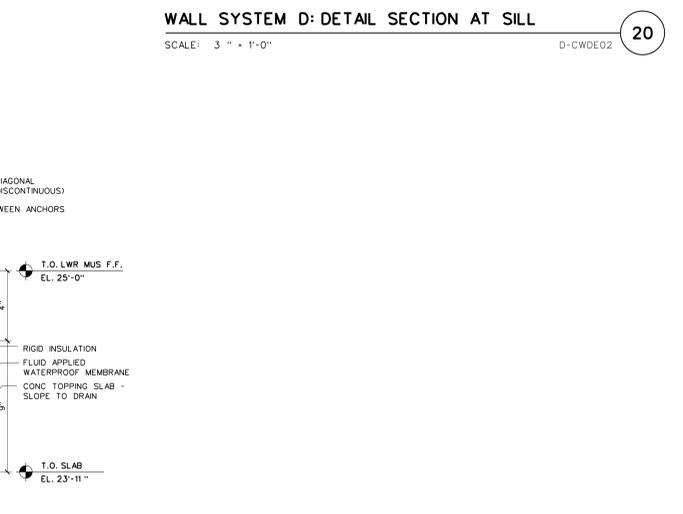


WALL SYSTEM D: SECTION AT SILL NORTH END
SCALE: 3" = 1'-0" D-CWDE02 11

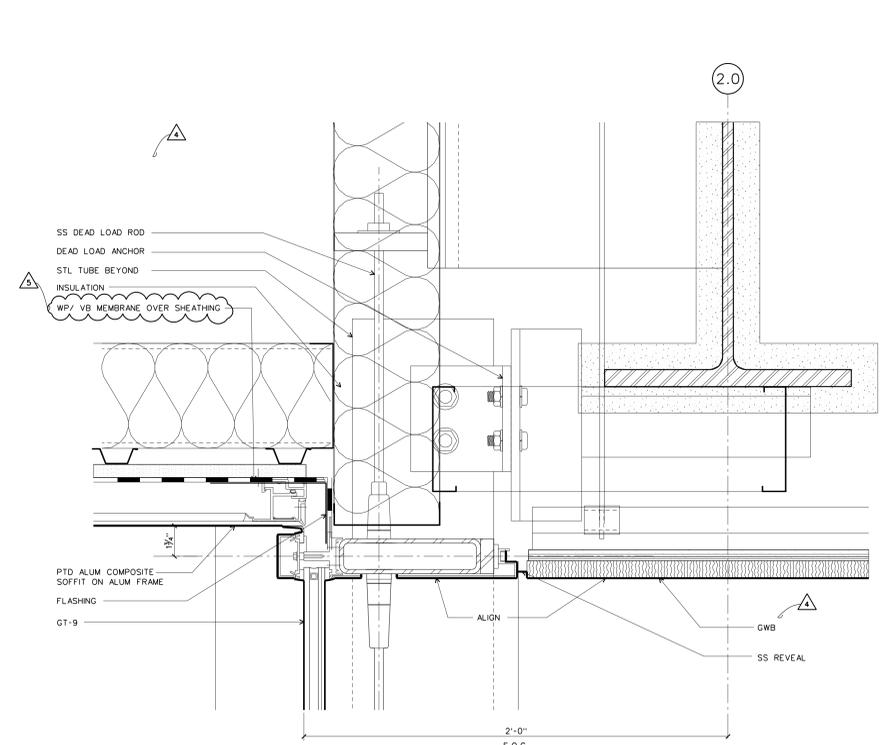

WALL SYSTEM D: SECTION AT NORTH END HEAD
SCALE: 3" = 1'-0" D-CWDE02 32

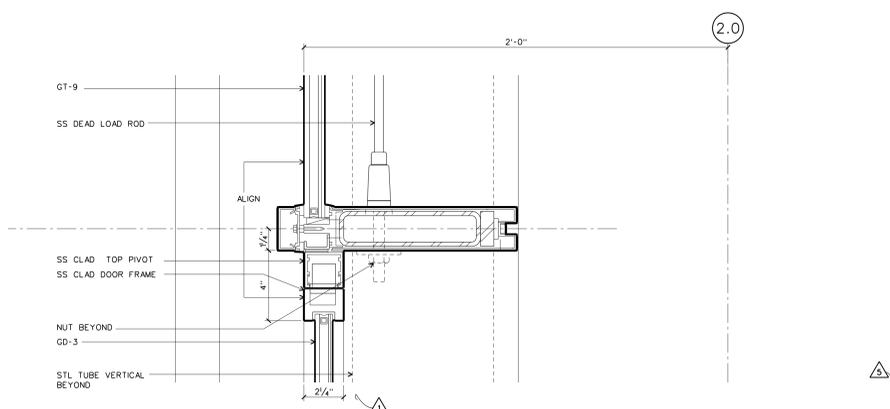

WALL SYSTEM D: SECTION AT NORTH END DOOR
SCALE: 3" = 1'-0" D-CWDE02 22

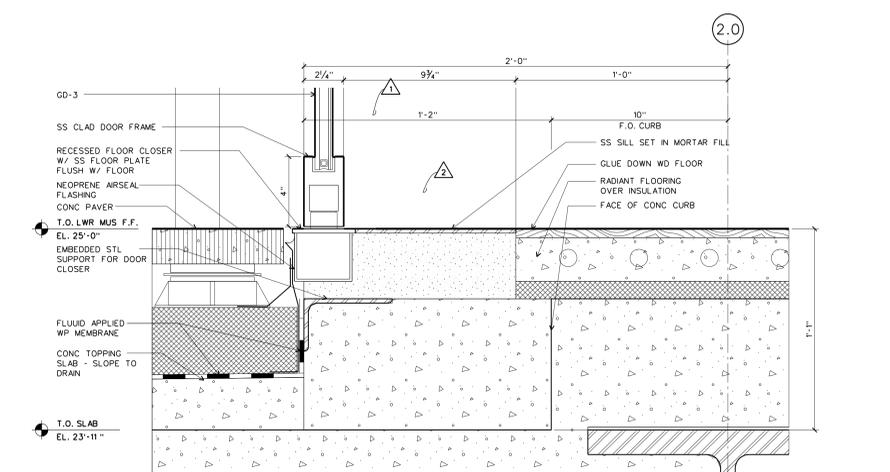

WALL SYSTEM D: SECTION AT NORTH END DOOR SILL
SCALE: 3" = 1'-0" D-CWDE02 12