


Seal

100% Construction Documents	09/27/02
90% Progress Printing	08/30/02
100% Struct./ CD Progress	07/01/02
100% Design Development	03/01/02
Issue	Date

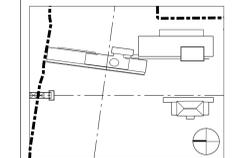

Job No. 9908

Scale AS NOTED

Date September 27, 2002


Title

**WALL SYSTEM E
PLAN AND SECTION
DETAILS**


Sheet No.

A369


FOR OFFICIAL USE ONLY

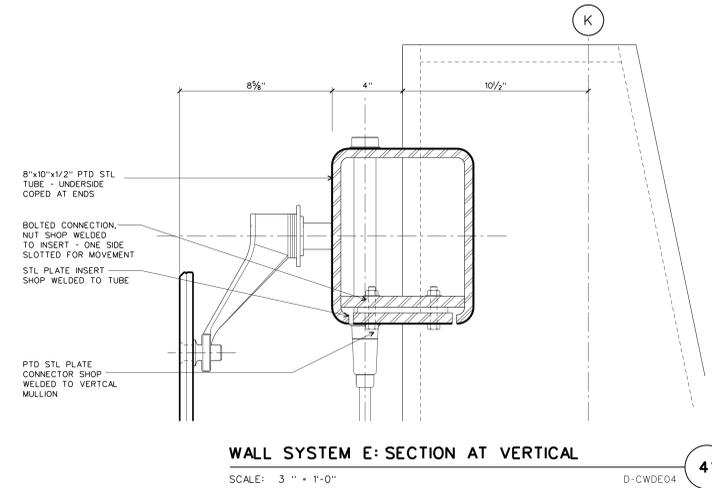


WALL SYSTEM E: SECTION AT VERTICAL
SCALE: 3" = 1'-0"
D-CWDE04

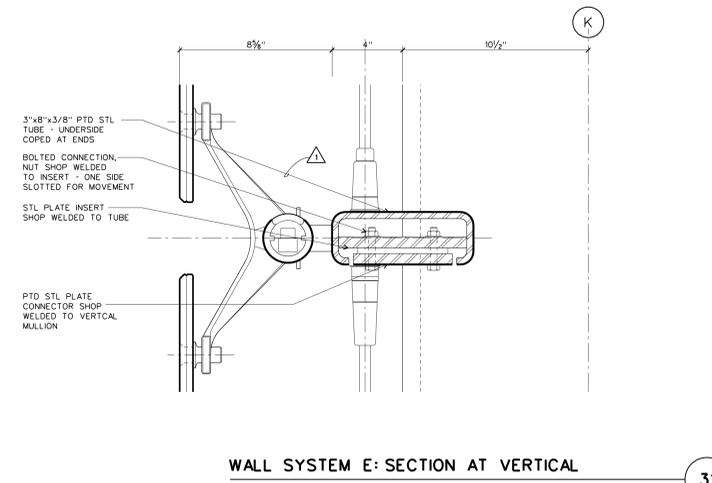


WALL SYSTEM E: SECTION AT VERTICAL
SCALE: 3" = 1'-0"
D-CWDE04

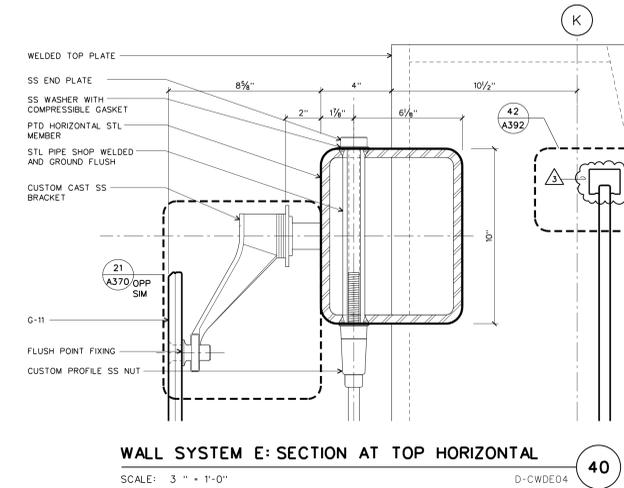


WALL SYSTEM E: SECTION AT TOP HORIZONTAL
SCALE: 3" = 1'-0"
D-CWDE04

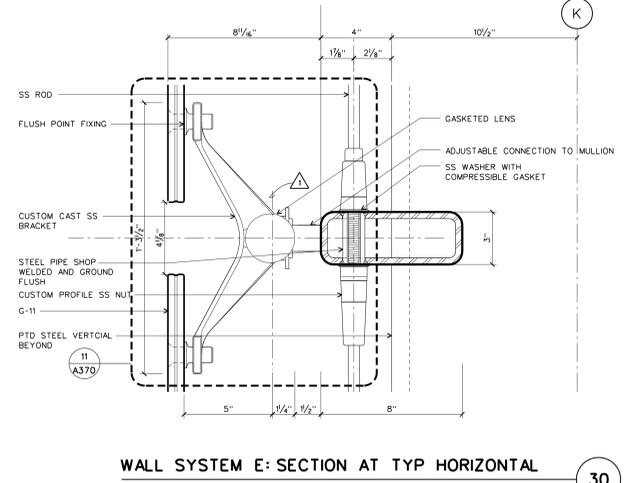


WALL SYSTEM E: SECTION AT TYP HORIZONTAL
SCALE: 3" = 1'-0"
D-CWDE04

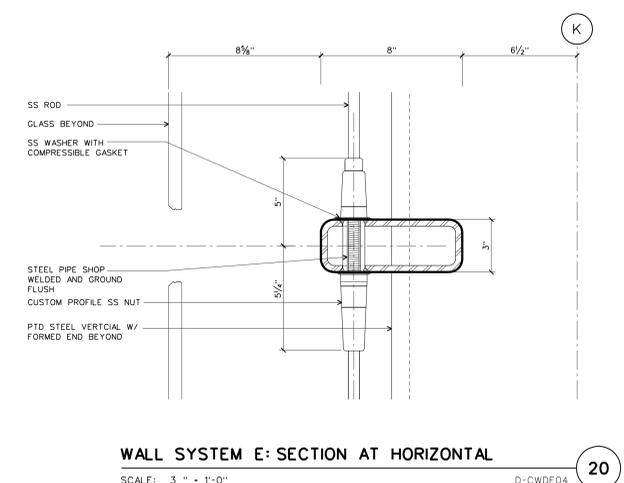


WALL SYSTEM E: SECTION AT HORIZONTAL
SCALE: 3" = 1'-0"
D-CWDE04

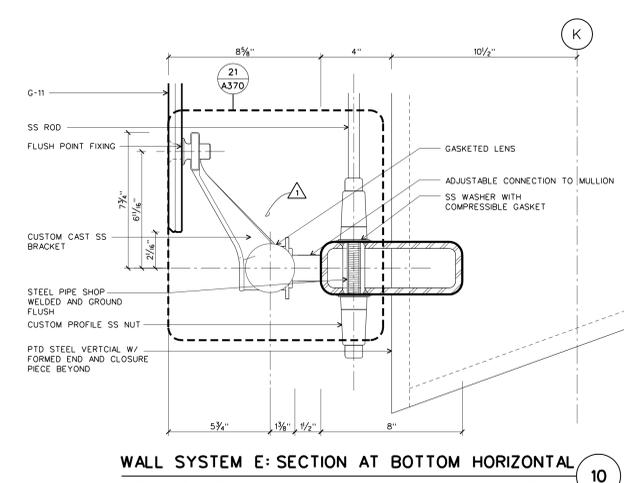

WALL SYSTEM E: SECTION AT BOTTOM HORIZONTAL
SCALE: 3" = 1'-0"
D-CWDE04

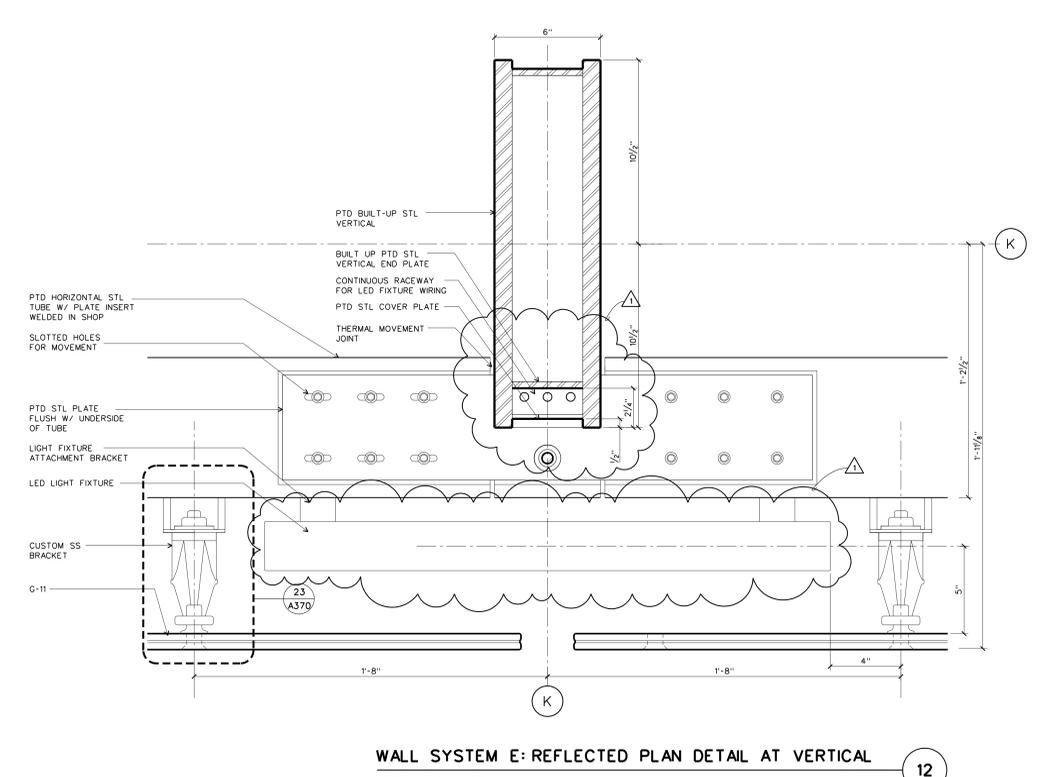

WALL SYSTEM E: REFLECTED PLAN DETAIL AT VERTICAL
SCALE: 3" = 1'-0"
D-CWDE04

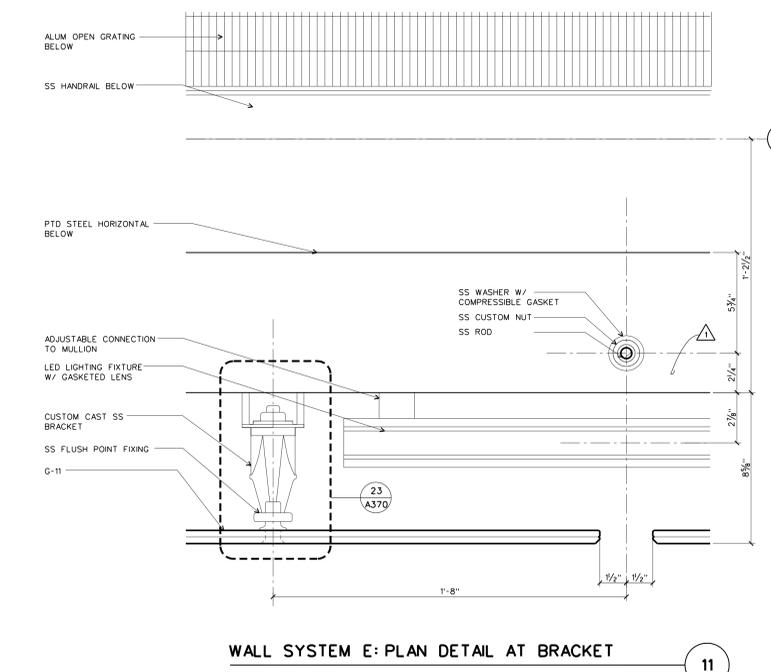

WALL SYSTEM E: PLAN DETAIL AT BRACKET
SCALE: 3" = 1'-0"
D-CWDE04

D-CWDE04