



100% Construction Documents	09/27/02
90% Progress Printing	08/30/02
100% Struct./CD Progress	07/01/02
100% Design Development	03/01/02
Issue	Date


Job No.	9908
Scale	AS NOTED
Date	September 27, 2002
Title	WALL SYSTEM E PLAN AND SECTION DETAILS
Sheet No.	A370

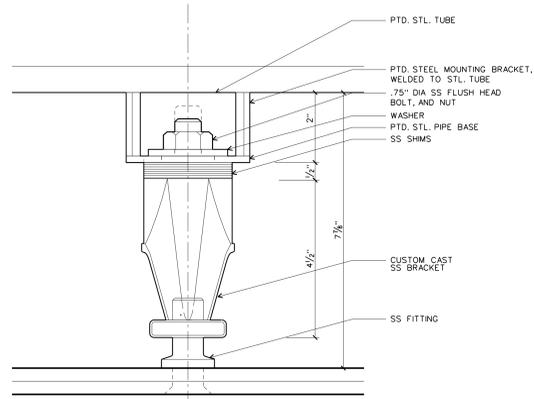


WALL SYSTEM E: BRACKET, PLAN DETAIL
SCALE: 6" = 1'-0"
D-CWDE05 **23**

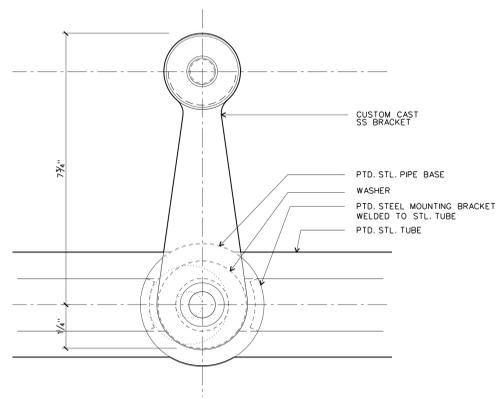


WALL SYSTEM E: BRACKET, FRONT ELEVATION
SCALE: 6" = 1'-0"
D-CWDE05 **22**

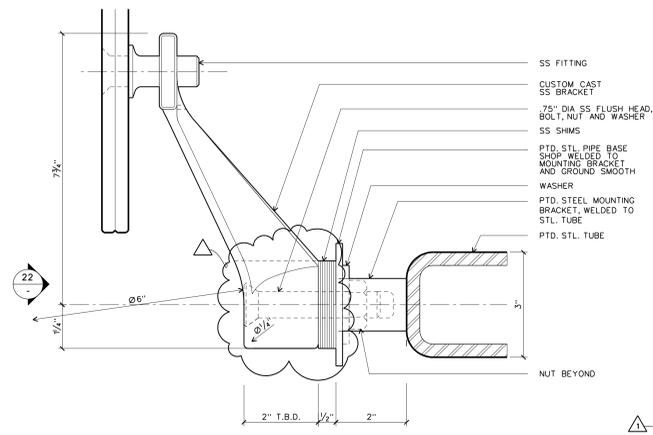


WALL SYSTEM E: BRACKET, SIDE ELEVATION
SCALE: 6" = 1'-0"
D-CWDE05 **21**

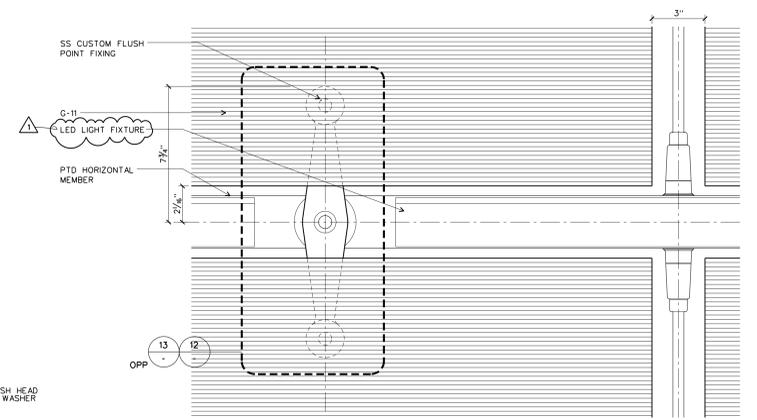


WALL SYSTEM E: ELEVATION DETAIL
SCALE: 3" = 1'-0"
D-CWDE05 **20**

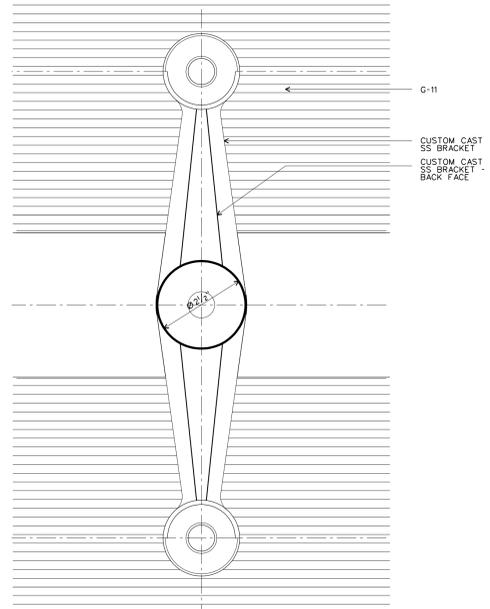


WALL SYSTEM E: BRACKET, BACK ELEVATION
SCALE: 6" = 1'-0"
D-CWDE05 **13**

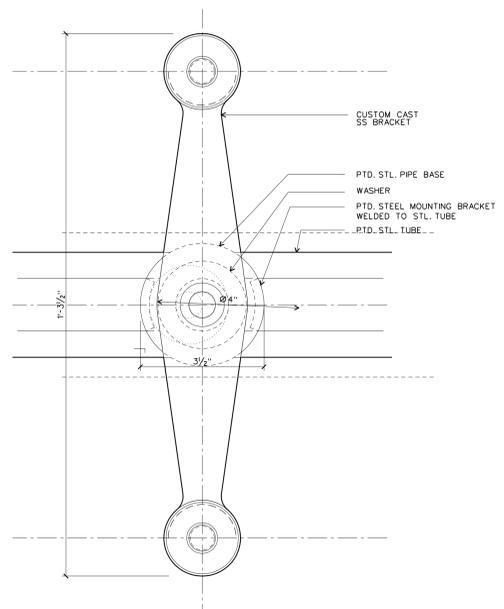

WALL SYSTEM E: BRACKET FRONT ELEVATION
SCALE: 6" = 1'-0"
D-CWDE05 **12**

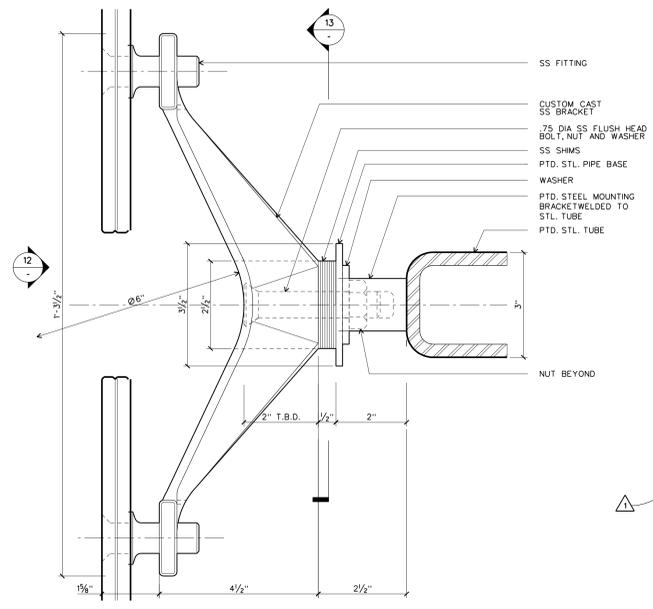

WALL SYSTEM E: BRACKET, SIDE ELEVATION
SCALE: 6" = 1'-0"
D-CWDE05 **11**

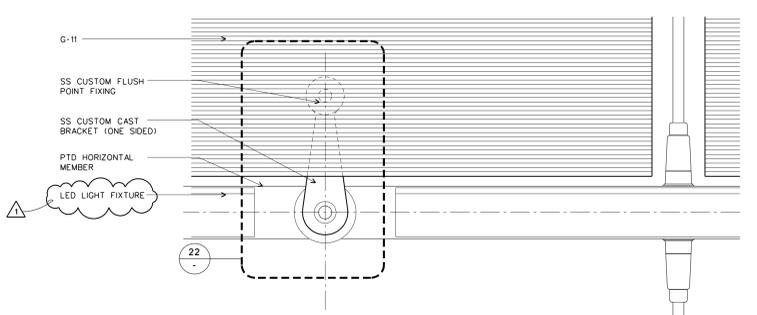

WALL SYSTEM E: ELEVATION DETAIL
SCALE: 3" = 1'-0"
D-CWDE05 **10**