




WALL SYSTEM F: POINT FASTENERS IN ELEVATION 43
SCALE: 3" = 1'-0" DETAILS/D-CWF01

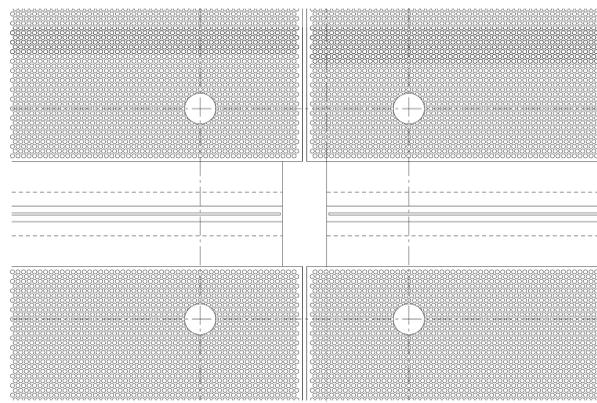


WALL SYSTEM F: POINT FASTENERS IN ELEVATION 42
SCALE: 3" = 1'-0" DETAILS/D-CWF01

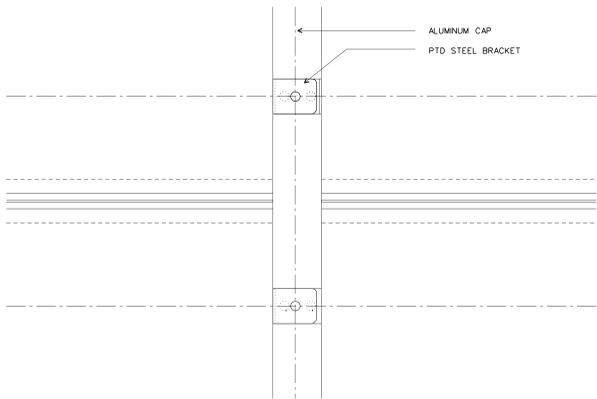


WALL SYSTEM F: BRACKETS AT MID. OF PANEL/ELEV. 33
SCALE: 3" = 1'-0" DETAILS/D-CWF01

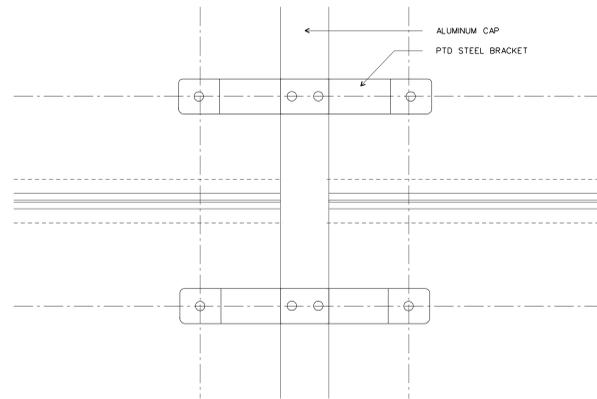


WALL SYSTEM F: BRACKETS IN ELEVATION 32
SCALE: 3" = 1'-0" DETAILS/D-CWF01

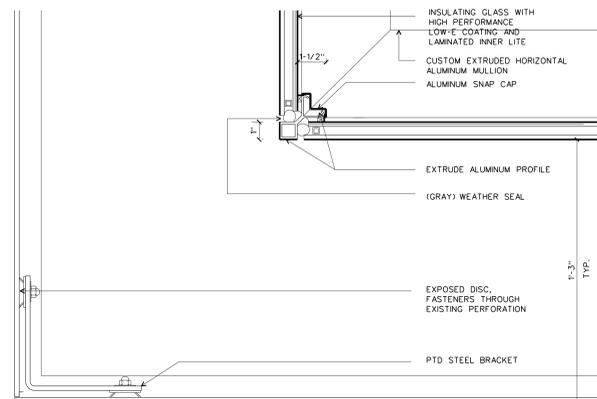


WALL SYSTEM F: CORNER DETAIL 23
SCALE: 3" = 1'-0" DETAILS/D-CWF01

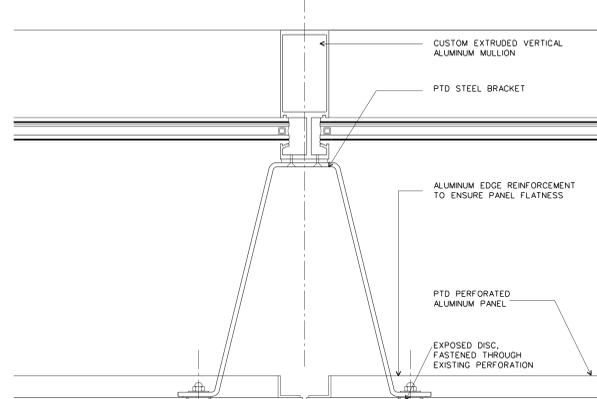


WALL SYSTEM F: VERTICAL MULLION W. BRACKET 22
SCALE: 3" = 1'-0" DETAILS/D-CWF01

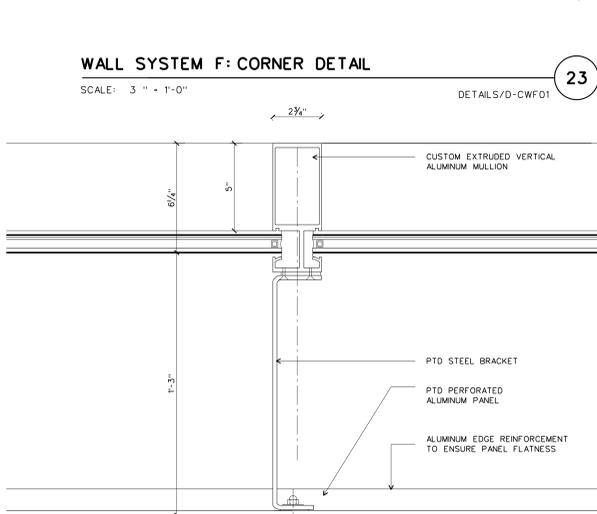


WALL SYSTEM F: TYP. BRACKET AT MIDDLE OF PANEL 13
SCALE: 3" = 1'-0" DETAILS/D-CWF01

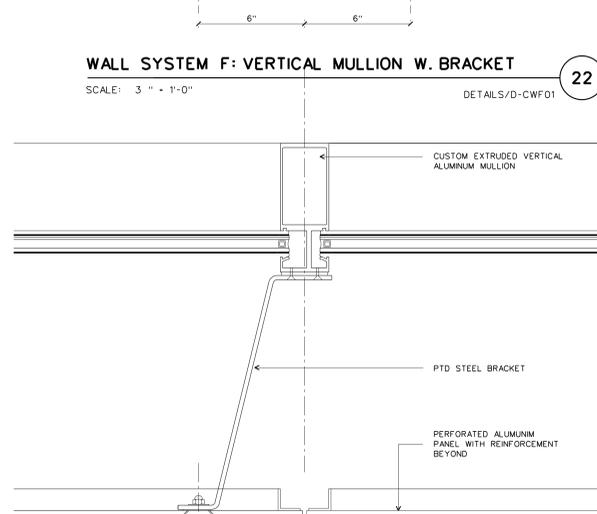


WALL SYSTEM F: TYP. BRACKET AT OPENINGS 12
SCALE: 3" = 1'-0" DETAILS/D-CWF01

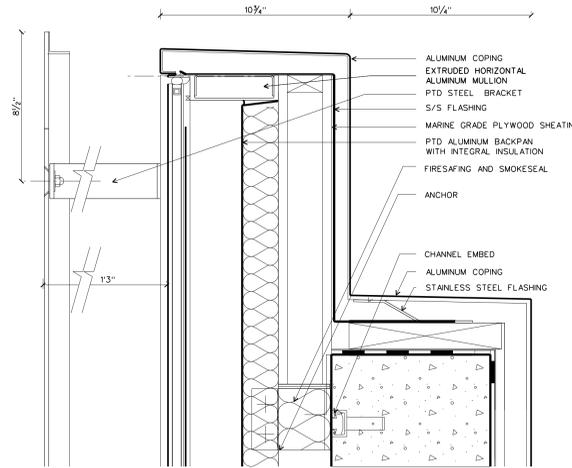


WALL SYSTEM F: DETAIL AT ROOF 41
SCALE: 3" = 1'-0" DETAILS/S/D-CWF01

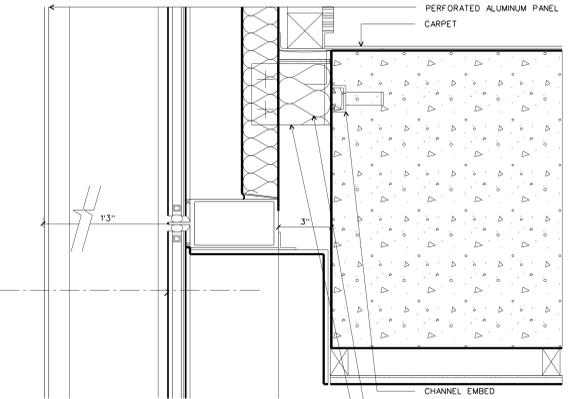


WALL SYSTEM F: DETAIL AT THIRD FLOOR SLAB 31
SCALE: 3" = 1'-0" DETAILS/S/D-CWF01

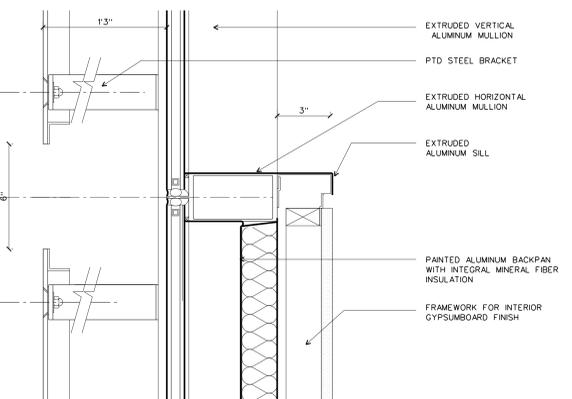


WALL SYSTEM F: DETAIL AT REGULAR MULLION 21
SCALE: 3" = 1'-0" DETAILS/D-CWF01

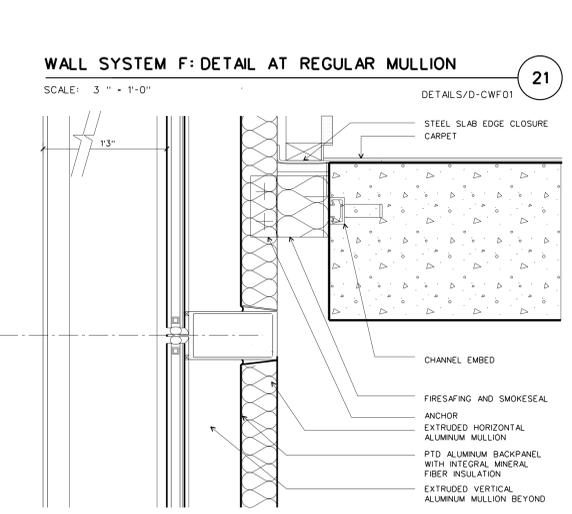


WALL SYSTEM F: DETAIL AT SLAB SECOND FLOOR 11
SCALE: 3" = 1'-0" DETAILS/S/D-CWF01

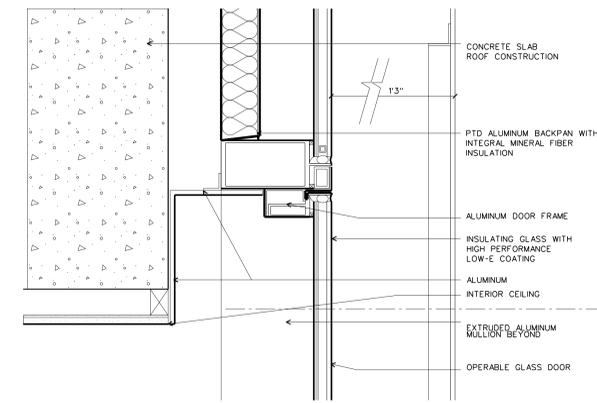


WALL SYSTEM F: DETAIL AT OPERABLE DOOR ABOVE 40
SCALE: 3" = 1'-0" DETAILS/D-CWF01

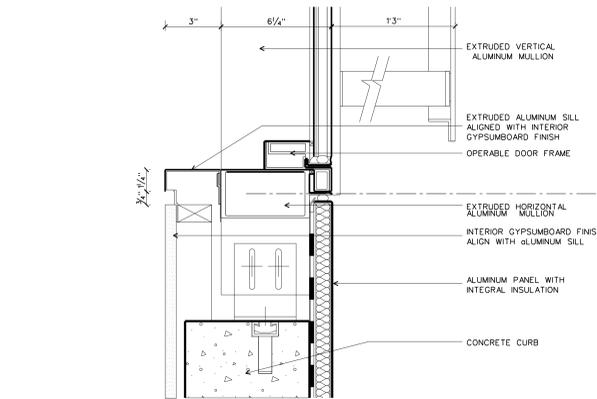

WALL SYSTEM F: DETAIL OPERABLE DOOR 30
SCALE: 3" = 1'-0" DETAILS/D-CWF01

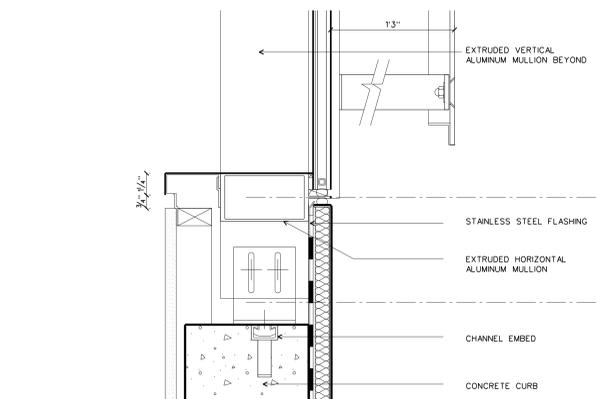

WALL SYSTEM F: DETAIL AT CONCRETE CURB EAST 20
SCALE: 3" = 1'-0" DETAILS/D-CWF01

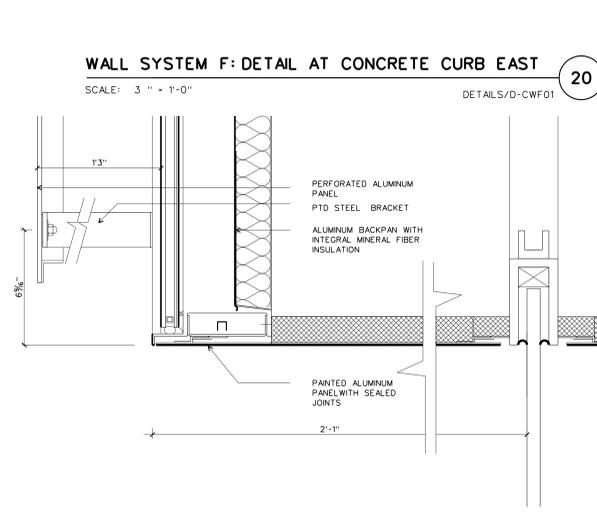

WALL SYSTEM F: CORNER DETAIL AT ENTRANCE 10
SCALE: 3" = 1'-0" DETAILS/D-CWF01

**WILLIAM J. CLINTON
PRESIDENTIAL
CENTER**

LITTLE ROCK, ARKANSAS

Architect
POLSHEK PARTNERSHIP LLP
320 West 13th Street
New York, New York 10014
212.807.7171

Coordinating Architects
POLK STANLEY YEARY ARCHITECTS Ltd
700 South Schiller Street
Little Rock, Arkansas 72201
501.378.0878

WITSELL EVANS RASCO
901 West Third Street
Little Rock, Arkansas 72201
501.374.5300

WOODS CARADINE ARCHITECTS
2200 South Main Street
Little Rock, Arkansas 72206
501.374.4060

Landscape Architects
HARGREAVES ASSOCIATES
118 Magazine Street
Cambridge, Massachusetts 02139
617.661.0070

LANDSCAPE ARCHITECTURE, Inc.
2300 Cottondale Lane Suite 202
Little Rock, Arkansas 72202
501.374.5810

Structural Engineer
LESLIE E. ROBERTSON ASSOC., RLLP
30 Broad Street, 47th Floor
New York, New York 10004
212.750.9000


MEP Engineers
FLACK + KURTZ Inc.
475 Fifth Avenue
New York, New York 10017
212.532.9600

CROMWELL ARCHITECTS ENGINEERS
101 South Spring Street
Little Rock, Arkansas 72201
501.372.2900

Curtainwall Consultant
R. A. HEINTGES ARCHITECTS
126 Fifth Avenue, 9th Floor
New York, New York 10011
212.652.2968

Seal

100% Construction Documents	09/27/02
90% Progress Printing	08/30/02
ASI #05	08/20/02
100% Struct./ CD Progress	07/01/02
Bridge Bldg. Substructure	06/14/02
100% Steel & Concrete CD	05/15/02
& Architectural CD Progress	
100% Design Development	03/01/02
Issue	Date

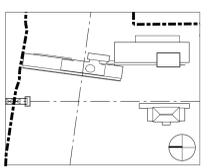

Job No. 9908

Scale 3" = 1'-0"

Date September 27, 2002

Title **WALL SYSTEM F
PLAN, SECTION
AND ELEVATION
DETAILS**

Sheet No.

A373

FOR OFFICIAL USE ONLY