


ASI #22	08/01/03
Addendum #2	11/15/02
100% Construction Documents	09/27/02
90% Progress Printing	09/30/02
100% Struct./CD Progress	07/01/02
Bridge Bldg. Substructure	06/14/02
100% Design Development	03/01/02
Issue	Date

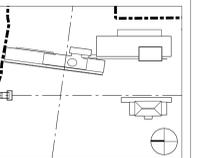

Job No. 9908

Scale 1-1/2" = 1'-0"


Date September 27, 2002

Title


**WALL SYSTEM G
DETAIL PLANS AND
SECTIONS**

Sheet No.


A375

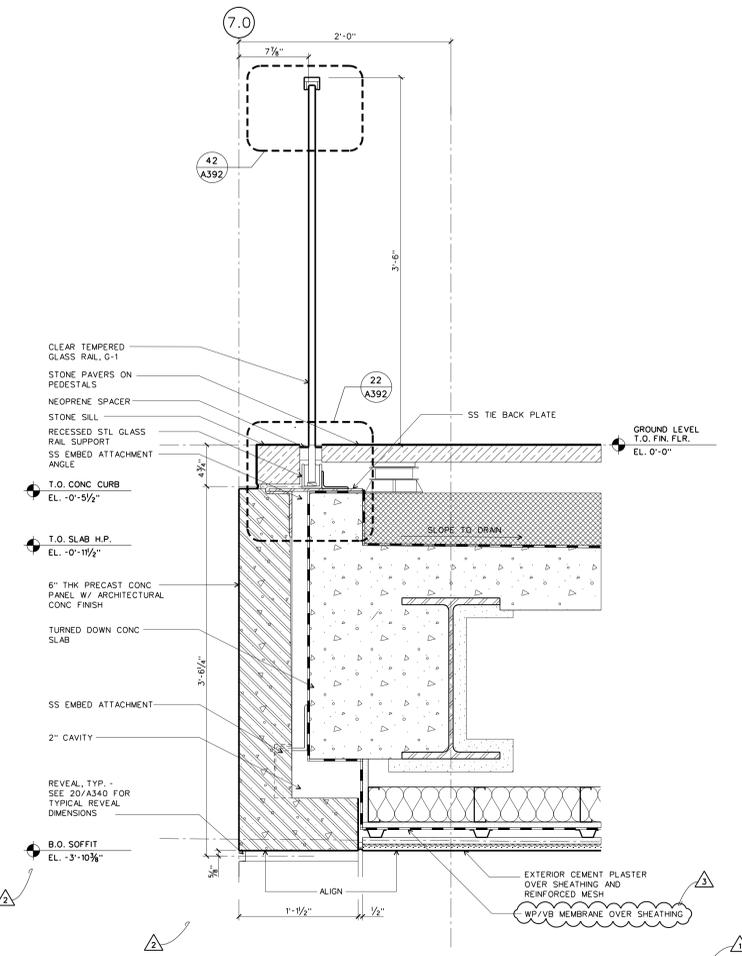


WALL SYSTEM G: DETAIL SECTION AT NORTH TERRACE
SCALE: 1-1/2" = 1'-0"
D-CWG02 22

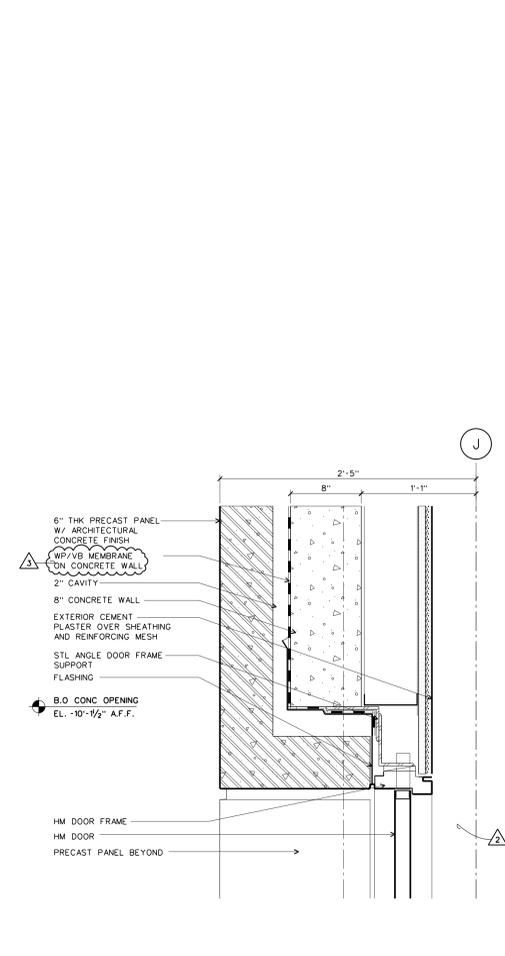


WALL SYSTEM G: DETAIL SECTION AT DOOR HEAD
SCALE: 1-1/2" = 1'-0"
D-CWG02 21

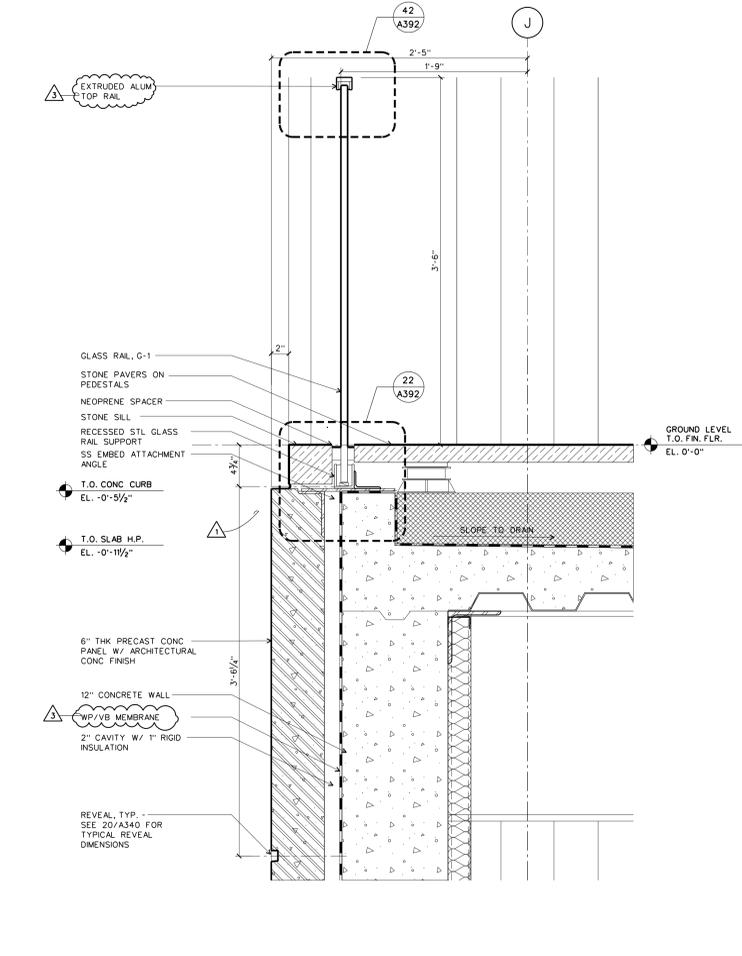


WALL SYSTEM G: DETAIL SECTION AT EAST TERRACE
SCALE: 1-1/2" = 1'-0"
D-CWG02 20

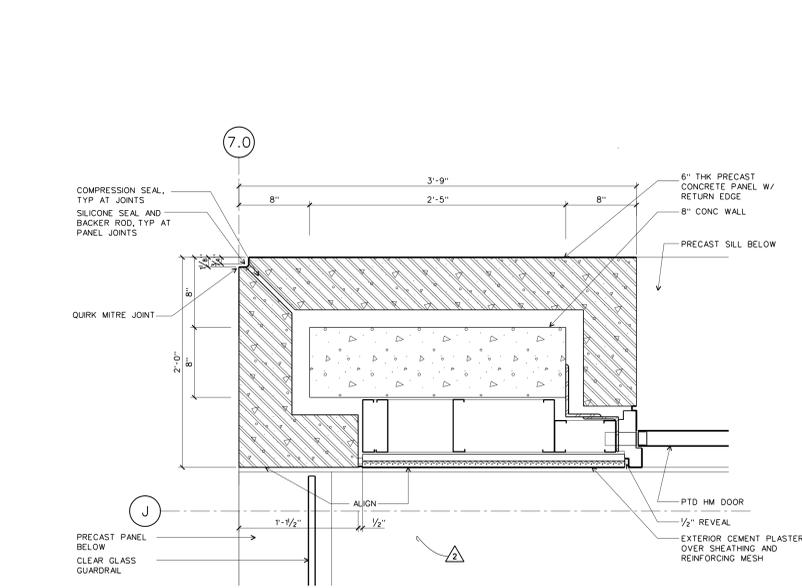

WALL SYSTEM G: PLAN DETAIL AT DOOR JAMB
SCALE: 1-1/2" = 1'-0"
D-CWG02 12

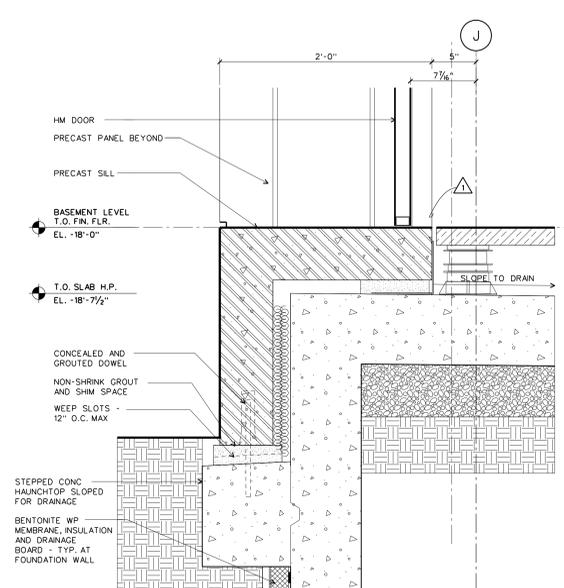

WALL SYSTEM G: DETAIL SECTION AT DOOR SILL
SCALE: 1-1/2" = 1'-0"
D-CWG02 11

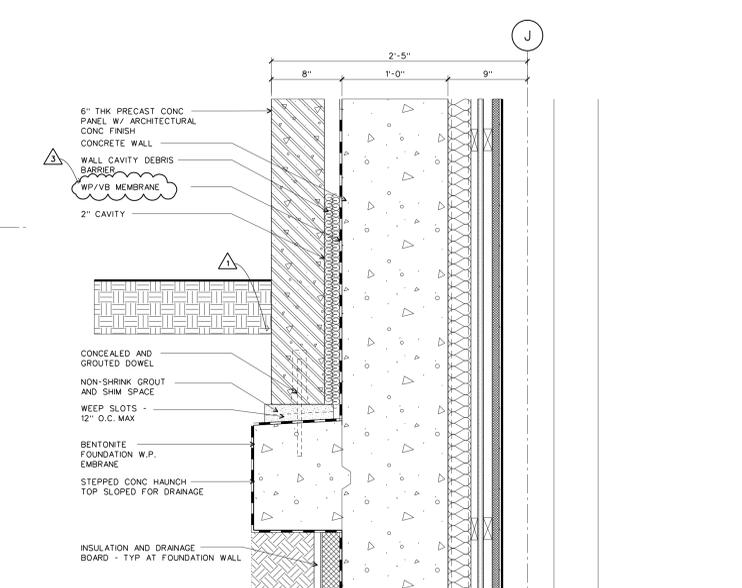

WALL SYSTEM G: DETAIL SECTION AT SILL
SCALE: 1-1/2" = 1'-0"
D-CWG02 10