


WALL SYSTEM H: PLAN DET. AT WALL SYSTEM C EAST

SCALE: 3" = 1'-0"

DETAILS/D-CWH02

43

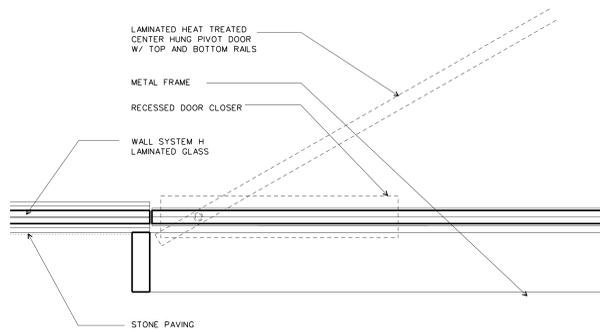


WALL SYSTEM H: PLAN DET. AT GLASS DOOR EAST

SCALE: 3" = 1'-0"

DETAILS/D-CWH02

42

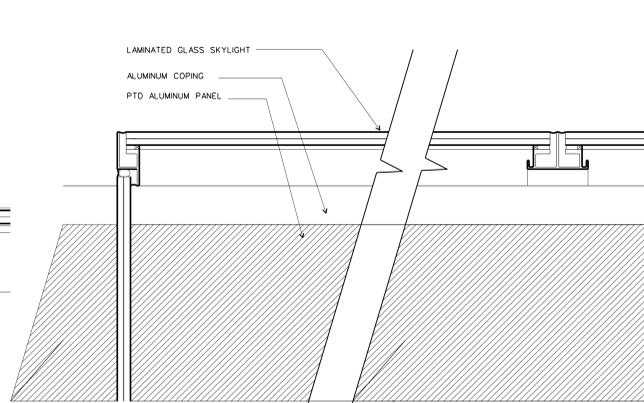


WALL SYSTEM H: DETAIL AT END OF SKYLIGHT

SCALE: 3" = 1'-0"

DETAILS/D-CWH02

41

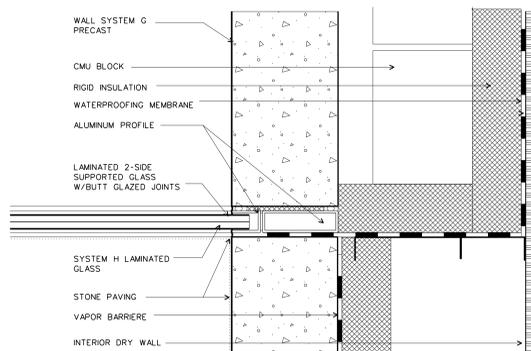


WALL SYSTEM H: PLAN DET. AT WALL SYSTEM G

SCALE: 3" = 1'-0"

DETAILS/D-CWH02

32

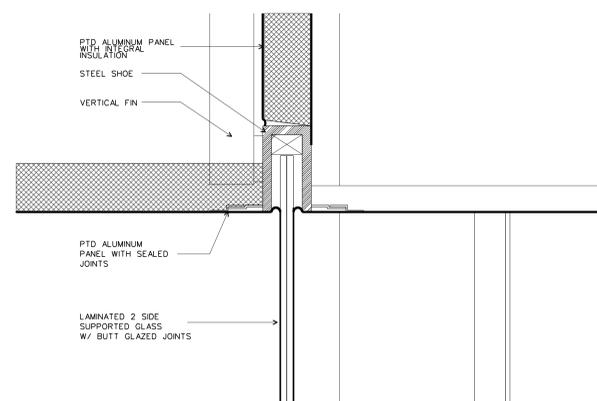


WALL SYSTEM H: TYP. DETAIL HEAD AT ENTRANCE

SCALE: 3" = 1'-0"

DETAILS/D-CWH02

31

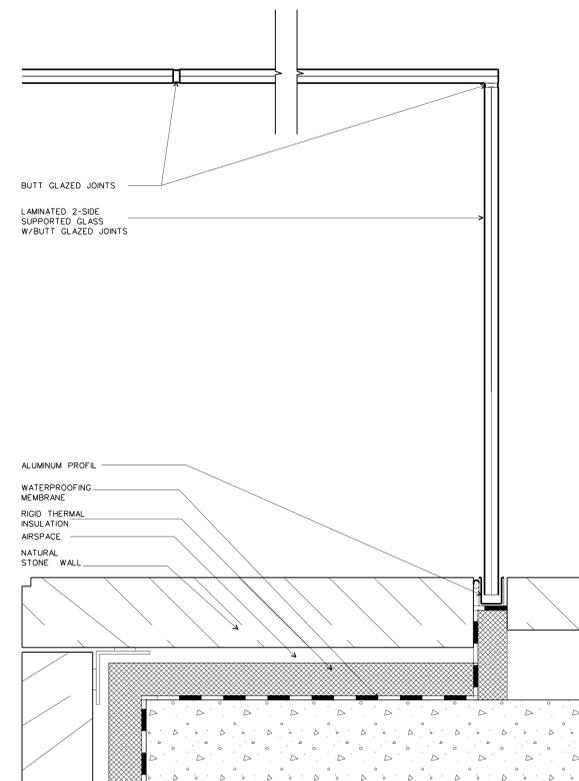


WALL SYSTEM H: PLAN DET. AT OPENINGS IN STONE WALL

SCALE: 3" = 1'-0"

DETAILS/D-CWH02

12

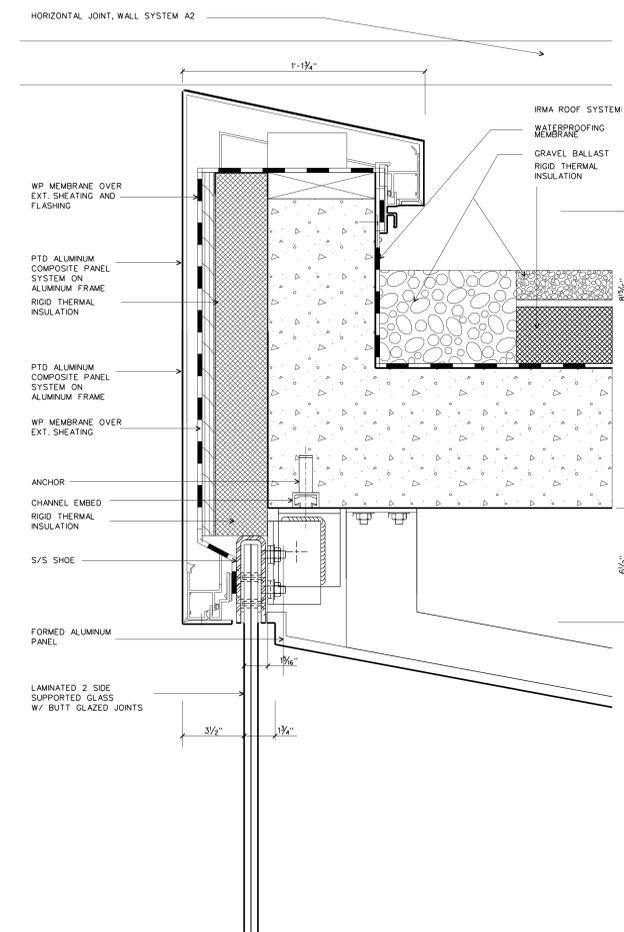


WALL SYSTEM H: DETAIL AT ROOF

SCALE: 3" = 1'-0"

DETAILS/D-CWH02

30

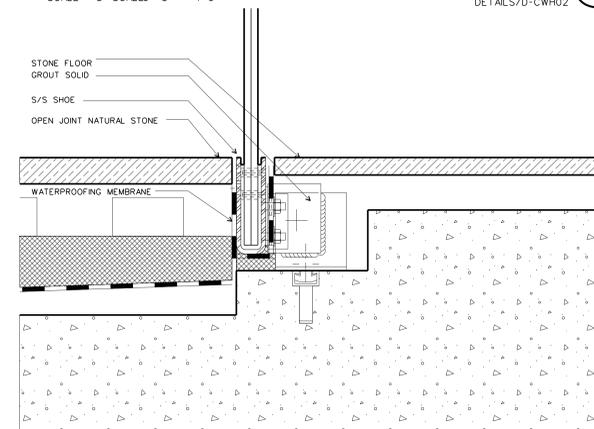


WALL SYSTEM H: DETAIL AT ROOF

SCALE: 3" = 1'-0"

DETAILS/D-CWH02

20

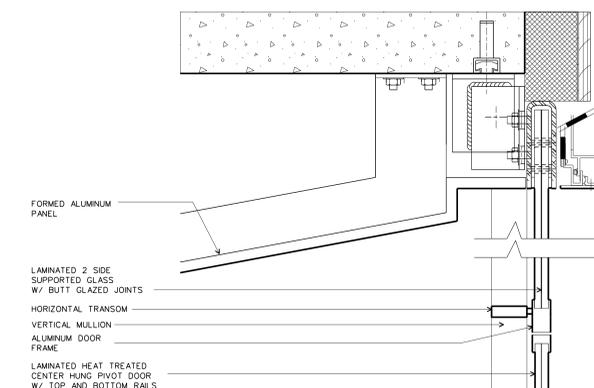

WALL SYSTEM H: DETAIL AT CEILING

SCALE: 3" = 1'-0"

DETAILS/D-CWH02

10

WILLIAM J. CLINTON
PRESIDENTIAL
CENTER

LITTLE ROCK, ARKANSAS

Architect
 POLSHEK PARTNERSHIP LLP
 320 West 13th Street
 New York, New York 10014
 212.807.7171

Coordinating Architects
 POLK STANLEY YEARY ARCHITECTS Ltd
 700 South Schiller Street
 Little Rock, Arkansas 72201
 501.378.0878

WITSELL EVANS RASCO
 901 West Third Street
 Little Rock, Arkansas 72201
 501.374.5300

WOODS CARADINE ARCHITECTS
 2200 South Main Street
 Little Rock, Arkansas 72206
 501.374.4960

Landscape Architects
 HARGREAVES ASSOCIATES
 118 Magazine Street
 Cambridge, Massachusetts 02139
 617.661.0070

LANDSCAPE ARCHITECTURE, Inc.
 2300 Cottondale Lane Suite 202
 Little Rock, Arkansas 72202
 501.374.5810

Structural Engineer
 LESLIE E. ROBERTSON ASSOC., RLLP
 30 Broad Street, 47th Floor
 New York, New York 10004
 212.750.9000


MEP Engineers
 FLACK + KURTZ, Inc.
 475 Fifth Avenue
 New York, New York 10017
 212.532.9600

CROMWELL ARCHITECTS ENGINEERS
 101 South Spring Street
 Little Rock, Arkansas 72201
 501.372.2900

Curtainwall Consultant
 R. A. HEINTGES ARCHITECTS
 126 Fifth Avenue, 9th Floor
 New York, New York 10011
 212.652-2968

Seal

Issue	Date
100% Construction Documents	09/27/02
90% Progress Printing	08/30/02
ASI #05	08/20/02
100% Struct./ CD Progress	07/01/02
Bridge Bldg. Substructure	06/14/02
100% Steel & Concrete CD	05/15/02
& Architectural CD Progress	
100% Design Development	03/01/02

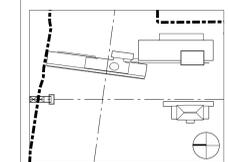

Job No. 9908

Scale 3" = 1'-0"

Date September 27, 2002

Title WALL SYSTEM H: GLASS: PLAN AND SECTION DETAILS

Sheet No.

A378