

**WILLIAM J. CLINTON
PRESIDENTIAL
CENTER**

LITTLE ROCK, ARKANSAS

Architect

POLSHEK PARTNERSHIP LLP
320 West 13th Street
New York, New York 10014
212.807.7171

Coordinating Architects

POLK STANLEY YEARY ARCHITECTS Ltd
700 South Schiller Street
Little Rock, Arkansas 72201
501.378.0878

WITSELL EVANS RASCO
901 West Third Street
Little Rock, Arkansas 72201
501.374.5300

WOODS CARADINE ARCHITECTS
2200 South Main Street
Little Rock, Arkansas 72206
501.374.4060

Landscape Architects

HARGREAVES ASSOCIATES
118 Magazine Street
Cambridge, Massachusetts 02139
617.661.0070

LANDSCAPE ARCHITECTURE, Inc.
2300 Cottondale Lane Suite 202
Little Rock, Arkansas 72202
501.374.5810

Structural Engineer

LESLIE E. ROBERTSON ASSOC., RLLP
30 Broad Street, 47th Floor
New York, New York 10004
212.750.9000

MEP Engineers

FLACK + KURTZ, Inc.
475 Fifth Avenue
New York, New York 10017
212.532.9600


CROMWELL ARCHITECTS ENGINEERS
101 South Spring Street
Little Rock, Arkansas 72201
501.372.2900

Curtainwall Consultant

R. A. HEINTGES ARCHITECTS
126 Fifth Avenue, 9th Floor
New York, New York 10011
212.652.2968

Seal

▲ ASI #22	08/01/03
▲ ASI #20	06/06/03
▲ Addendum #2	11/15/02
▲ 100% Construction Documents	09/27/02
90% Progress Printing	08/30/02
100% Struct./ CD Progress	07/01/02
100% Design Development	03/01/02
Issue	Date

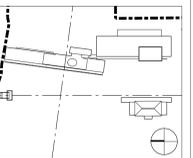

Job No. 9908

Scale AS NOTED

Date September 27, 2002


Title

**WALL SYSTEM J
DETAILS**

Sheet No.

A380

FOR OFFICIAL USE ONLY

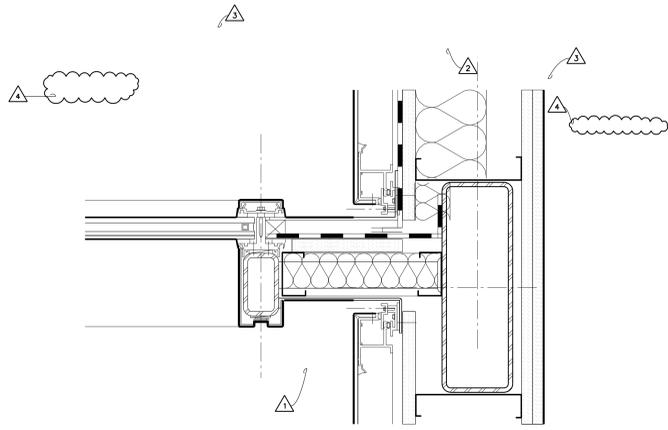


WALL SYSTEM J: PLAN SECTION AT METAL PANEL

SCALE: 3" = 1'-0"

D-CWJ01

43

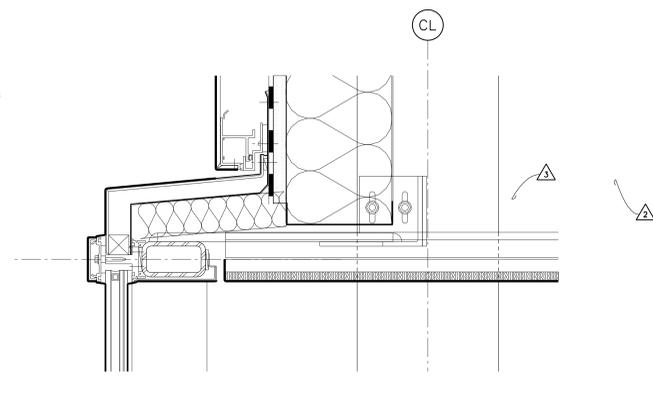


WALL SYSTEM J: DETAIL SECTION AT HEAD

SCALE: 3" = 1'-0"

D-CWJ01

42

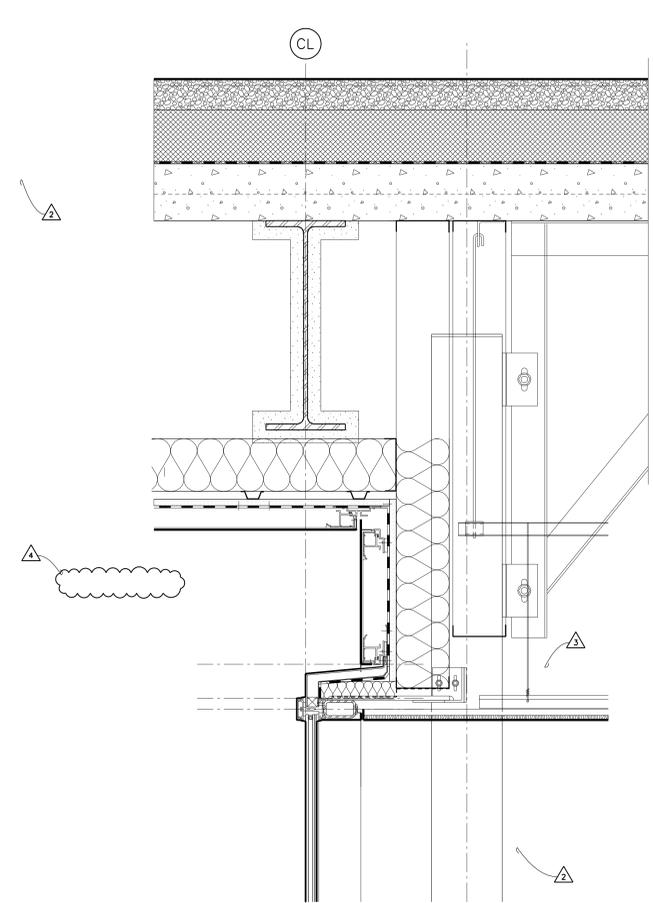


WALL SYSTEM J: DETAIL SECTION AT HEAD

SCALE: 1-1/2" = 1'-0"

D-CWJ01

31

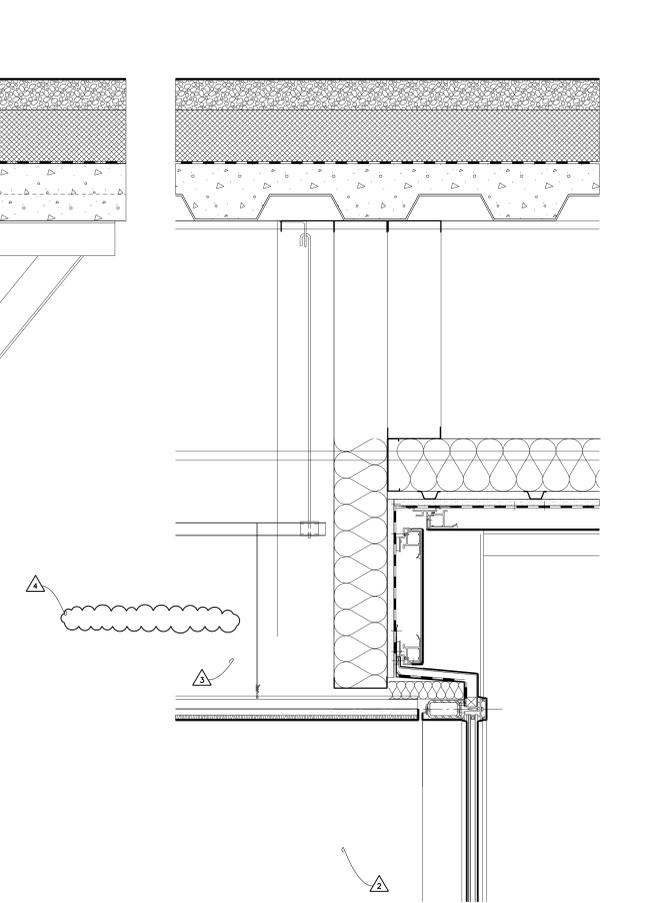


WALL SYSTEM J: DETAIL SECTION AT HEAD

SCALE: 1-1/2" = 1'-0"

D-CWJ01

30

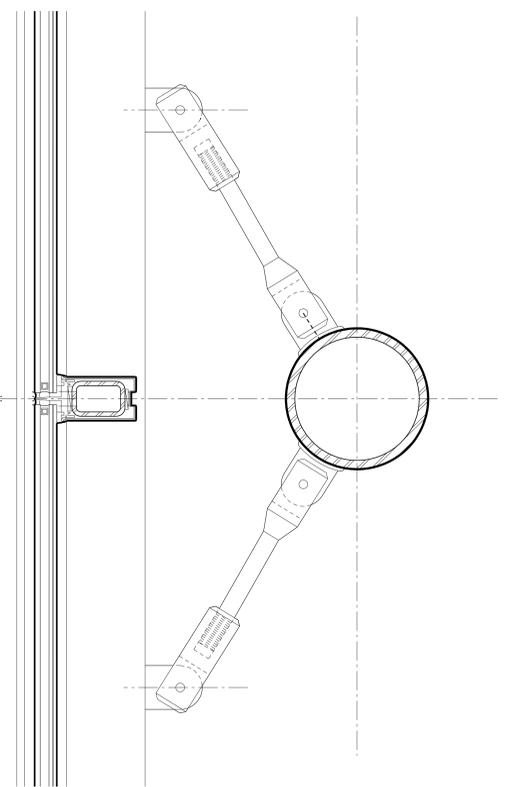


WALL SYSTEM J: PLAN DETAIL AT PIPE COLUMN

SCALE: 3" = 1'-0"

D-CWJ01

23

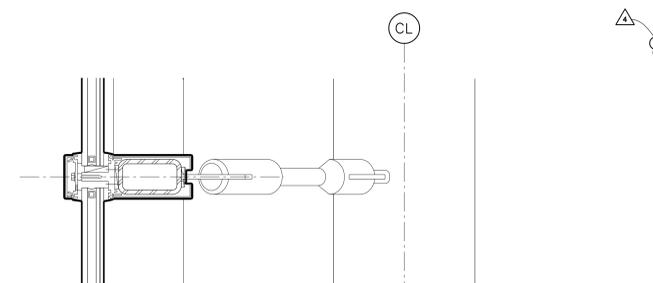


WALL SYSTEM J: DETAIL SECTION AT HORIZONTAL

SCALE: 3" = 1'-0"

D-CWJ01

32

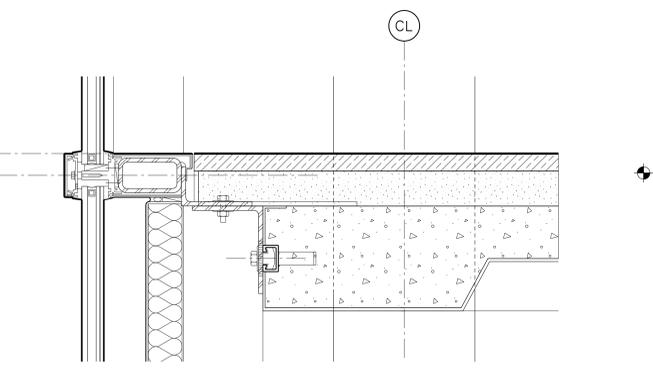


WALL SYSTEM J: DETAIL AT STAIR PLATFORM

SCALE: 3" = 1'-0"

D-CWJ01

22

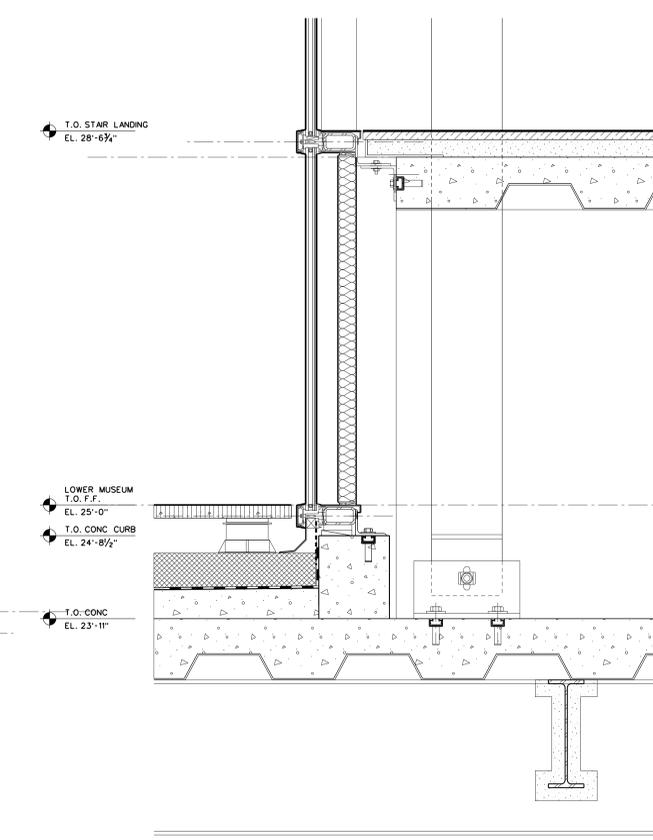


WALL SYSTEM J: DETAIL SECTION AT SILL

SCALE: 1-1/2" = 1'-0"

D-CWJ01

11

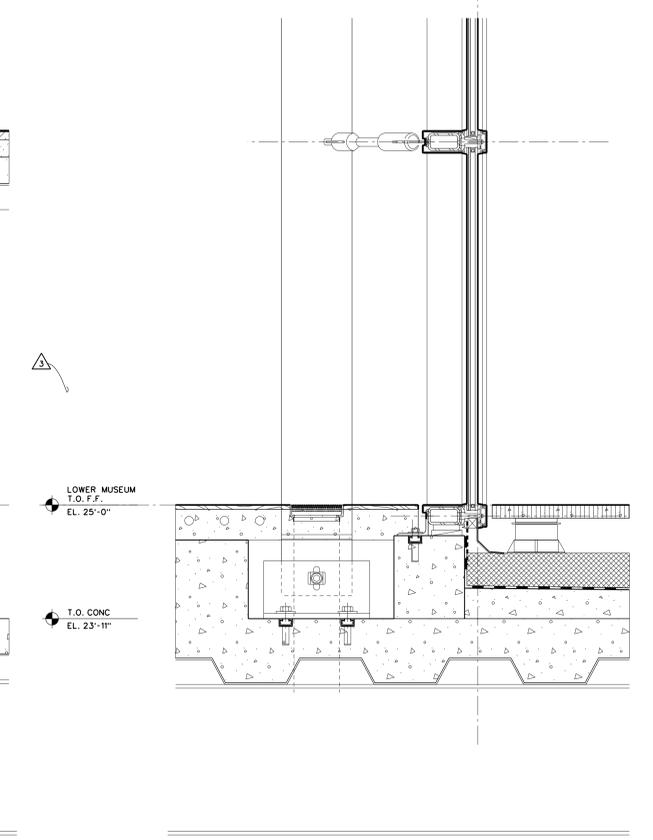


WALL SYSTEM J: DETAIL SECTION AT SILL

SCALE: 1-1/2" = 1'-0"

D-CWJ01

10

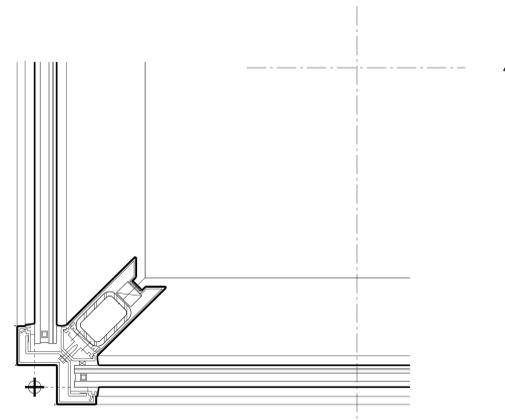


WALL SYSTEM J: PLAN DETAIL AT CORNER

SCALE: 3" = 1'-0"

D-CWJ01

13

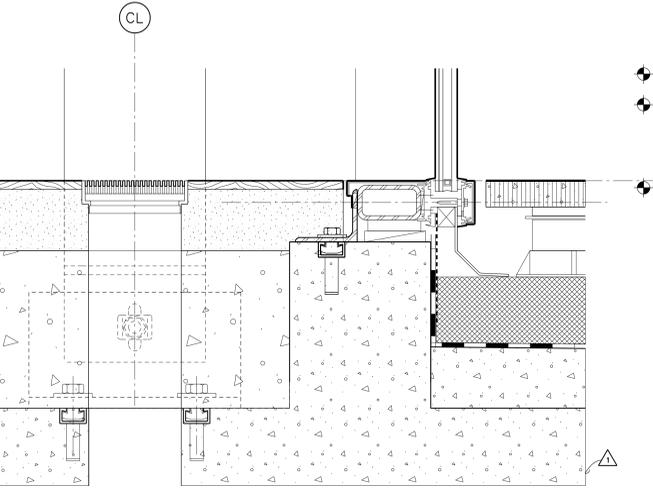

WALL SYSTEM J: SECTION DETAIL AT NORTH SILL

SCALE: 3" = 1'-0"

D-CWJ01

12

T.O. STAIR LANDING
EL. 28'-6 3/4"

T.O. STAIR LANDING
EL. 28'-6 3/4"

T.O. F.F.
EL. 25'-0"

T.O. CONC
EL. 23'-11"

LOWER MUSEUM
T.O. F.F.
EL. 25'-0"
T.O. CONC CURB
EL. 24'-8 7/2"

▲

LOWER MUSEUM
T.O. F.F.
EL. 25'-0"

T.O. CONC
EL. 23'-11"