


Seal

▲ ASI #22	08/01/03
▲ ASI #20	08/06/03
▲ ASI #18	04/18/03
▲ ASI #12	02/07/03
▲ 100% Construction Documents	09/27/02
▲ 90% Progress Printing	08/30/02
▲ 100% Struct./ CD Progress	07/01/02
▲ 100% Design Development	03/01/02
Issue	Date

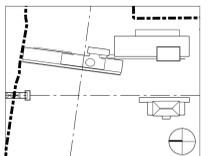

Job No. 9908

Scale 1-1/2" = 1'-0"

Date September 27, 2002


Title

**WALL SYSTEMS K
DETAIL SECTIONS**


Sheet No.

A382


FOR OFFICIAL USE ONLY

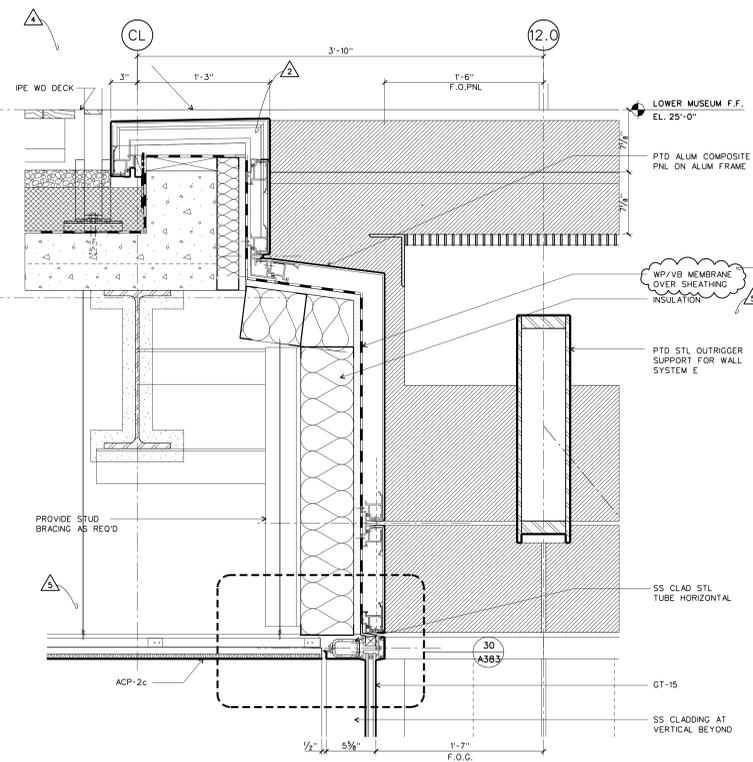


WALL SYSTEM K: DETAIL SECTION AT SOUTH HEAD 30
SCALE: 1-1/2" = 1'-0"
D-CWK01

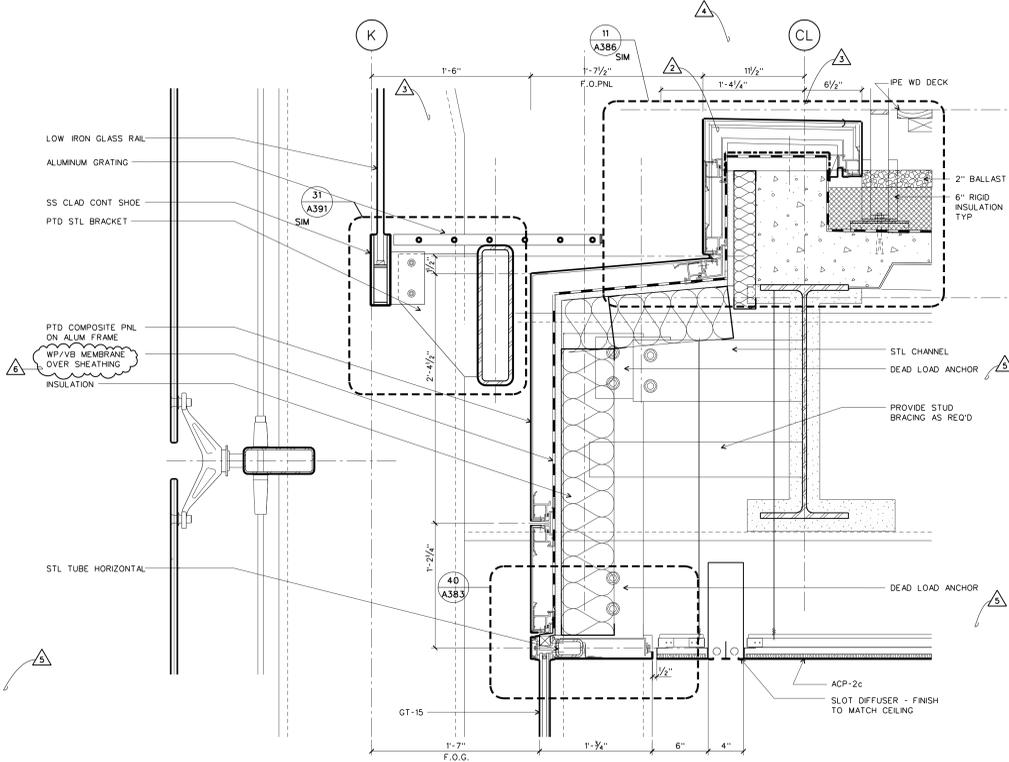


WALL SYSTEM K: DETAIL SECTION AT WEST HEAD 31
SCALE: 1-1/2" = 1'-0"
D-CWK01

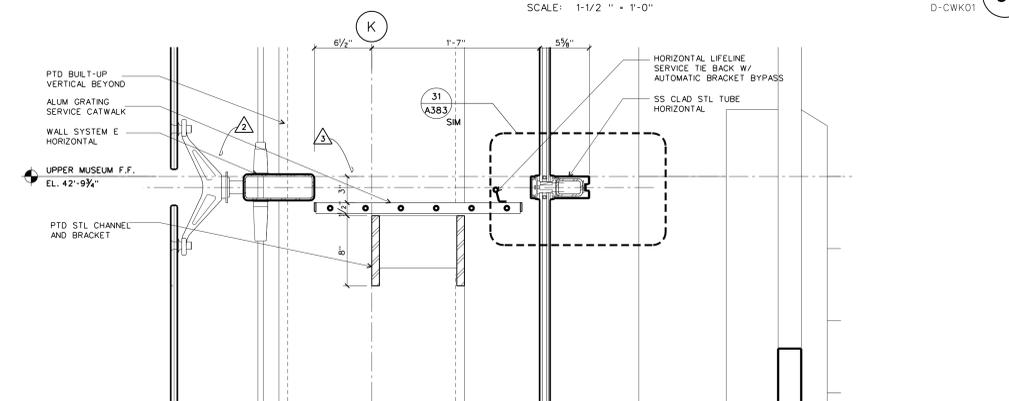


WALL SYSTEM K: SECTION AT UPPER MUSEUM SILL 21
SCALE: 1-1/2" = 1'-0"
D-CWK01

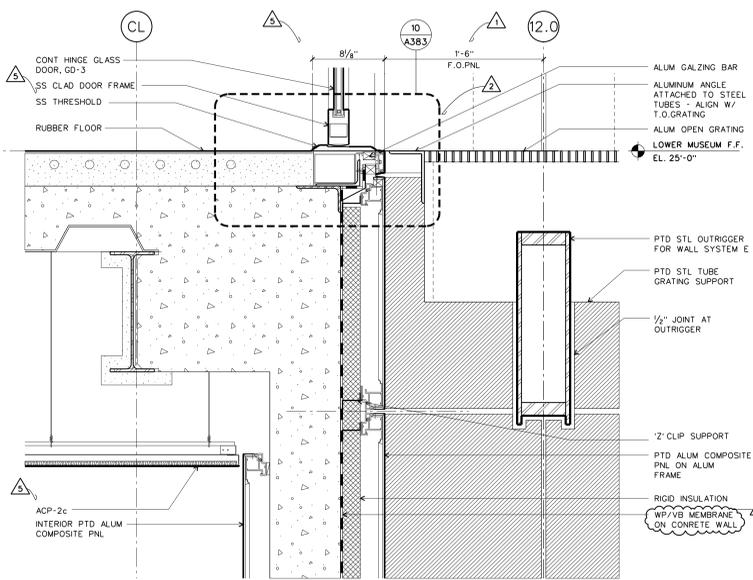


WALL SYSTEM K: DETAIL SECTION AT DOOR SILL 10
SCALE: 1-1/2" = 1'-0"
D-CWK01

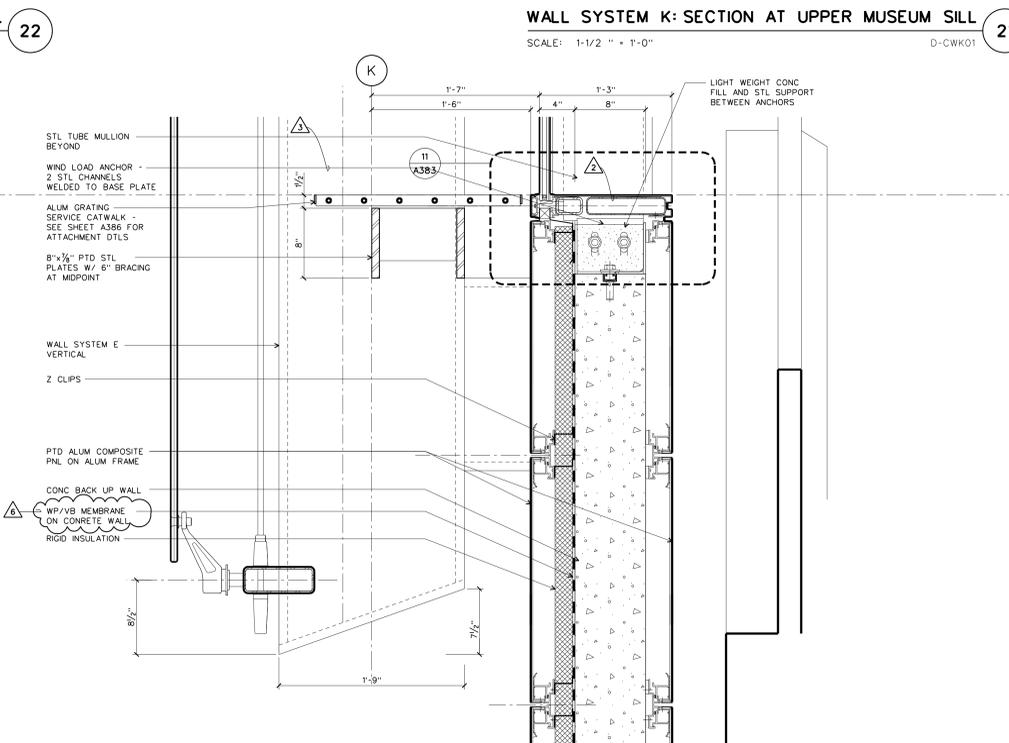

WALL SYSTEM K: DETAIL SECTION AT WEST SILL 11
SCALE: 1-1/2" = 1'-0"
D-CWK01

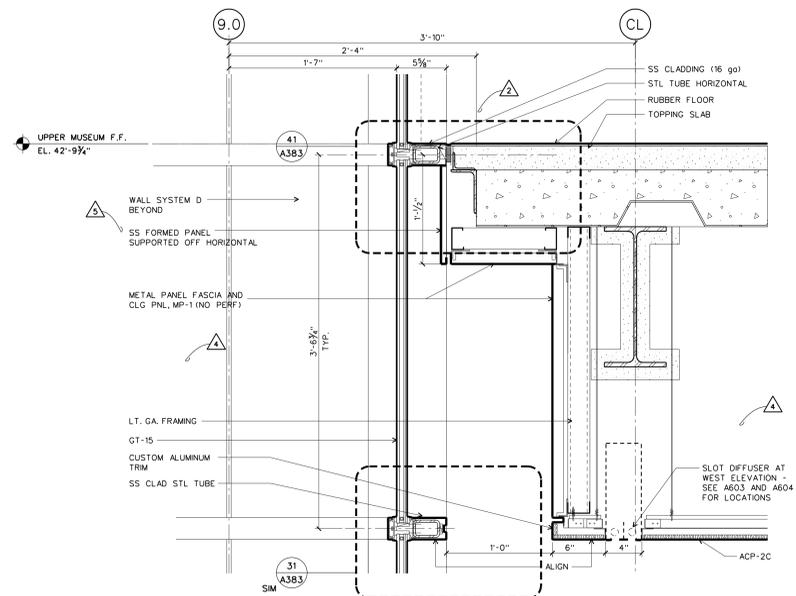

WALL SYSTEM K: SECTION AT UPPER MUSEUM SILL 22
SCALE: 1-1/2" = 1'-0"
D-CWK01

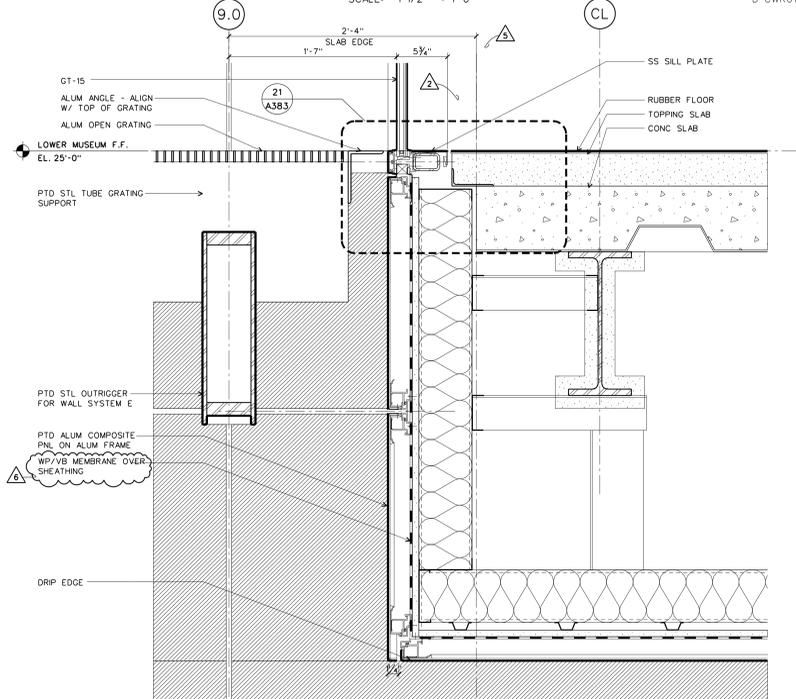

WALL SYSTEM K: DETAIL SECTION AT NORTH SILL 12
SCALE: 1-1/2" = 1'-0"
D-CWK01



WALL SYSTEM K: SECTION AT UPPER MUSEUM SILL 9.0
SCALE: 1-1/2" = 1'-0"
D-CWK01