


Seal

ASI #22	08.01.03
ASI #18	04/18/03
Addendum #2	11/15/02
100% Construction Documents	09/27/02
90% Progress Printing	08/30/02
100% Struct./CD Progress	07/01/02
100% Design Development	03/01/02
Issue	Date

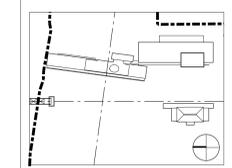


Job No. 9908
Scale 3" = 1'-0"
Date September 27, 2002
Title

**WALL SYSTEMS K
PLAN AND SECTION
DETAILS**


Sheet No.

A383


FOR OFFICIAL USE ONLY

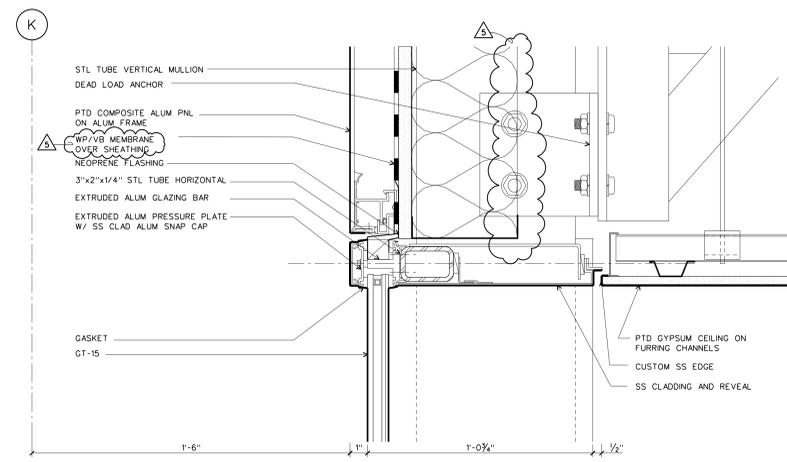


WALL SYSTEM K: SECTION DETAIL AT HEAD
SCALE: 3" = 1'-0" D-CWK02 40

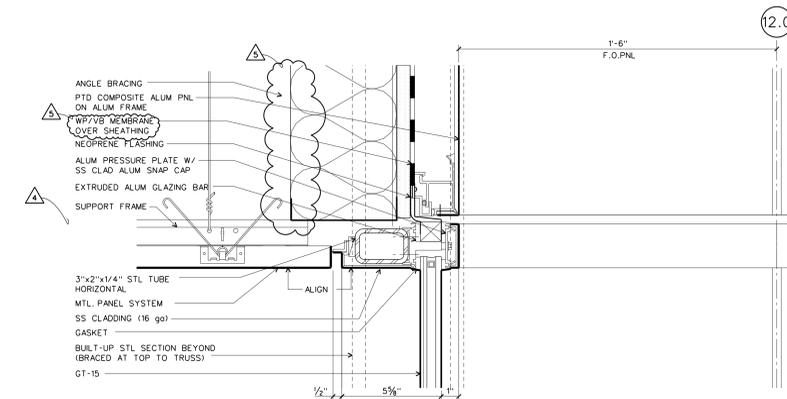


WALL SYSTEM K: SECTION DETAIL AT HEAD
SCALE: 3" = 1'-0" D-CWK02 30

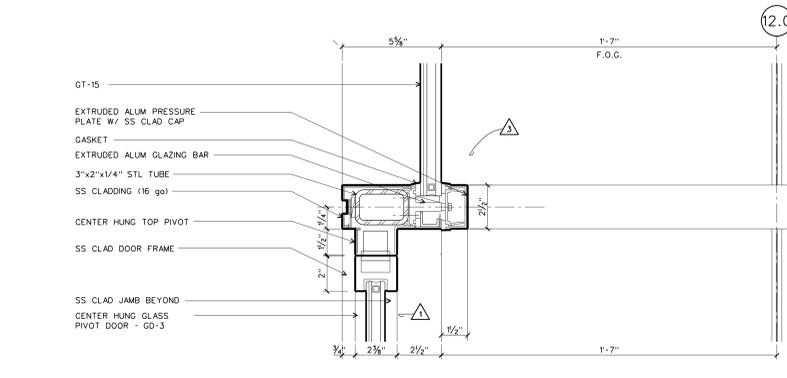


WALL SYSTEM K: SECTION DETAIL AT DOOR HEAD
SCALE: 3" = 1'-0" D-CWK02 20

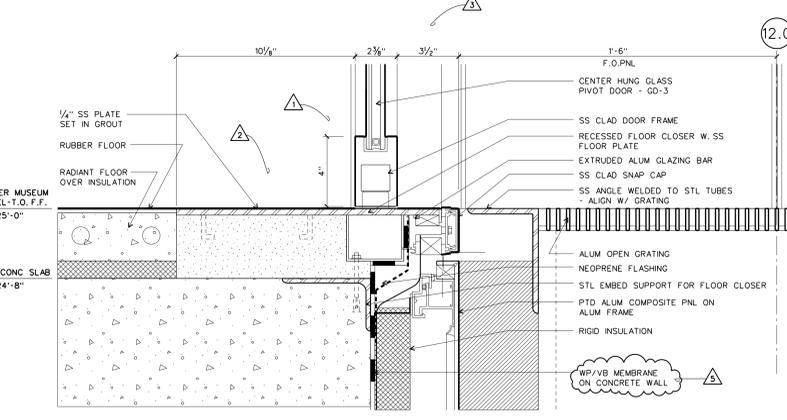


WALL SYSTEM K: SECTION DETAIL AT DOOR
SCALE: 3" = 1'-0" D-CWK02 10

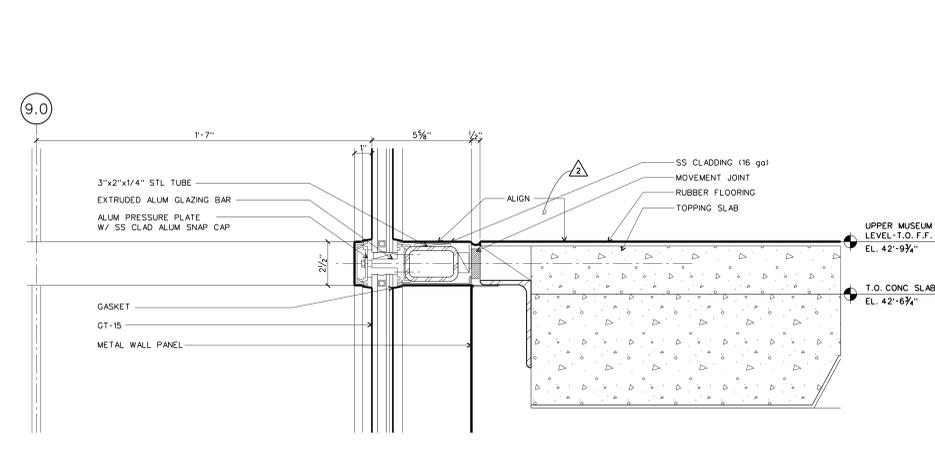


WALL SYSTEM K: SECTION DETAIL AT SILL
SCALE: 3" = 1'-0" D-CWK02 41

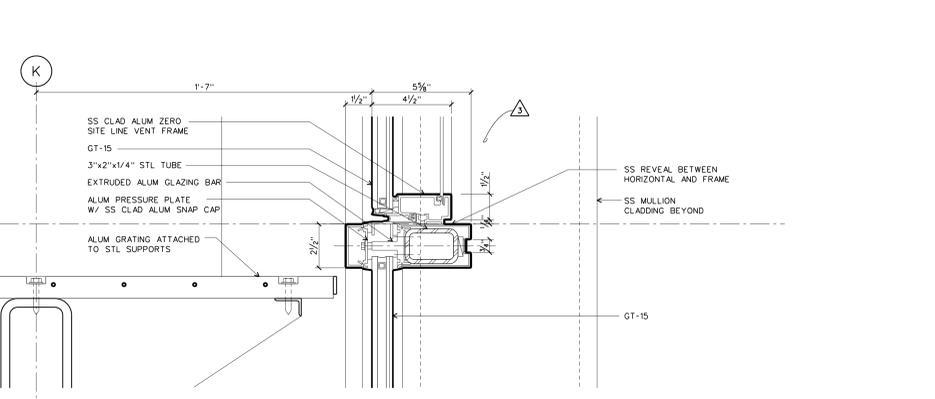


WALL SYSTEM K: SECTION DETAIL AT HORIZONTAL
SCALE: 3" = 1'-0" D-CWK02 31

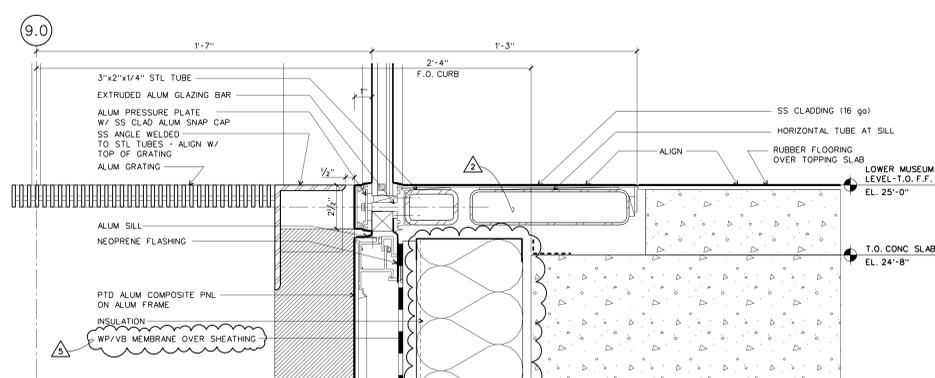


WALL SYSTEM K: SECTION DETAIL AT SILL
SCALE: 3" = 1'-0" D-CWK02 21

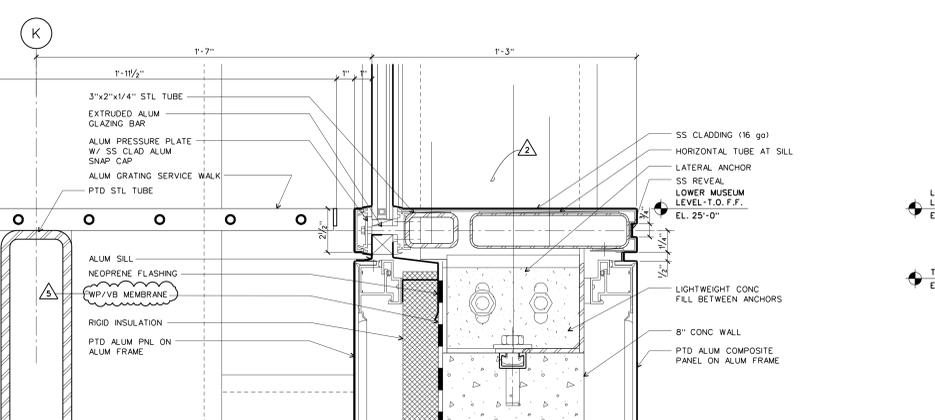


WALL SYSTEM K: SECTION DETAIL AT SILL
SCALE: 3" = 1'-0" D-CWK02 11

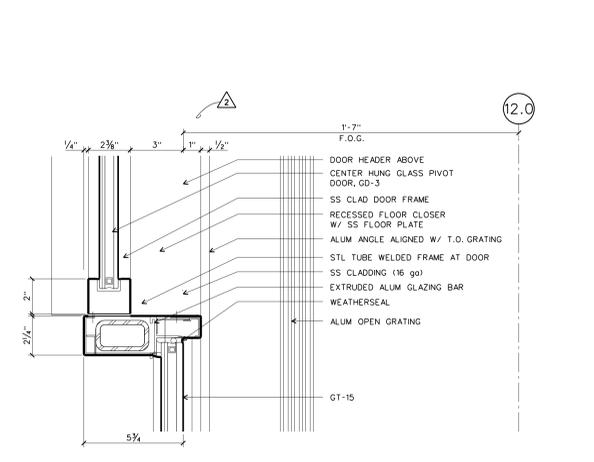

WALL SYSTEM K: PLAN DETAIL AT DOOR JAMB
SCALE: 3" = 1'-0" D-CWK02 32

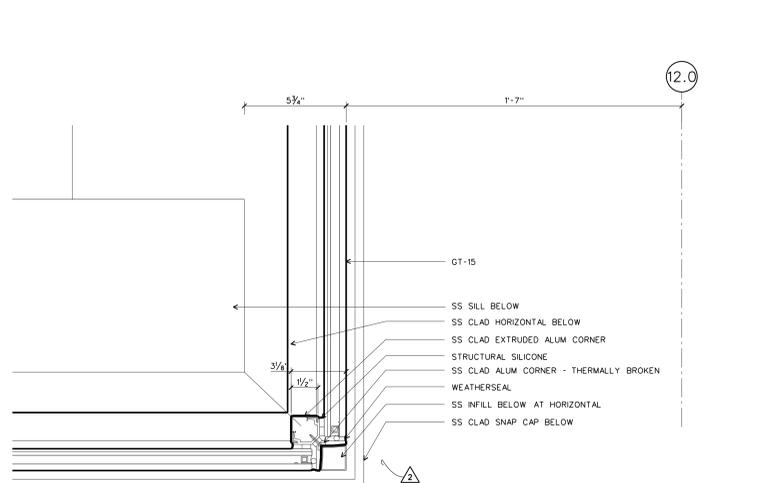

WALL SYSTEM K: PLAN DETAIL AT CORNER
SCALE: 3" = 1'-0" D-CWK02 22

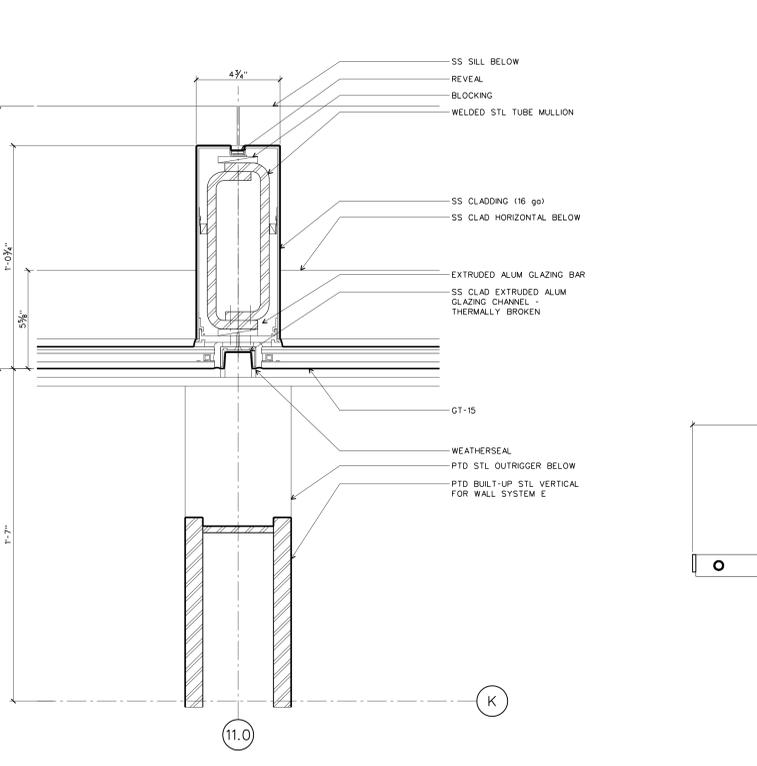

WALL SYSTEM K: PLAN DETAIL AT MULLION
SCALE: 3" = 1'-0" D-CWK02 12