


ASI #36	06/25/04
Addendum #2	11/15/02
100% Construction Documents	09/27/02
90% Progress Printing	08/30/02
ASI #05	08/20/02
100% Struct./ CD Progress	07/01/02
Bridge Bldg. Substructure	06/14/02
100% Steel & Concrete CD	05/15/02
& Architectural CD Progress	
100% Design Development	03/01/02
Issue	Date

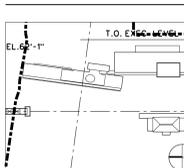

Job No. 9908

Scale 1-1/2" = 1'-0"

Date September 27, 2002


Title

ROOF DETAILS

Sheet No.

A387


FOR OFFICIAL USE ONLY

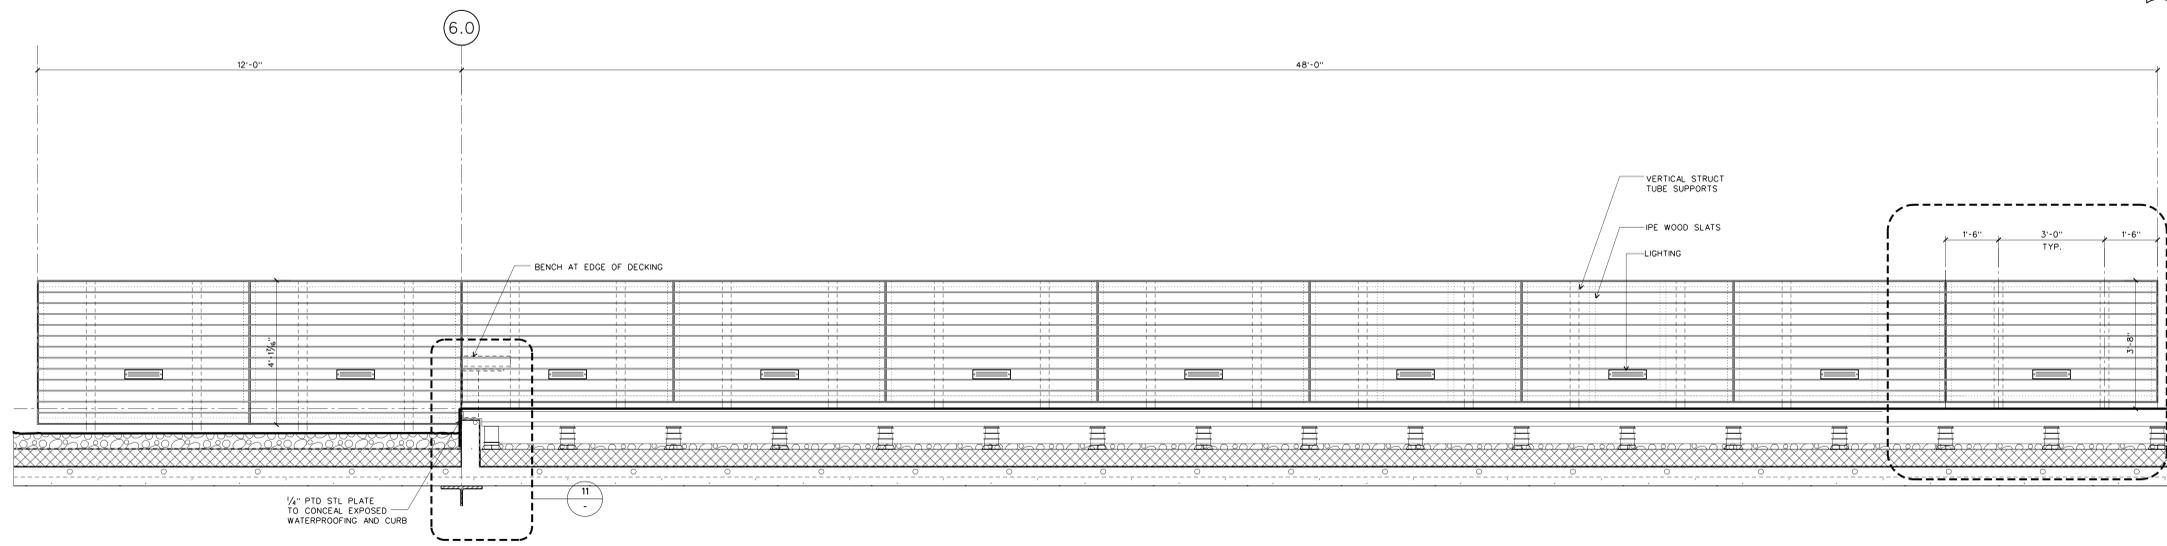

DETAIL ELEVATION AT IPE SCREEN WALL

SCALE: 1/2" = 1'-0"


D-EXT-ROOF02 30

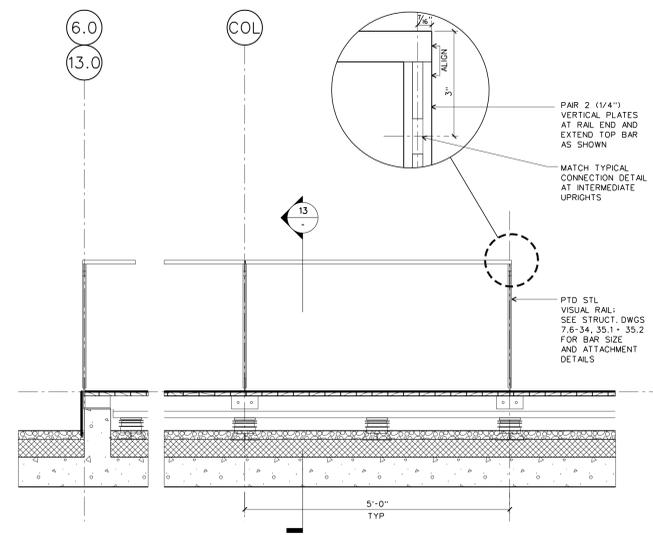

ELEVATION AT VISUAL RAIL: END CONDITIONS

SCALE: 3/4" = 1'-0"


D-EXT-ROOF02 23

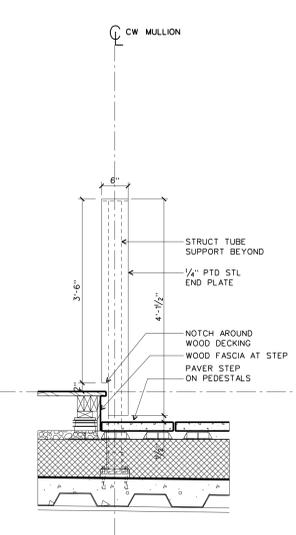

IPE SCREEN WALL END ELEVATION

SCALE: 3/4" = 1'-0"


D-EXT-ROOF02 22

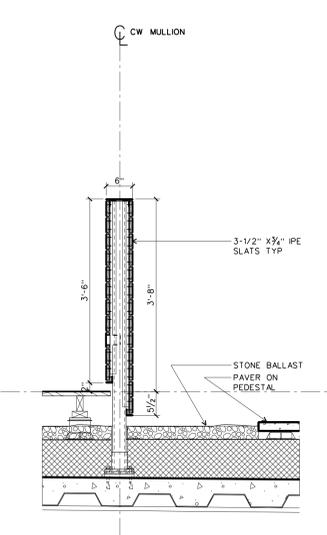

IPE SCREEN WALL SECTION

SCALE: 3/4" = 1'-0"


D-EXT-ROOF02 21

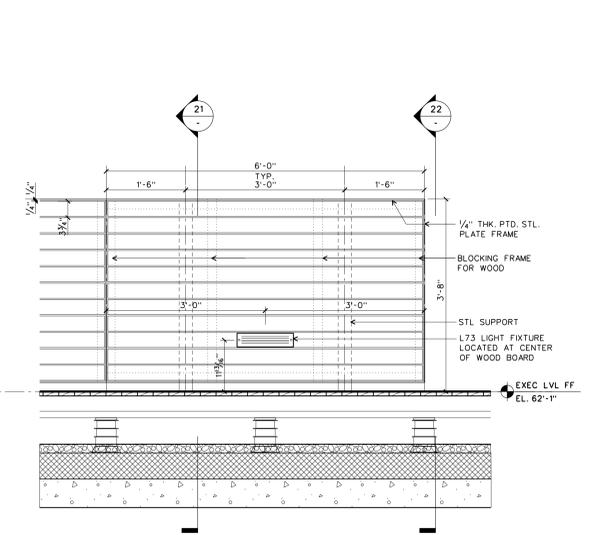

DETAIL ELEVATION AT IPE SCREEN WALL

SCALE: 3/4" = 1'-0"


D-EXT-ROOF02 20

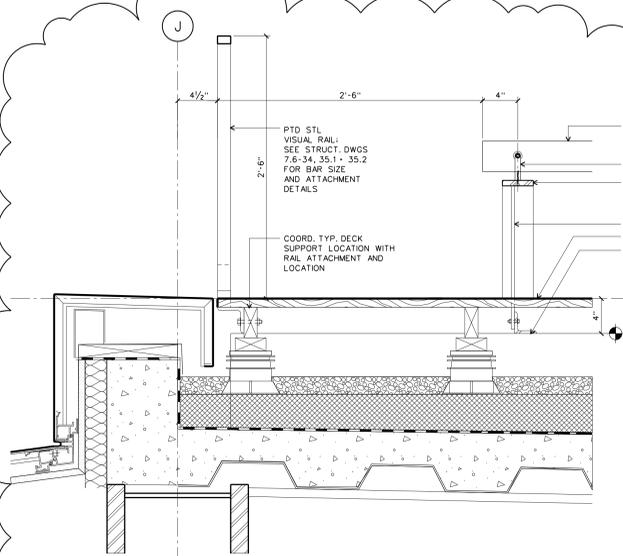

SECTION AT WOOD BENCH END AND VISUAL RAIL

SCALE: 1-1/2" = 1'-0"


D-EXT-ROOF02 13

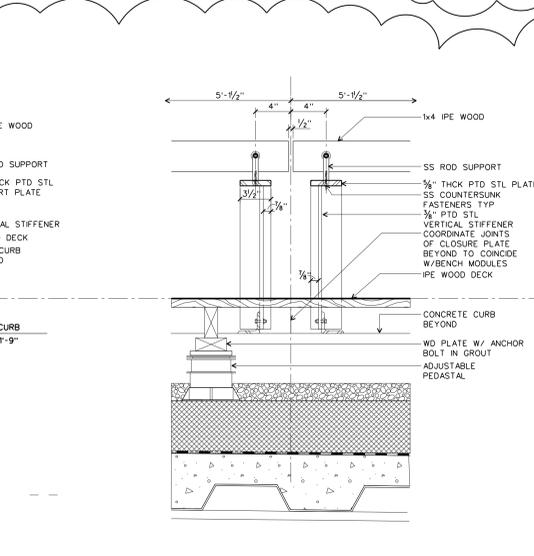

SECTION AT IPE WOOD BENCH

SCALE: 1-1/2" = 1'-0"


D-EXT-ROOF02 12

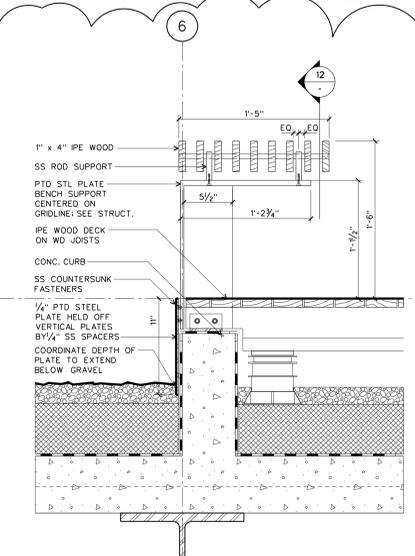

CROSS SECTION AT IPE WOOD BENCH

SCALE: 1-1/2" = 1'-0"

D-EXT-ROOF02 11

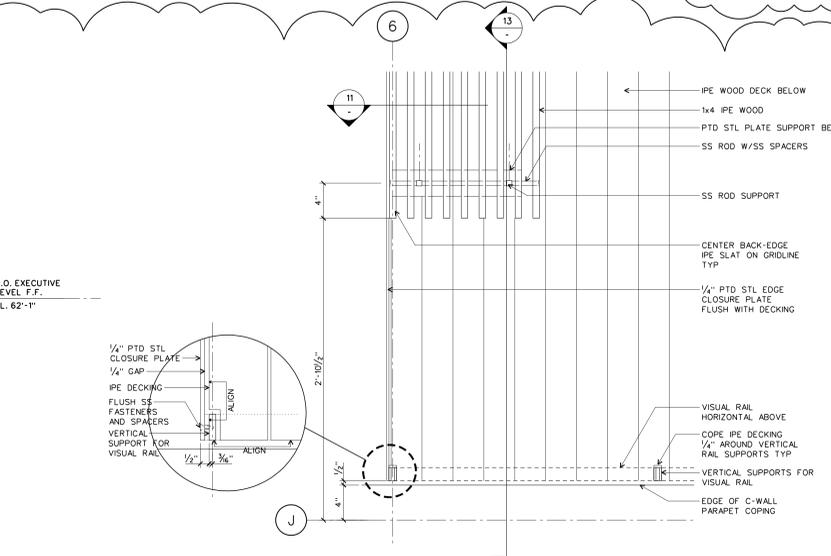

PLAN DETAIL AT IPE WOOD BENCH

SCALE: 1-1/2" = 1'-0"

D-EXT-ROOF02 10