




SKYLIGHT PLAN
SCALE: 1-1/2" = 1'-0"

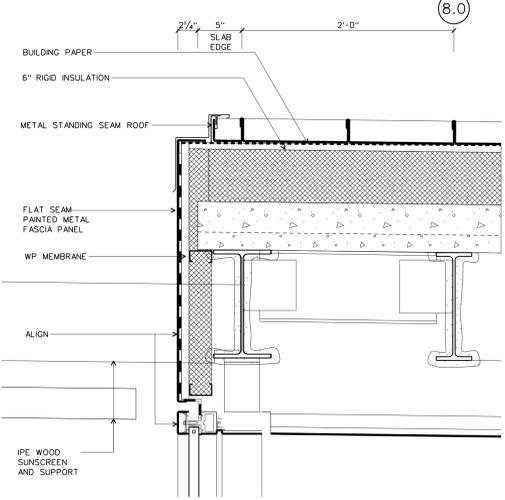


EXEC ROOF: DETAIL SECTION THROUGH GABLE TYP
SCALE: 1-1/2" = 1'-0"

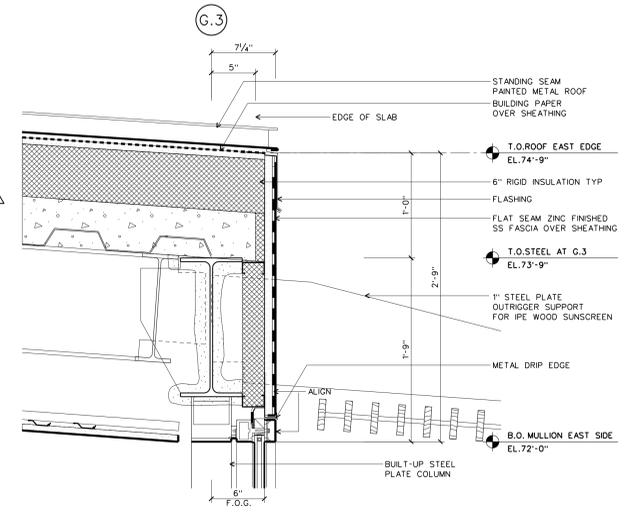


EXEC ROOF: DETAIL SECTION THROUGH WEST EAVE
SCALE: 1-1/2" = 1'-0"

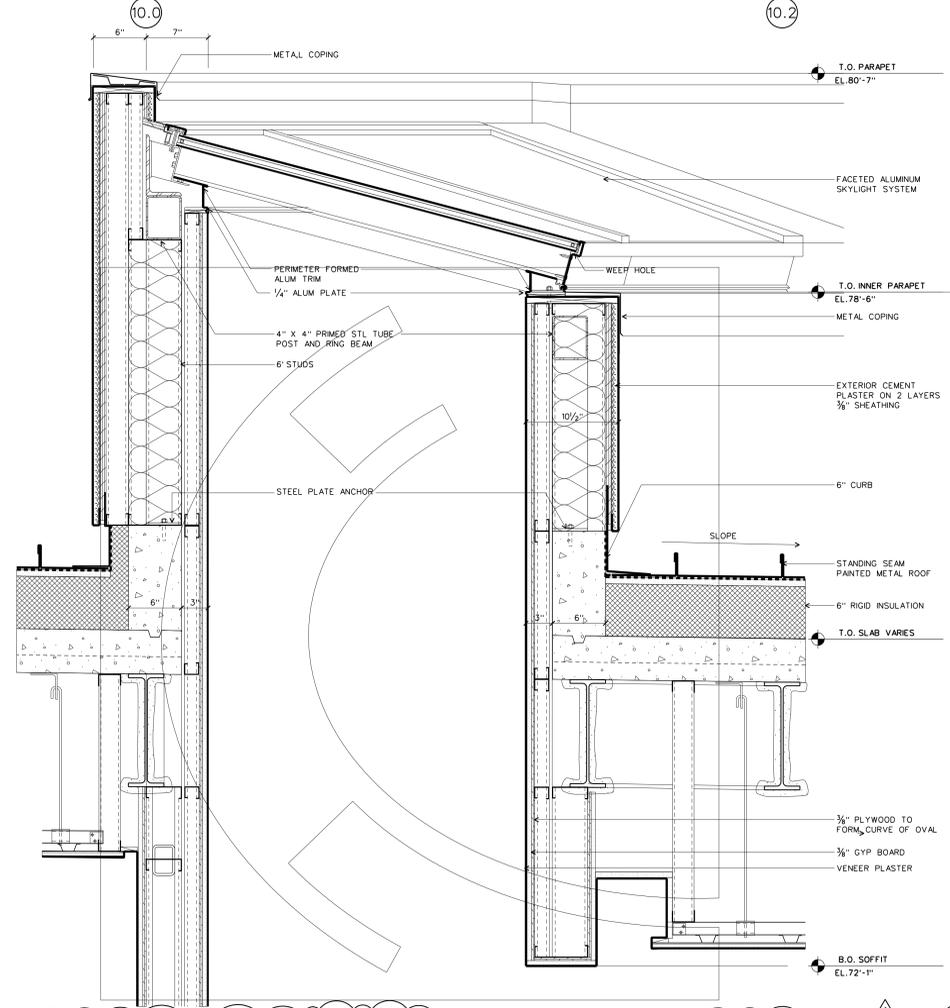


EXEC SKYLIGHT: SECTION DETAIL
SCALE: 1-1/2" = 1'-0"

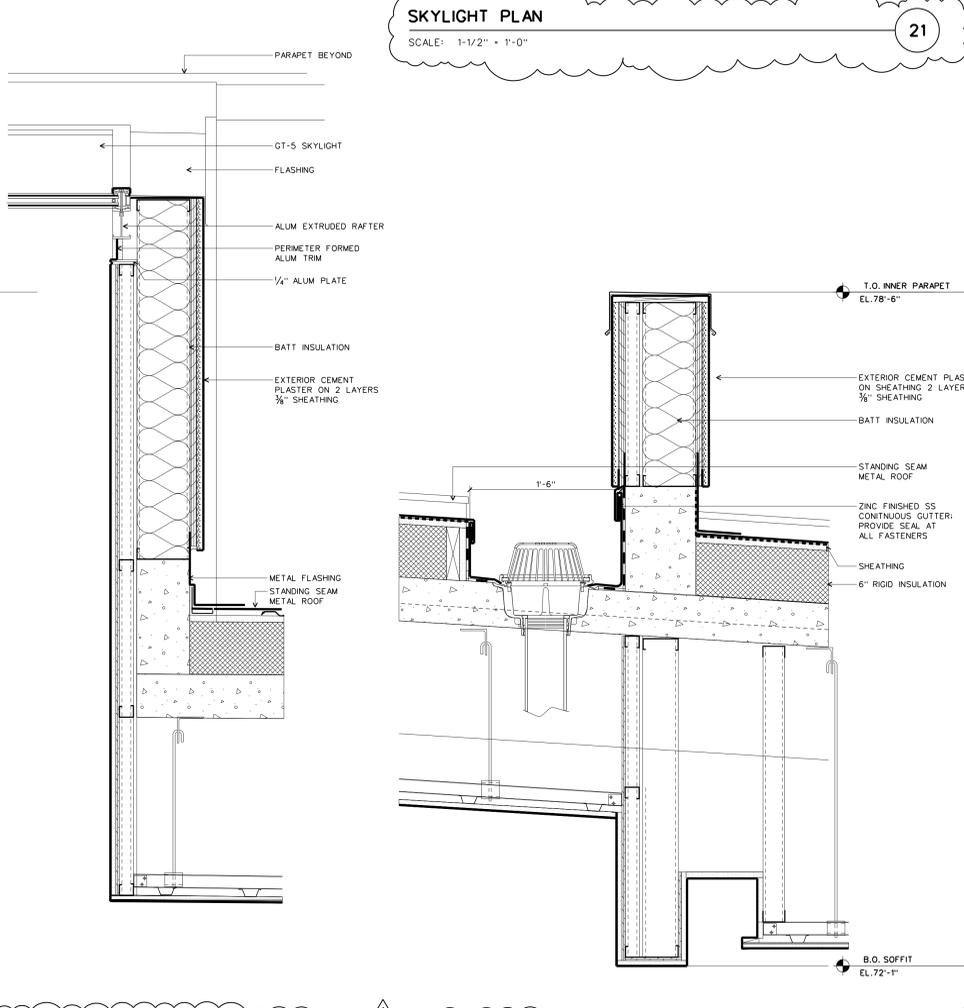

EXEC SKYLIGHT: DETAIL SECTION OF GABLE
SCALE: 1-1/2" = 1'-0"

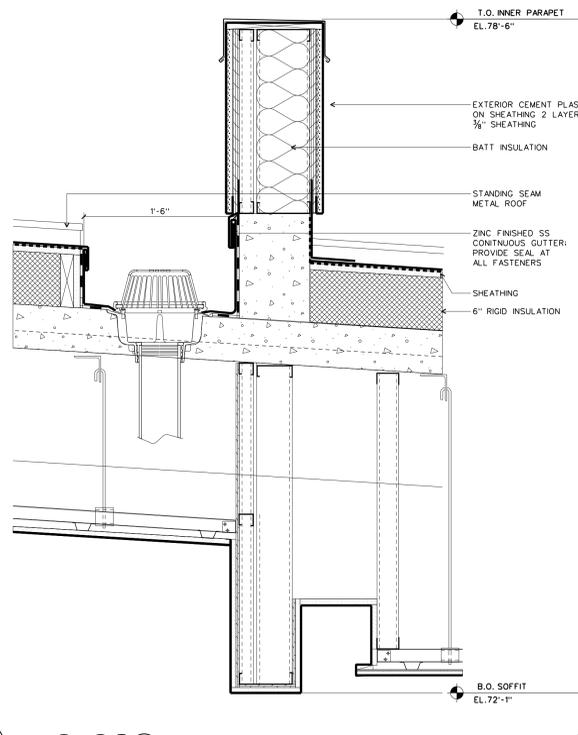

EXEC ROOF: DETAIL SECTION THROUGH WEST PARAPET
SCALE: 1-1/2" = 1'-0"

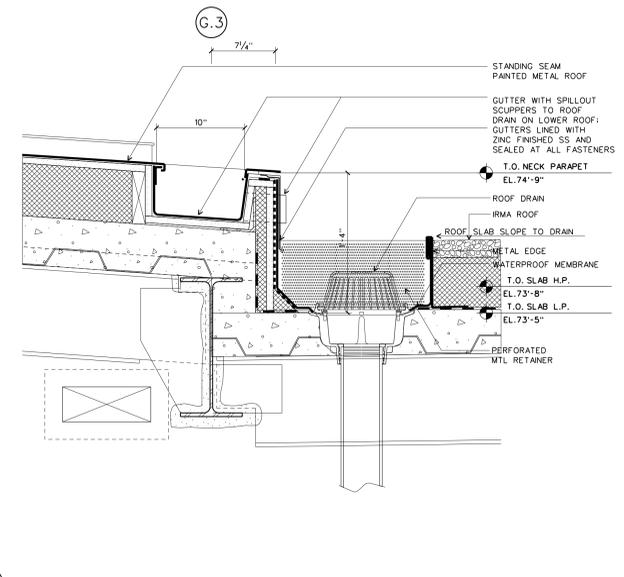

EXEC ROOF: DETAIL SECTION OF TRANSITION TO CORE ROOF
SCALE: 1-1/2" = 1'-0"