


REFERENCE PLAN: MODULE TYPES AND REF. ELEVATIONS

SCALE: 1-1/2" = 1'-0"

detail/canopy exec lev

10A

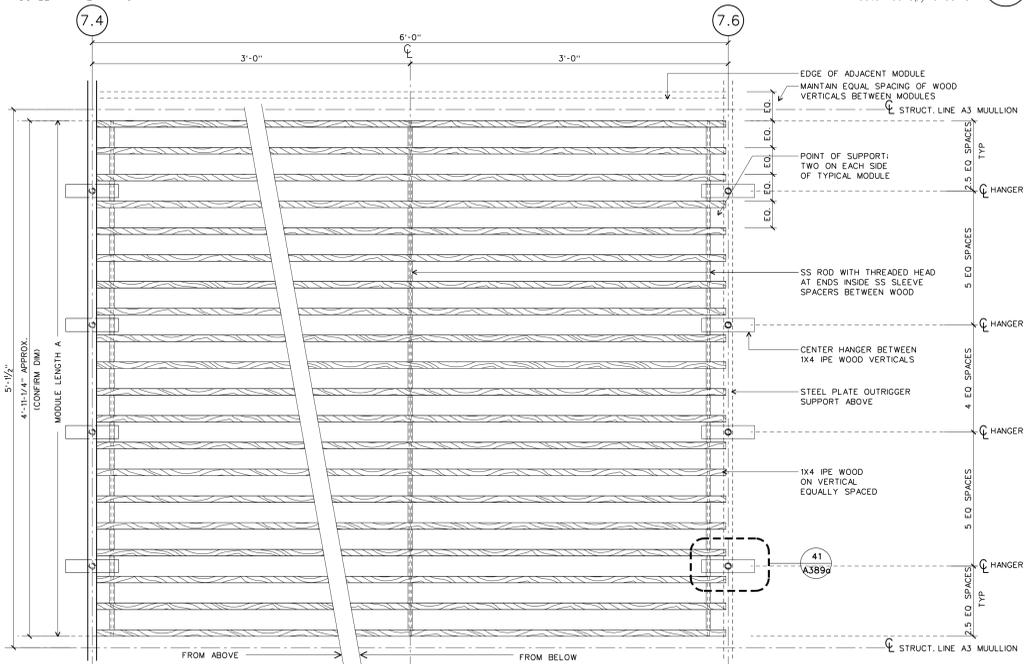


PLAN: TYPICAL SUNSCREEN MODULE LENGTH A

SCALE: 1-1/2" = 1'-0"

detail/canopy exec lev

31

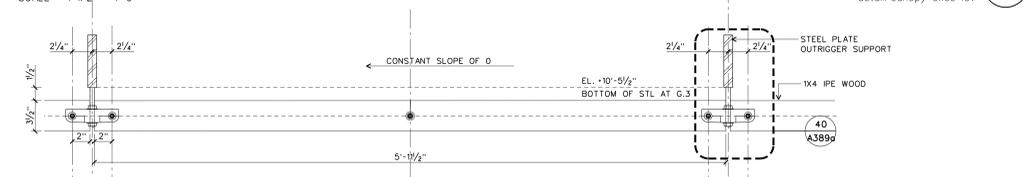


ELEVATION SECTION: TYPICAL SUNSCREEN MODULE AT G.3 FACING EAST

SCALE: 1-1/2" = 1'-0"

detail/canopy exec lev

21

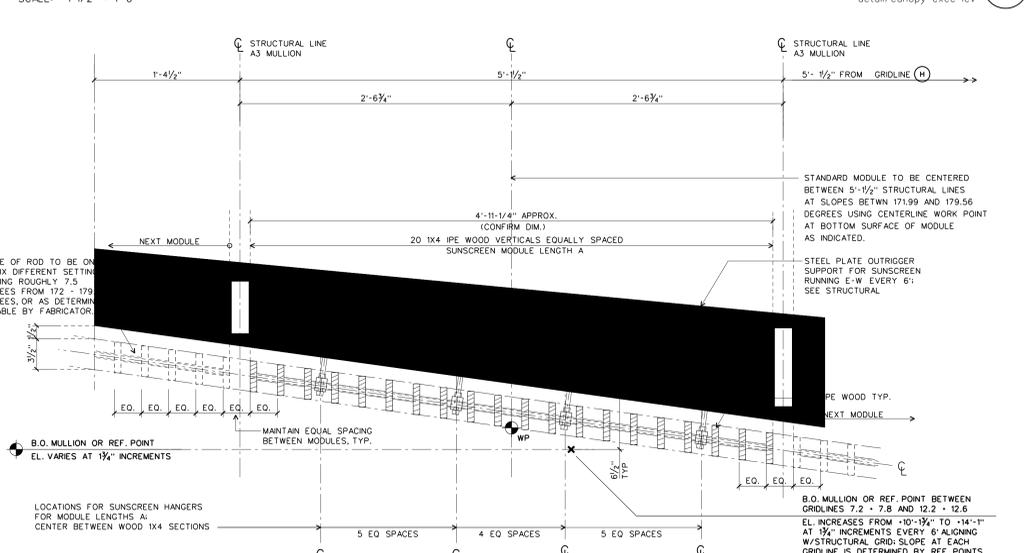


SECTION DETAIL: TYPICAL SUNSCREEN MODULE LENGTH A

SCALE: 1-1/2" = 1'-0"

detail/canopy exec lev

11

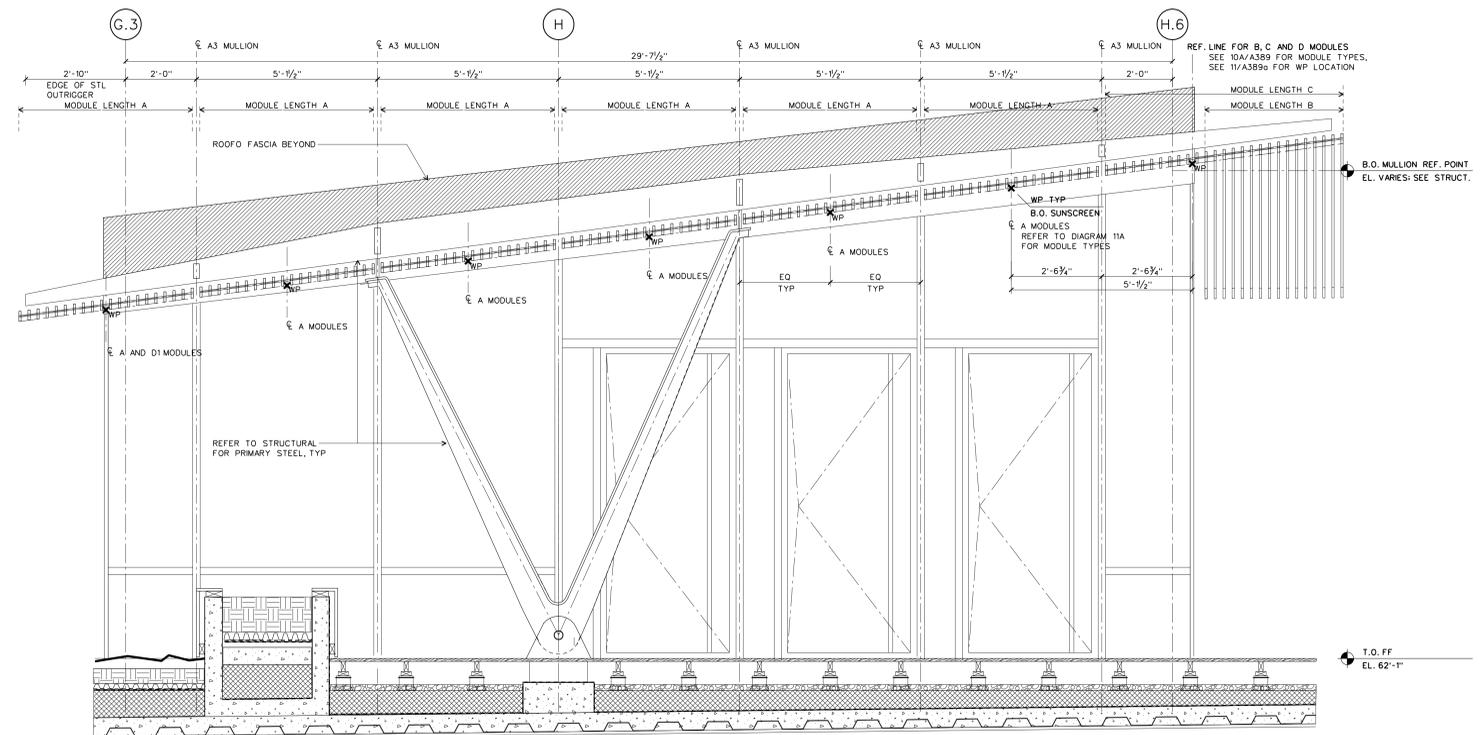


CANOPY SUPPORT AT NORTH

SCALE: 1/2" = 1'-0"

detail/canopy exec lev

20

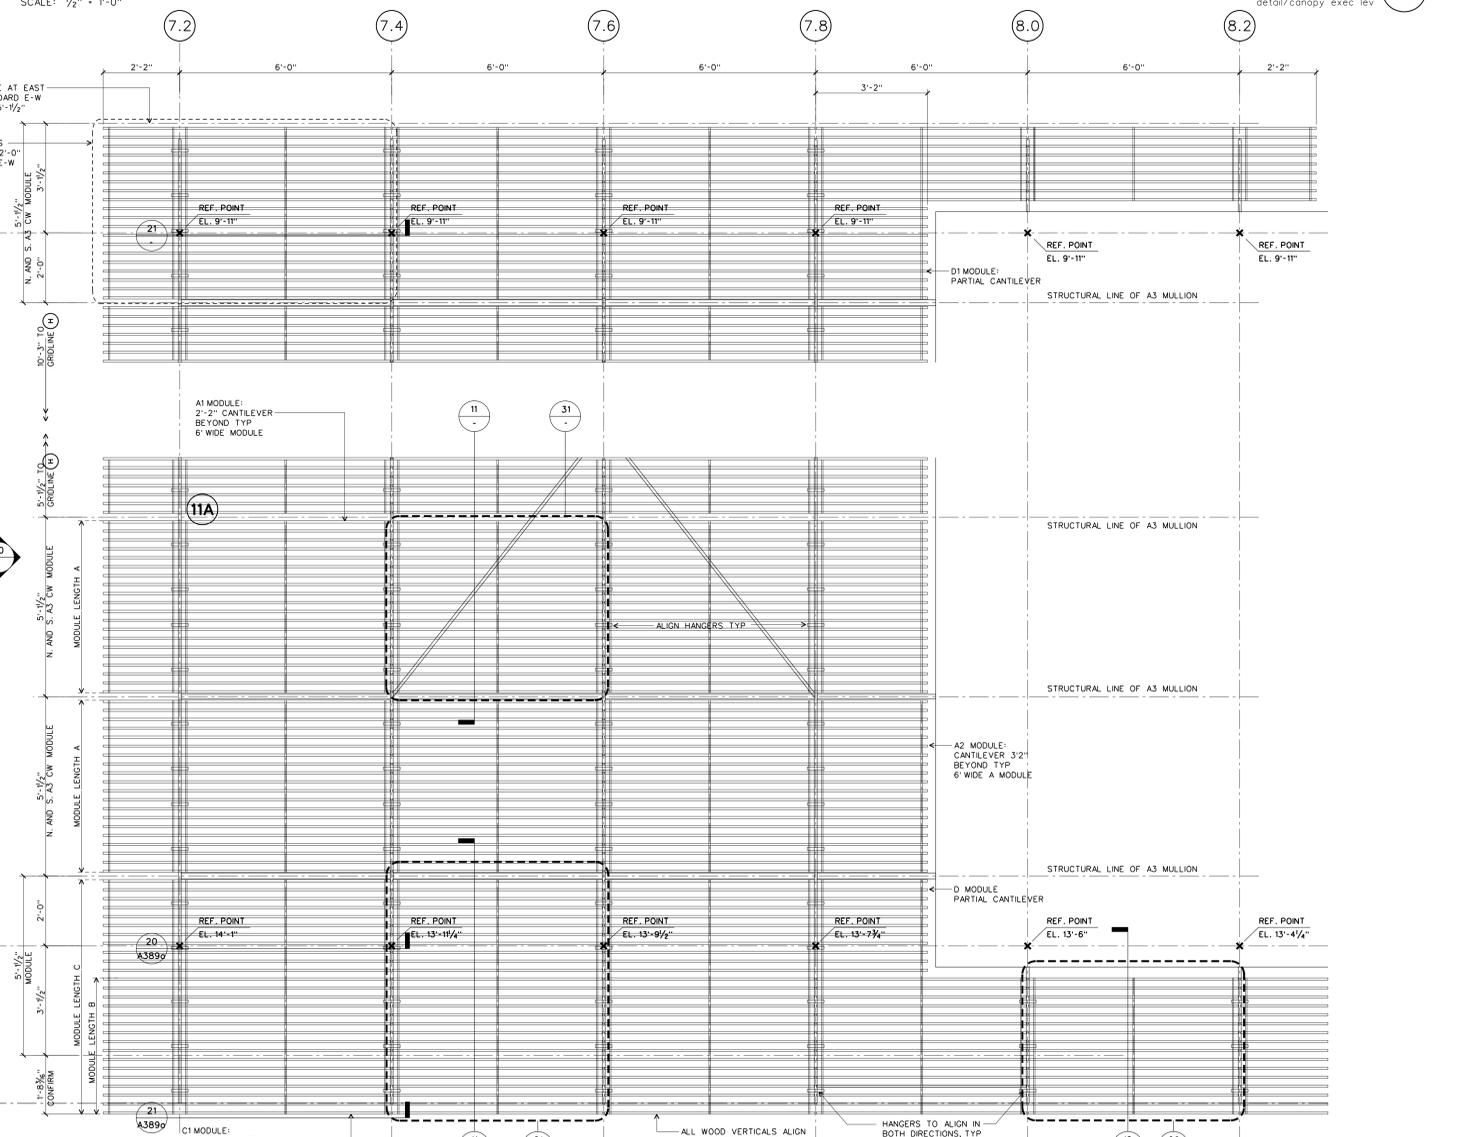

PLAN SUNSCREEN AT NORTH EXECUTIVE LEVEL

SCALE: 1/2" = 1'-0"

detail/canopy exec lev

10

**WILLIAM J. CLINTON  
PRESIDENTIAL  
CENTER**

LITTLE ROCK, ARKANSAS

Architect  
POLSHKE PARTNERSHIP LLP  
320 West 13th Street  
New York, New York 10014  
212.807.7171

Coordinating Architects  
POLK STANLEY YEARY ARCHITECTS Ltd  
700 South Schiller Street  
Little Rock, Arkansas 72201  
501.378.0878

WITSELL EVANS RASCO  
901 West Third Street  
Little Rock, Arkansas 72201  
501.374.5300

WOODS CARADINE ARCHITECTS  
2200 South Main Street  
Little Rock, Arkansas 72206  
501.374.4060

Landscape Architects  
HARGREAVES ASSOCIATES  
118 Magazine Street  
Cambridge, Massachusetts 02139  
617.661.0070

LANDSCAPE ARCHITECTURE, Inc.  
2300 Cottondale Lane Suite 202  
Little Rock, Arkansas 72202  
501.374.5610

Structural Engineer  
LESLIE E. ROBERTSON ASSOC., RLLP  
30 Broad Street, 47th Floor  
New York, New York 10004  
212.750.9000


MEP Engineers  
FLACK + KURTZ, Inc.  
475 Fifth Avenue  
New York, New York 10017  
212.532.9600

CROMWELL ARCHITECTS ENGINEERS  
101 South Spring Street  
Little Rock, Arkansas 72201  
501.372.2900

Curtainwall Consultant  
R. A. HEINTGES ARCHITECTS  
126 Fifth Avenue, 9th Floor  
New York, New York 10011  
212.652.2968

Seal

Issue	Date
ASI #13	02/14/03
Addendum #12	02/07/03
100% Construction Documents	09/27/02
100% Struct./ CD Progress	07/01/02

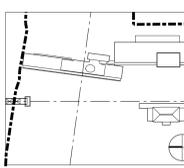

Job No. 9908  
Scale AS NOTED  
Date September 27, 2002  
Title SUNSCREEN  
EXECUTIVE LEVEL

Sheet No. **A389**

FOR OFFICIAL USE ONLY