




**TYPICAL ELEVATION AT PERF. MTL. GUARDRAIL**  
SCALE: 1/2" = 1'-0"  
D-EXT-RAIL 33

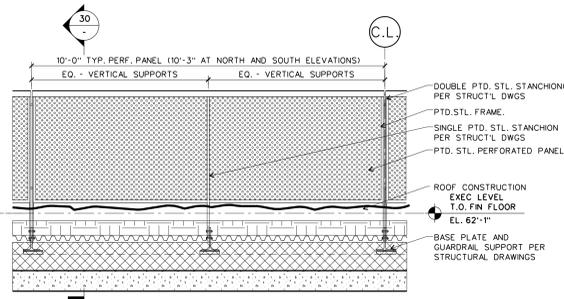


**TYPICAL SECTION/ELEVATION AT PERF. MTL. GUARDRAIL**  
SCALE: 1/2" = 1'-0"  
D-EXT-RAIL 33

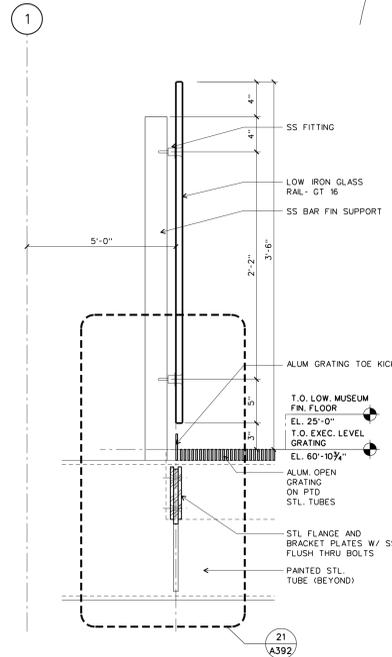


**SECTION AT POINT SUPPORTED GUARDRAIL**  
SCALE: 1/2" = 1'-0"  
D-EXT-RAIL 32

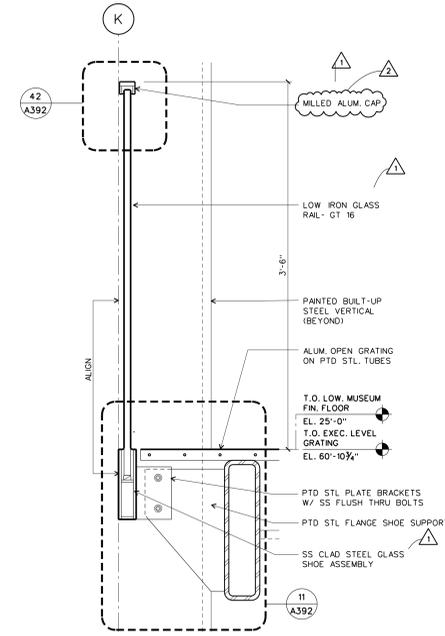


**SECTION AT GLASS GUARDRAIL SS SHOE**  
SCALE: 1/2" = 1'-0"  
D-EXT-RAIL 31

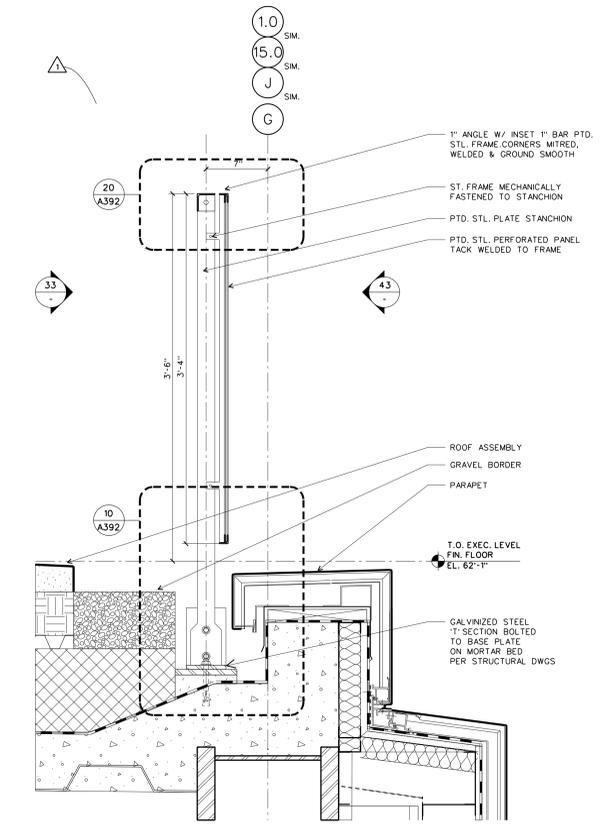


**SECTION DETAIL - PERF. MTL. GUARDRAIL**  
SCALE: 1/2" = 1'-0"  
D-EXT-RAIL 30

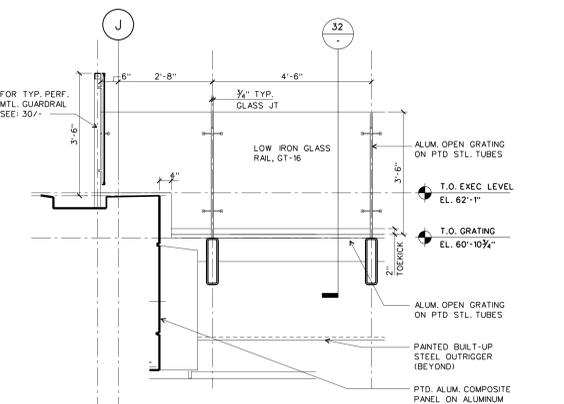


**PARTIAL ELEVATION AT EXEC. LVL.: POINT SUPPORT GLASS GUARDRAIL**  
SCALE: 1/2" = 1'-0"  
D-EXT-RAIL 22

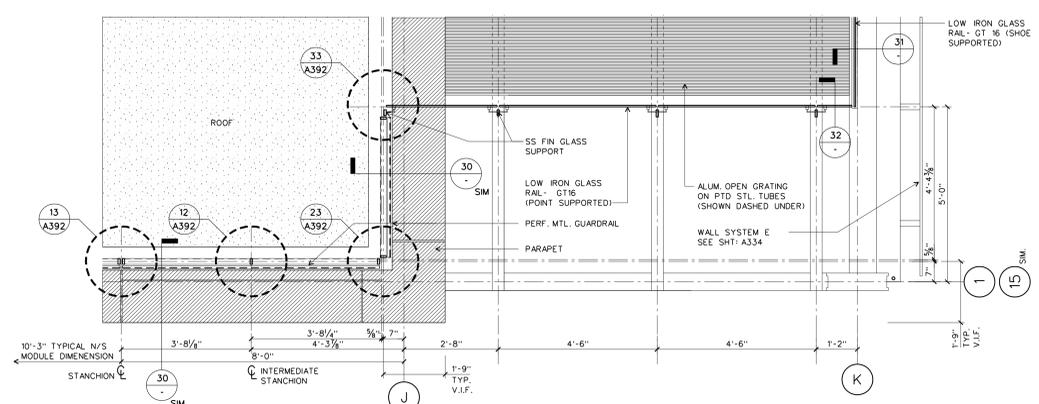


**PARTIAL EXEC. LEVEL ROOF PLAN: CORNER AT POINT SUPPORT GLASS GUARD**  
SCALE: 1/2" = 1'-0"  
D-EXT-RAIL 21

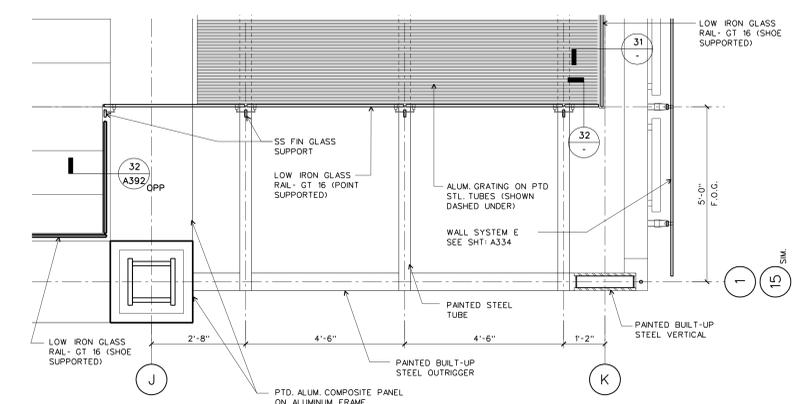

**PARTIAL LWR. MUS. LVL. PLAN: POINT SUPPORT GLASS GUARDRAIL**  
SCALE: 1/2" = 1'-0"  
D-EXT-RAIL 20

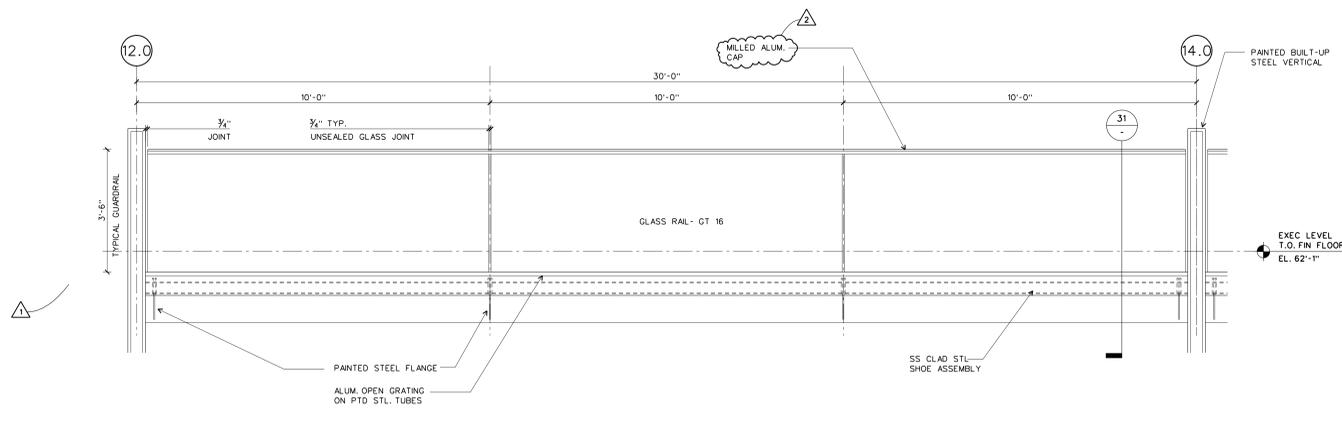

**TYPICAL ELEVATION: GLASS GUARD AT TERRACE WALKWAY COLUMN LINE 'K'**  
SCALE: 1/2" = 1'-0"  
D-EXT-RAIL 11

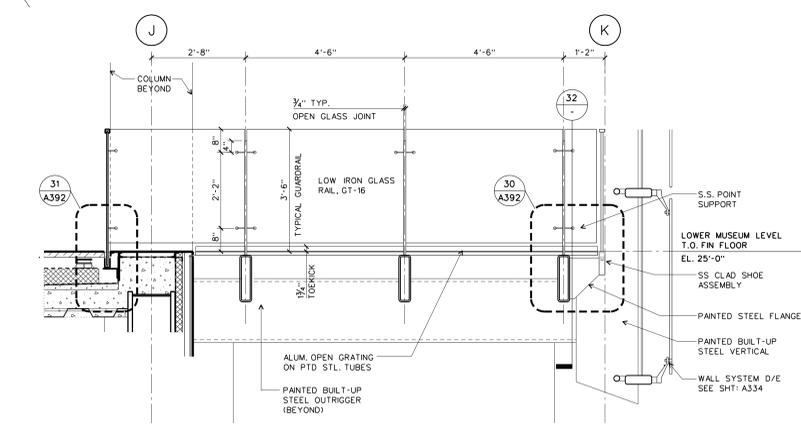

**ELEVATION: POINT SUPPORT GLASS GUARD**  
SCALE: 1/2" = 1'-0"  
D-EXT-RAIL 10