

**WILLIAM J. CLINTON
PRESIDENTIAL
CENTER**

LITTLE ROCK, ARKANSAS

Architect
POLISHEK PARTNERSHIP LLP
320 West 13th Street
New York, New York 10014
212.807.7171

Coordinating Architects
POLK STANLEY YEARY ARCHITECTS LTD
700 South Schiller Street
Little Rock, Arkansas 72201
501.378.0878

WITSELL EVANS RASCO
901 West Third Street
Little Rock, Arkansas 72201
501.374.5300

WOODS CARADINE ARCHITECTS
2200 South Main Street
Little Rock, Arkansas 72206
501.374.4960

Landscape Architects
HARGREAVES ASSOCIATES
118 Magazine Street
Cambridge, Massachusetts 02139
617.661.0070

LANDSCAPE ARCHITECTURE, Inc.
2300 Cottondale Lane Suite 202
Little Rock, Arkansas 72202
501.374.5610

Structural Engineer
LESLIE E. ROBERTSON ASSOC., RLLP
30 Broad Street, 47th Floor
New York, New York 10004
212.750.9000


MEP Engineers
FLACK + KURTZ, Inc.
475 Fifth Avenue
New York, New York 10017
212.532.9600

CROMWELL ARCHITECTS ENGINEERS
101 South Spring Street
Little Rock, Arkansas 72201
501.372.2900

Curtainwall Consultant
R. A. HEINTGES ARCHITECTS
126 Fifth Avenue, 9th Floor
New York, New York 10011
212.652.2968

Seal

△ Addendum #2	11/15/02
100% Construction Documents	09/27/02
90% Progress Printing	08/30/02
100% Struct. CD Progress	07/01/02
100% Design Development	03/01/02
Issue	Date

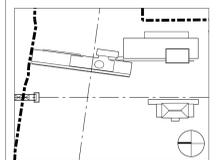

Job No. 9908

Scale AS NOTED

Date September 27, 2002


Title

PARTITION TYPES


Sheet No.

A400


FOR OFFICIAL USE ONLY

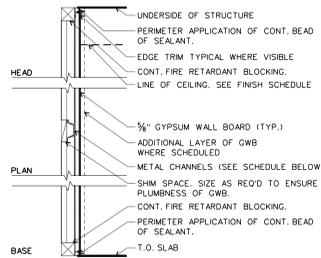


TYPE	STUD SIZE	MAX. HEIGHT	INSUL.	FIRE RATING	REMARKS
FOO	VARIES 1/2" - 3/4" 24" O.C.	N/A	N/A	N/A	--
FO2	VARIES 1/2" - 3/4" 24" O.C.	N/A	N/A	N/A	--

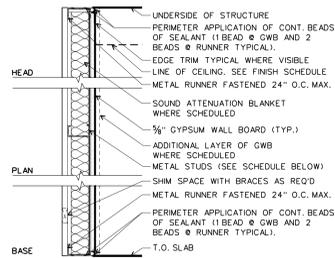


TYPE	STUD SIZE	MAX. HEIGHT	INSUL.	FIRE RATING	REMARKS
E00	VARIES 1 1/2" - 2" 24" O.C.	8'-3"	25	N/A	N/A
E02	VARIES 1 1/2" - 2" 24" O.C.	8'-3"	25	N/A	N/A
E04	VARIES 1 1/2" - 2" 24" O.C.	8'-3"	25	N/A	N/A
E10	VARIES 1 1/2" - 2" 24" O.C.	11'-0"	20	N/A	N/A
E12	VARIES 1 1/2" - 2" 24" O.C.	11'-0"	20	N/A	N/A
E14	VARIES 1 1/2" - 2" 24" O.C.	11'-0"	20	N/A	N/A
E20	VARIES 1 1/2" - 2" 24" O.C.	14'-6"	20	N/A	N/A
E22	VARIES 1 1/2" - 2" 24" O.C.	14'-6"	20	N/A	N/A
E24	VARIES 1 1/2" - 2" 24" O.C.	14'-6"	20	N/A	N/A
E30	VARIES 1 1/2" - 2" 24" O.C.	20'-0"	20	N/A	N/A
E32	VARIES 1 1/2" - 2" 24" O.C.	20'-0"	20	N/A	N/A
E34	VARIES 1 1/2" - 2" 24" O.C.	20'-0"	20	N/A	N/A

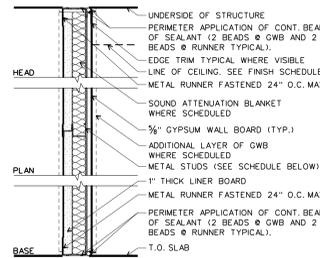


TYPE	STUD SIZE	MAX. HEIGHT	INSUL.	FIRE RATING	REMARKS
D00	VARIES 1 1/2" - 2" 24" O.C.	+14'-0"	20	42	1 HOUR U469
D02	VARIES 1 1/2" - 2" 24" O.C.	+15'-3"	20	45	2 HOUR U438
D04	VARIES 1 1/2" - 2" 24" O.C.	+15'-3"	20	45	2 HOUR U467
D10	VARIES 1 1/2" - 2" 24" O.C.	+17'-6"	20	52	1 HOUR U469
D12	VARIES 1 1/2" - 2" 24" O.C.	+18'-2"	20	52	2 HOUR U438
D14	VARIES 1 1/2" - 2" 24" O.C.	+18'-2"	20	52	2 HOUR U467
D20	VARIES 1 1/2" - 2" 24" O.C.	+24'-3"	20	52	1 HOUR U469
D22	VARIES 1 1/2" - 2" 24" O.C.	+25'-1"	20	52	2 HOUR U438
D24	VARIES 1 1/2" - 2" 24" O.C.	+25'-1"	20	52	2 HOUR U467

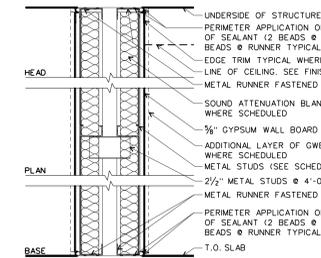

TYPE	STUD SIZE	MAX. HEIGHT	INSUL.	FIRE RATING	REMARKS
C00	VARIES 1 1/2" - 2" 24" O.C.	13'-3"	25	52	N/A
C02	VARIES 1 1/2" - 2" 24" O.C.	13'-3"	25	52	1 HOUR U420
C04	VARIES 1 1/2" - 2" 24" O.C.	14'-6"	25	57	2 HOUR U420
C10	VARIES 1 1/2" - 2" 24" O.C.	17'-6"	20	52	N/A
C12	VARIES 1 1/2" - 2" 24" O.C.	17'-6"	20	52	1 HOUR U420
C14	VARIES 1 1/2" - 2" 24" O.C.	19'-0"	20	57	2 HOUR U420
C20	VARIES 1 1/2" - 2" 24" O.C.	22'-9"	20	52	N/A
C22	VARIES 1 1/2" - 2" 24" O.C.	22'-9"	20	52	1 HOUR U420
C24	VARIES 1 1/2" - 2" 24" O.C.	23'-6"	20	57	2 HOUR U420

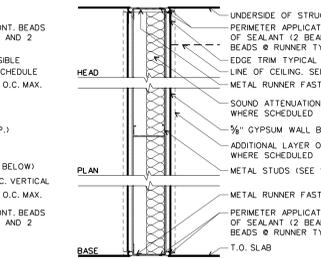

TYPE	STUD SIZE	MAX. HEIGHT	INSUL.	FIRE RATING	REMARKS
B00	VARIES 1 1/2" - 2" 24" O.C.	13'-0"	20	N/A	N/A
B02	VARIES 1 1/2" - 2" 24" O.C.	13'-10"	20	45	N/A
B04	VARIES 1 1/2" - 2" 24" O.C.	13'-10"	20	45	1 HOUR U411
B06	VARIES 1 1/2" - 2" 24" O.C.	16'-1"	20	55	2 HOUR U411
B10	VARIES 1 1/2" - 2" 24" O.C.	17'-3"	20	N/A	N/A
B12	VARIES 1 1/2" - 2" 24" O.C.	17'-11"	20	47	N/A
B14	VARIES 1 1/2" - 2" 24" O.C.	17'-11"	20	47	1 HOUR U465
B16	VARIES 1 1/2" - 2" 24" O.C.	17'-11"	20	50	1 1/2 HR 13240
B18	VARIES 1 1/2" - 2" 24" O.C.	20'-2"	20	53	2 HOUR U411
B20	VARIES 1 1/2" - 2" 24" O.C.	25'-6"	20	N/A	N/A
B22	VARIES 1 1/2" - 2" 24" O.C.	26'-1"	20	47	N/A
B24	VARIES 1 1/2" - 2" 24" O.C.	26'-1"	20	47	1 HOUR U465
B26	VARIES 1 1/2" - 2" 24" O.C.	26'-1"	20	50	1 1/2 HR 13240
B28	VARIES 1 1/2" - 2" 24" O.C.	28'-6"	20	53	2 HOUR U411
B30	VARIES 1 1/2" - 2" 24" O.C.	28'-6"	20	53	4 HOUR U419
B32	VARIES 1 1/2" - 2" 24" O.C.	20'-2"	20	53	3 HOUR U420
B34	VARIES 1 1/2" - 2" 24" O.C.	2 FLRS 6"	20	N.A.	N.A.

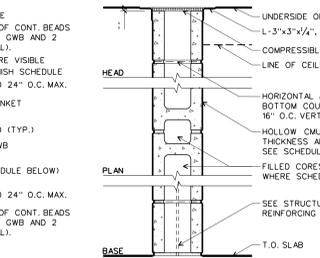


TYPE	NOMINAL SIZE	MAX. HEIGHT	INSUL.	FIRE RATING	REMARKS
A00	4"	12'-0"	N/A	N/A	NON-LOAD BEARING
A10	6"	18'-0"	N/A	N/A	NON-LOAD BEARING
A12	6"	18'-0"	N/A	N/A	1 HOUR U906
A14	6"	18'-0"	N/A	N/A	2 HOUR U906
A20	8"	24'-0"	N/A	N/A	NON-LOAD BEARING
A22	8"	24'-0"	N/A	N/A	1 HOUR U905
A24	8"	24'-0"	N/A	N/A	2 HOUR U905
A26	8"	24'-0"	N/A	N/A	3 HOUR U904
A28	8"	24'-0"	N/A	N/A	4 HOUR U901

GENERAL NOTES

- SEE PARTITION DETAIL DRAWING XXXX AND PROJECT SPECIFICATIONS FOR SEISMIC DETAILS AND PERFORMANCE CRITERIA FOR ALL STUD AND MASONRY PARTITIONS.
- INSTALL CEMENTITIOUS BACKER BOARD IN LIEU OF GYPSUM WALL BOARD AT LOCATIONS INDICATED TO RECEIVE WALL TILE.
- INSTALL WATER RESISTANT GYPSUM WALL BOARD AT SURFACES IN TOILET ROOMS, JANITORS CLOSETS AND SIMILAR WET AREAS NOT INDICATED TO RECEIVE WALL TILE.
- INSTALL TYPE "X" FIRE RATED GWB AT ALL FIRE RATED PARTITIONS.
- INSTALL "BLUEBOARD" GYPSUM WALL BOARD AT PARTITIONS INDICATED TO RECEIVE VENER PLASTER.
- STC RATINGS PROVIDE ONLY A GENERAL INDICATION OF ACOUSTIC PERFORMANCE UNDER LABORATORY TEST CONDITIONS. CONSTRUCTION DETAILS DESCRIBED IN THE DRAWINGS AND SPECIFICATIONS DEFINE THE SPECIFIC REQUIREMENTS FOR THE WORK.
- EXTRA LAYER OF GYPSUM WALL BOARD AT ASYMMETRICAL PARTITIONS IS TO BE INSTALLED ON SIDE OF PARTITION WHICH TYPE KEY IS SHOWN.

F APPLIED FURRING
SCALE: 1/2" = 1'-0"

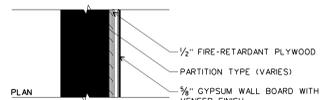

GW ADDITIONAL CONSTRUCTION FOR GALLERY WALL TYPES
SCALE: 1/2" = 1'-0"

E FURRING WALL
SCALE: 1/2" = 1'-0"

D SHAFT WALL
SCALE: 1/2" = 1'-0"

C CHASE WALL
SCALE: 1/2" = 1'-0"

B STUD WALL
SCALE: 1/2" = 1'-0"

A CMU WALL
SCALE: 1/2" = 1'-0"