



AS1 #25	12/19/03
AS1 #24	10/24/03
AS1 #20	09/06/03
100% Construction Documents/09/27/02	
Issue	Date
*New Sheet. Former A402 renamed A401	

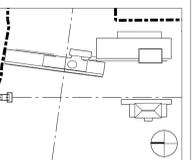


Job No.	9908
Scale	AS NOTED
Date	September 27, 2002
Title	

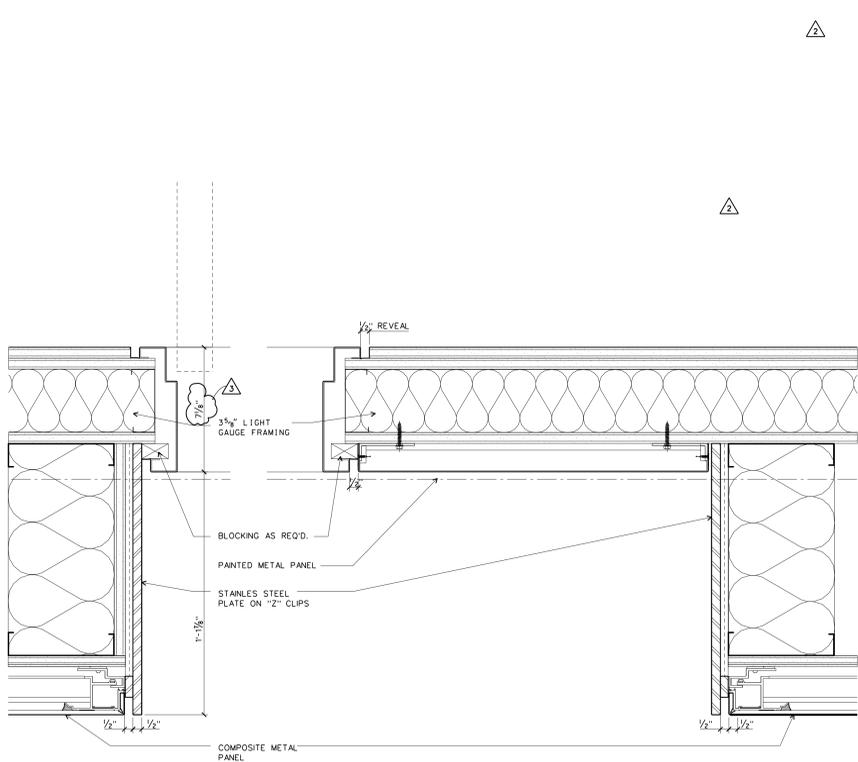

**JAMB DETAIL GREEN ROOM**

3" x 1'-0"

D-doors.dgn 23

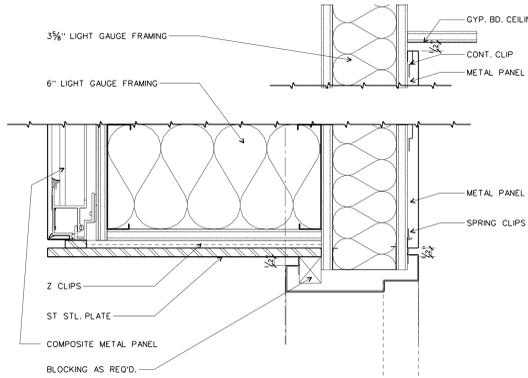

**HEAD DETAIL**

3" x 1'-0"

D-doors.dgn 32

**JAMB DETAIL (HEAD SIM.)**


3" x 1'-0"

D-doors.dgn 31

**JAMB DETAIL (HEAD SIM.)**

3" x 1'-0"


D-doors.dgn 30

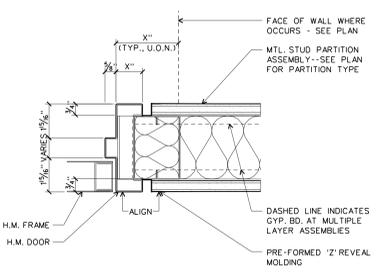

**JAMB DETAIL (HEAD SIM.)**

3" x 1'-0"

D-doors.dgn 22

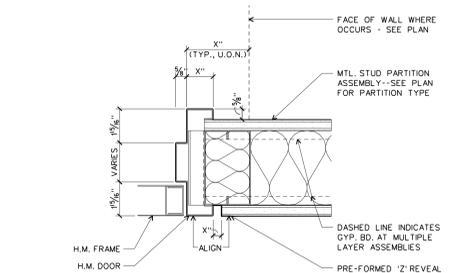


**JAMB DETAIL (HEAD SIM.)**

3" x 1'-0"

D-doors.dgn 21


21.B

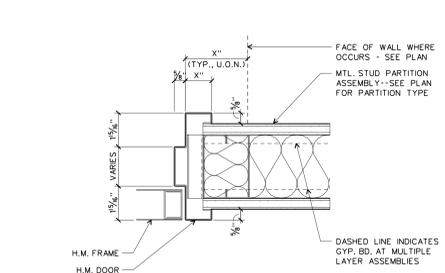

**JAMB DETAIL (HEAD SIM.)**

3" x 1'-0"


D-doors.dgn 20

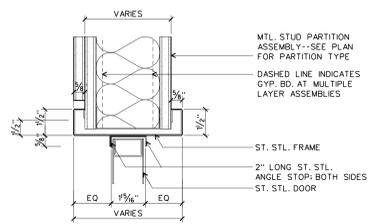

**HEAD DETAIL  
DOUBLE ACTING DOOR**

SCALE: 3" x 1'-0"


D-doors.dgn 14

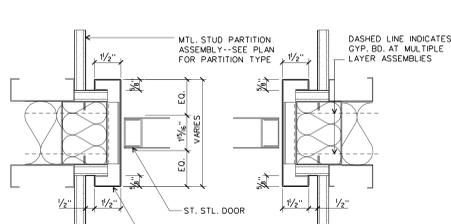

**JAMB DETAIL  
DOUBLE ACTING DOOR**

SCALE: 3" x 1'-0"


D-doors.dgn 13

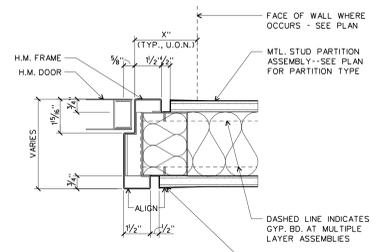

**JAMB DETAIL (HEAD SIM)  
FLUSH BOTH SIDERS**

SCALE: 3" x 1'-0"


D-doors.dgn 12

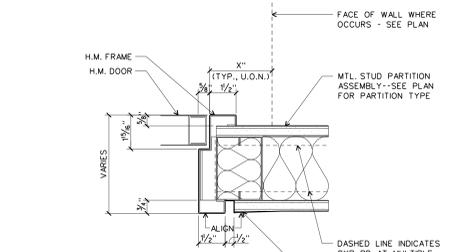

**JAMB DETAIL (HEAD SIM)  
FLUSH ONE SIDERS**

SCALE: 3" x 1'-0"

D-doors.dgn 11

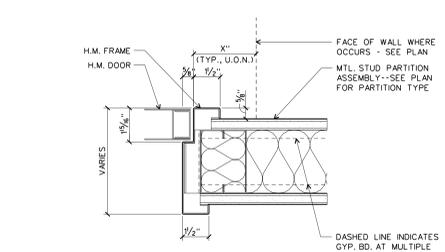

**JAMB DETAIL (HEAD SIM)**

SCALE: 3" x 1'-0"

D-doors.dgn 10