

**WILLIAM J. CLINTON
PRESIDENTIAL
CENTER**

LITTLE ROCK, ARKANSAS

Architect
POLSHEK PARTNERSHIP LLP
320 West 13th Street
New York, New York 10014
212.807.7171

Coordinating Architects
POLK STANLEY YEARY ARCHITECTS LTD
700 South Schiller Street
Little Rock, Arkansas 72201
501.378.0878

WITSELL EVANS RASCO
901 West Third Street
Little Rock, Arkansas 72201
501.374.5300

WOODS CARADINE ARCHITECTS
2200 South Main Street
Little Rock, Arkansas 72206
501.374.4960

Landscape Architects
HARGREAVES ASSOCIATES
118 Magazine Street
Cambridge, Massachusetts 02139
617.661.0070

Landscape Architecture, Inc.
2300 Cottondale Lane Suite 202
Little Rock, Arkansas 72202
501.374.5810

Structural Engineer
LESLIE E. ROBERTSON ASSOC., RLLP
30 Broad Street, 47th Floor
New York, New York 10004
212.750.9000

MEP Engineers
FLACK + KURTZ, Inc.
475 Fifth Avenue
New York, New York 10017
212.532.9600

CROMWELL ARCHITECTS ENGINEERS
101 South Spring Street
Little Rock, Arkansas 72201
501.372.2900

Curtainwall Consultant
R. A. HEINTGES ARCHITECTS
126 Fifth Avenue, 9th Floor
New York, New York 10011
212.652.2968

Seal


| | |
|-----------------------------|----------|
| ▲ ASI # 24 | 10/24/03 |
| ▲ ASI # 23 | 09/12/03 |
| ▲ ASI # 20 | 08/06/03 |
| ▲ Addendum #4 | 11/22/02 |
| 100% Construction Documents | 09/27/02 |
| 90% Progress Printing | 08/30/02 |
| Issue | Date |

Job No. 9908
Scale AS NOTED
Date September 27, 2002
Title


DOOR DETAILS

Sheet No. **A403**


FOR OFFICIAL USE ONLY

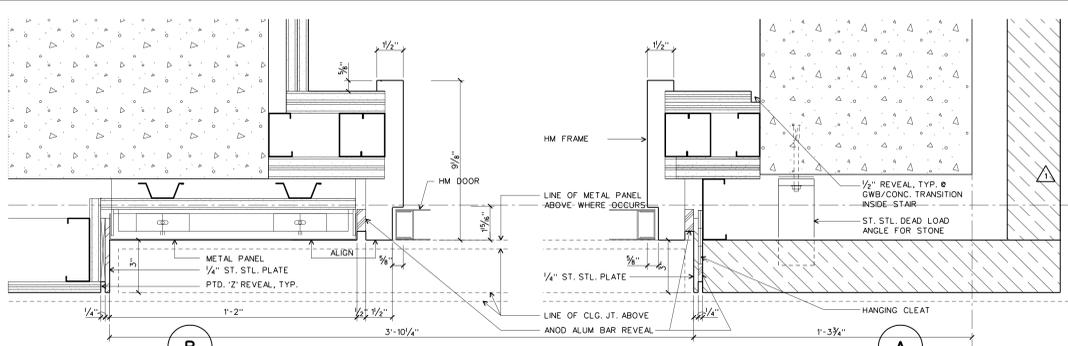


JAMB DETAIL - STAIR 4 AT GROUND LEVEL
SCALE: 3" = 1'-0"

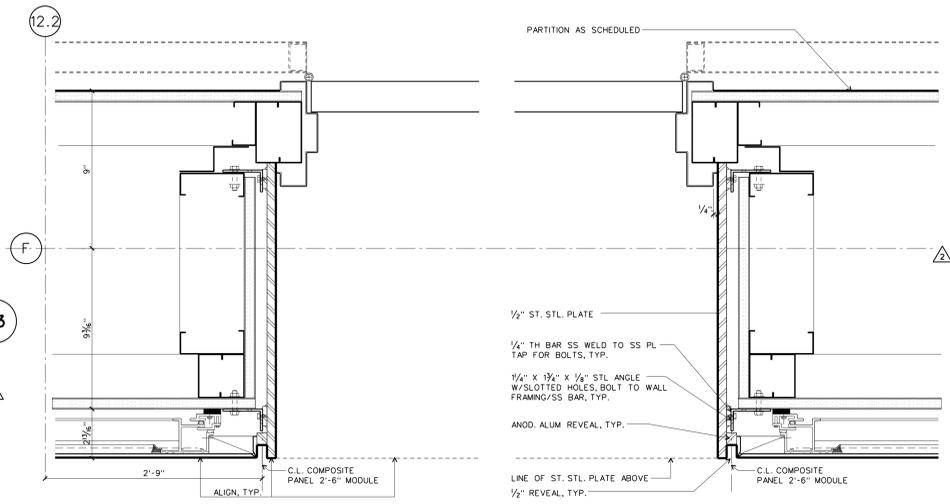


JAMB DETAIL FREIGHT ELEV. VEST.
SCALE: 3" = 1'-0"

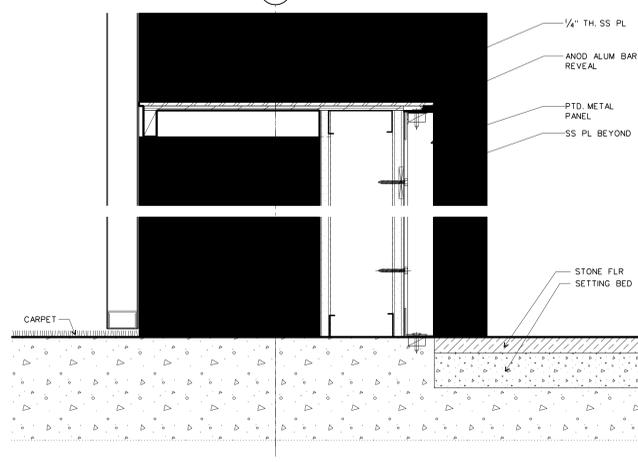


SHELF/SILL DETAIL COAT ROOM
SCALE: 3" = 1'-0"

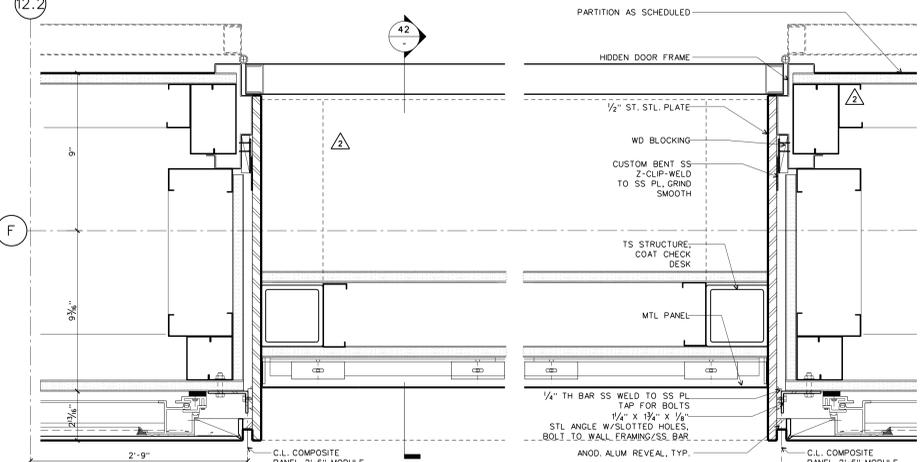


JAMB DETAIL COAT ROOM: HEAD SIM
SCALE: 3" = 1'-0"

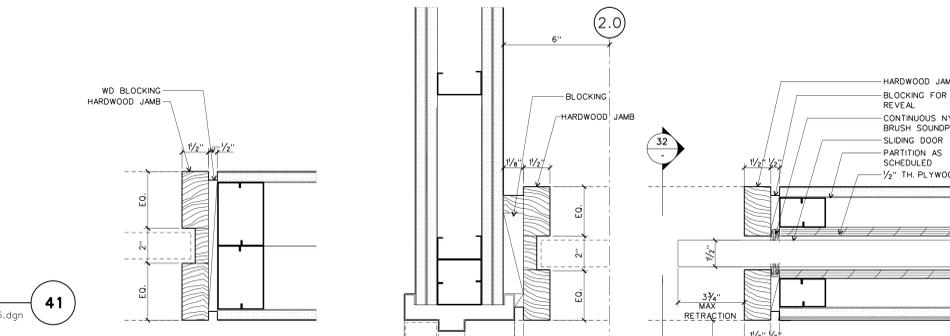


JAMB ALT.
SCALE: 3" = 1'-0"

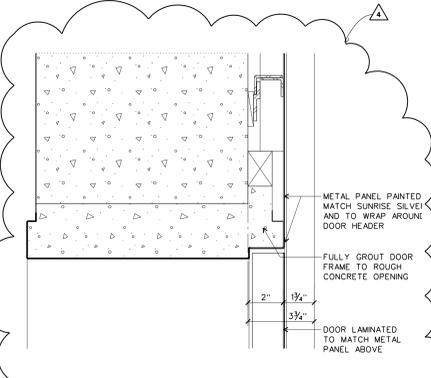


STAIR 5 DOOR HEAD DETAIL

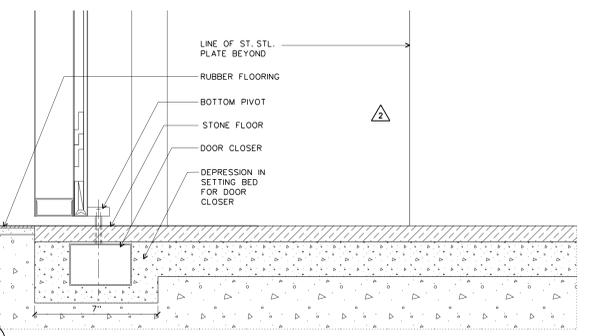


SILL DETAIL FREIGHT ELEV VEST (HEAD SEE 43/A451)

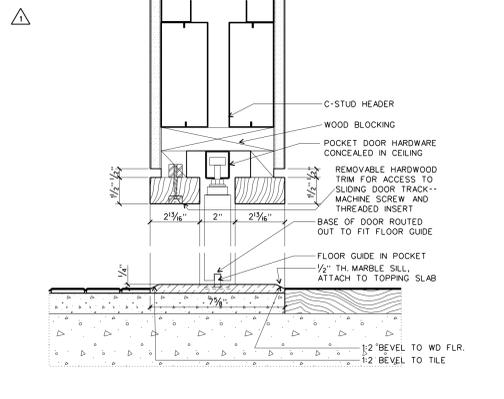


HEAD/SILL DETAIL POCKET DOOR

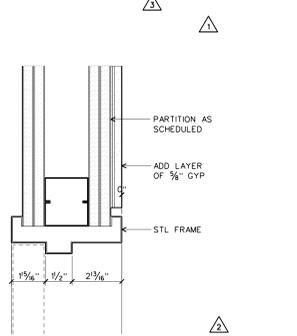


HEAD DETAIL STAIR 2

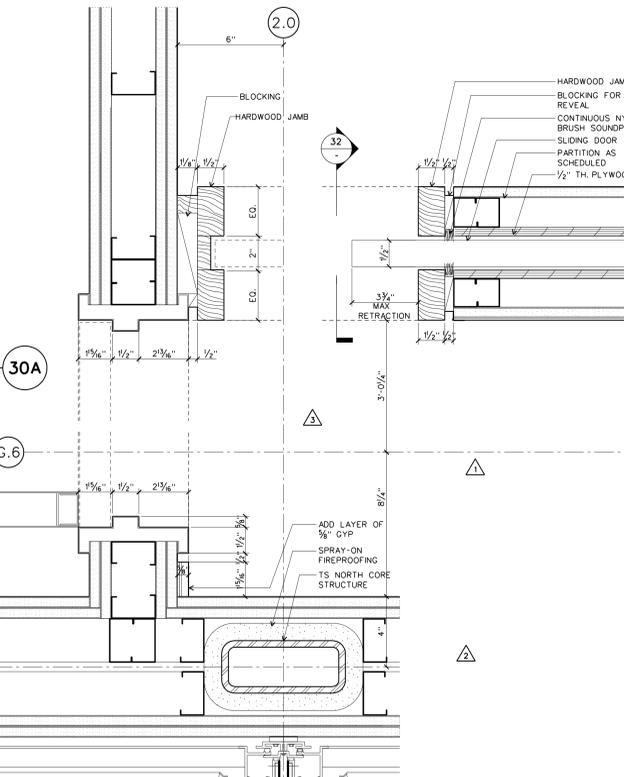


JAMB DETAIL POCKET DOOR (NORTH CORE BATHROOM)

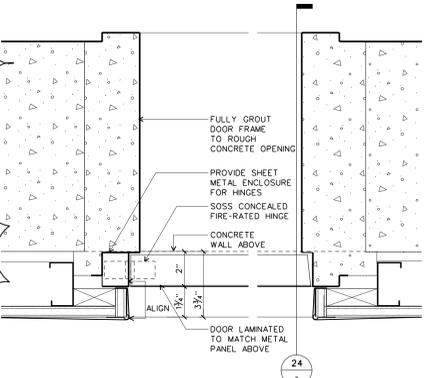

STAIR 5 DOOR JAMB DETAIL

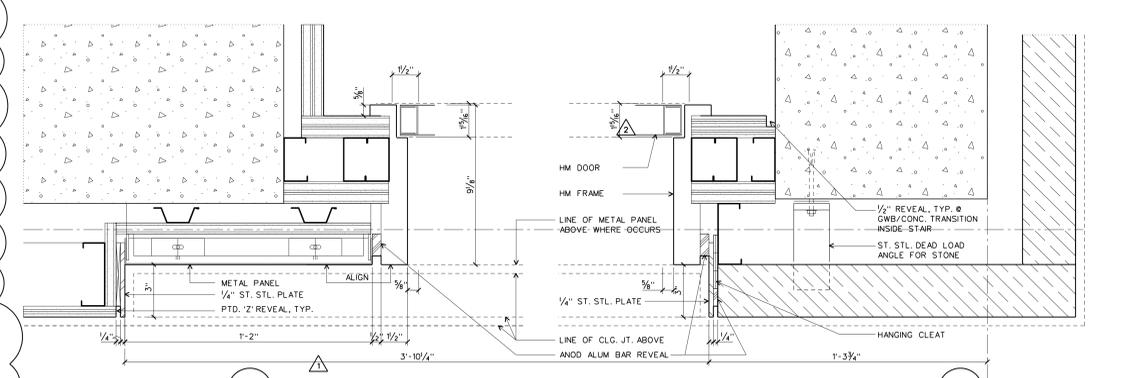

JAMB DETAIL - STAIR 4: HEAD SIM.

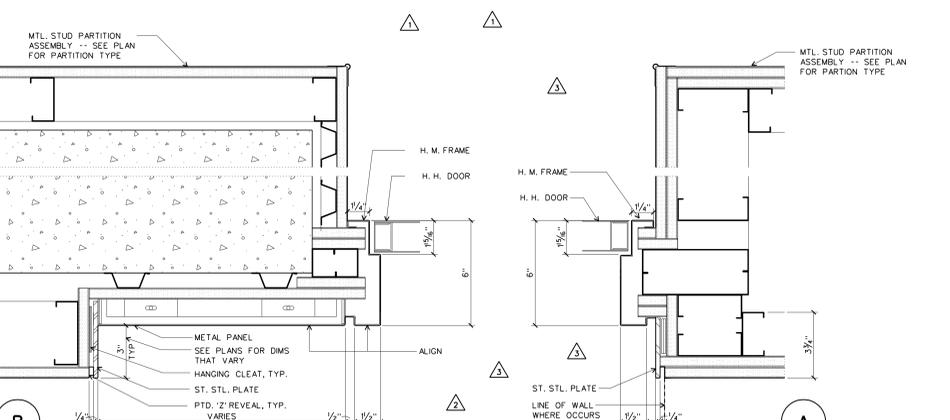

JAMB DETAIL - STAIR 6: & MECH. DOOR, HEAD SIM.