

**WILLIAM J. CLINTON
PRESIDENTIAL
CENTER**

LITTLE ROCK, ARKANSAS

Architect

POLSKHEK PARTNERSHIP LLP
320 West 13th Street
New York, New York 10014
212.807.7171

Coordinating Architects

POLK STANLEY YEARY ARCHITECTS LTD
700 South Schiller Street
Little Rock, Arkansas 72201
501.378.0878

WITSELL EVANS RASCO
901 West Third Street
Little Rock, Arkansas 72201
501.374.5300

WOODS CARADINE ARCHITECTS
2200 South Main Street
Little Rock, Arkansas 72206
501.374.4060

Landscape Architects

HARGREAVES ASSOCIATES
118 Magazine Street
Cambridge, Massachusetts 02139
617.661.0070

LANDSCAPE ARCHITECTURE, Inc.
2300 Cottondale Lane Suite 202
Little Rock, Arkansas 72202
501.374.5810

Structural Engineer

LESLIE E. ROBERTSON ASSOC., RLLP
30 Broad Street, 47th Floor
New York, New York 10004
212.750.9000

MEP Engineers

FLACK + KURTZ, Inc.
475 Fifth Avenue
New York, New York 10017
212.532.9600


CROMWELL ARCHITECTS ENGINEERS
101 South Spring Street
Little Rock, Arkansas 72201
501.372.2900

Curtainwall Consultant

R. A. HEINTGES ARCHITECTS
126 Fifth Avenue, 9th Floor
New York, New York 10011
212.652-2968

Seal

ASI #23	09/12/03
ASI #20	08/06/03
Addendum #2	01/11/02
100% Construction Documents 09/27/02	
Issue	Date
*New Sheet. Former A407 renamed A409	

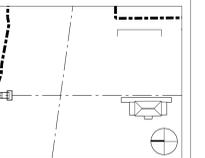

Job No. 9908

Scale AS NOTED

Date September 27, 2002


Title

SILL DETAILS


Sheet No.

A407


FOR OFFICIAL USE ONLY

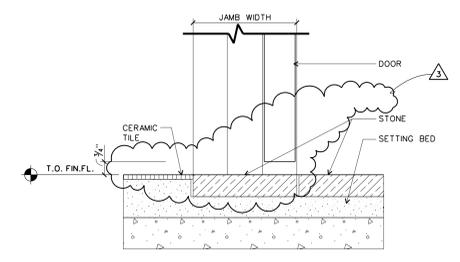


SILL DETAIL - CERAMIC TILE/STONE
SCALE: 3" = 1'-0"
d-door02.dgn **40**

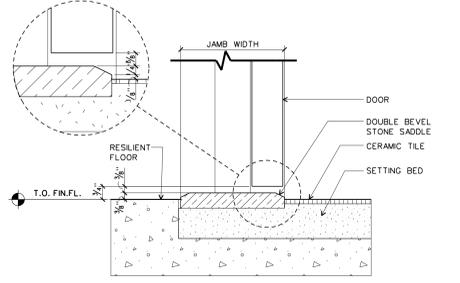


SILL DETAIL - RUBBER FL./CERAMIC TILE
SCALE: 3" = 1'-0"
d-door02.dgn **41**

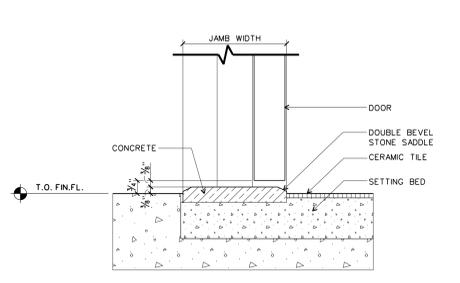


SILL DETAIL - CONCRETE/CERAMIC TILE
SCALE: 3" = 1'-0"
d-door02.dgn **42**

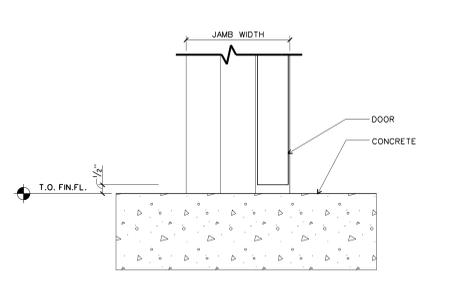


SILL DETAIL - CONCRETE/CONCRETE
SCALE: 3" = 1'-0"
d-door02.dgn **43**

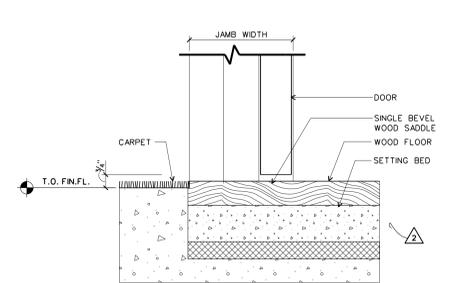


SILL DETAIL - CARPET/WOOD FLOOR
SCALE: 3" = 1'-0"
d-door02.dgn **44**

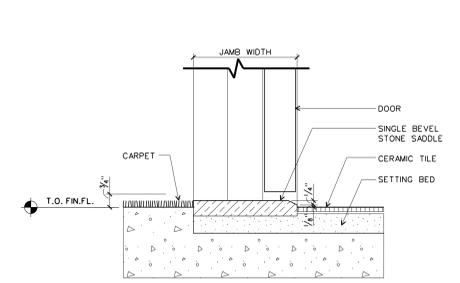


SILL DETAIL - CARPET/CERAMIC TILE
SCALE: 3" = 1'-0"
d-door02.dgn **30**

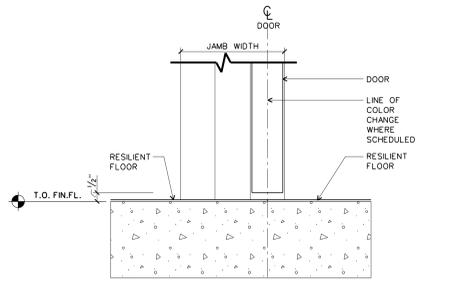


SILL DETAIL - RUBBER FL./RUBBER FL.
SCALE: 3" = 1'-0"
d-door02.dgn **31**

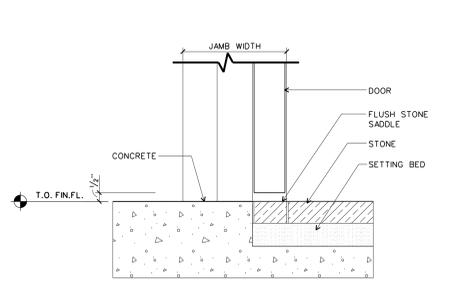


SILL DETAIL - CONCRETE/STONE
SCALE: 3" = 1'-0"
d-door02.dgn **32**

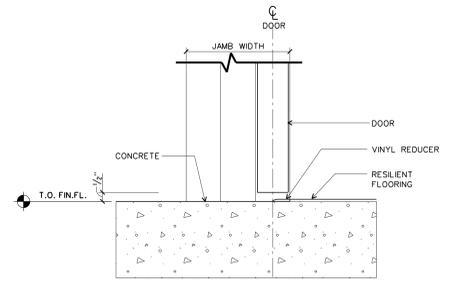


SILL DETAIL - CONCRETE/RUBBER FLOORING
SCALE: 3" = 1'-0"
d-door02.dgn **33**

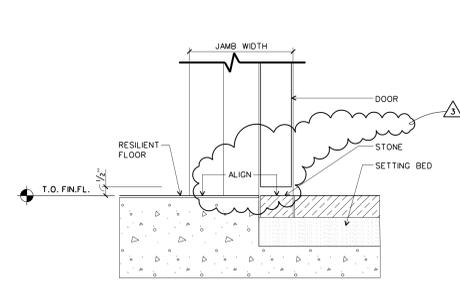


SILL DETAIL - RUBBER FL./STONE
SCALE: 3" = 1'-0"
d-door02.dgn **34**

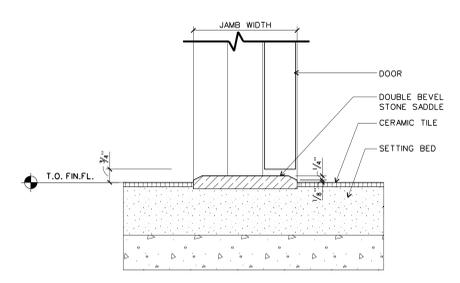


SILL DETAIL - CERAMIC TILE/CERAMIC TILE
SCALE: 3" = 1'-0"
d-door02.dgn **20**

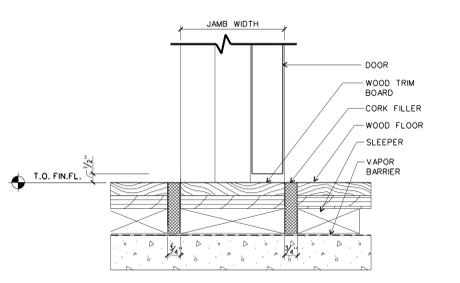


SILL DETAIL - WOOD/WOOD
SCALE: 3" = 1'-0"
d-door02.dgn **21**

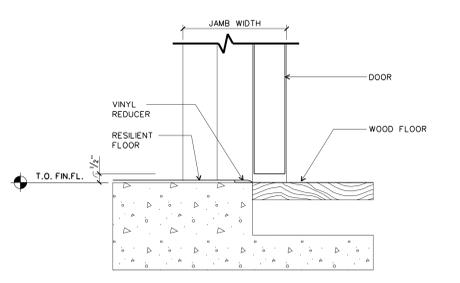


SILL DETAIL - RUBBER FL./WOOD FL.
SCALE: 3" = 1'-0"
d-door02.dgn **22**

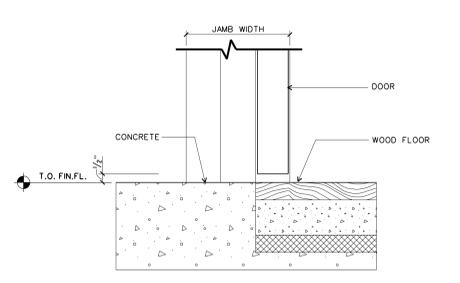


SILL DETAIL - CONCRETE/WOOD FLOOR
SCALE: 3" = 1'-0"
d-door02.dgn **23**

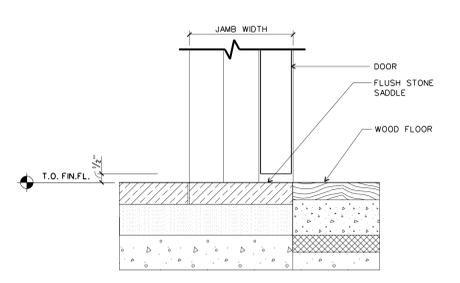


SILL DETAIL - WOOD/STONE
SCALE: 3" = 1'-0"
d-door02.dgn **24**

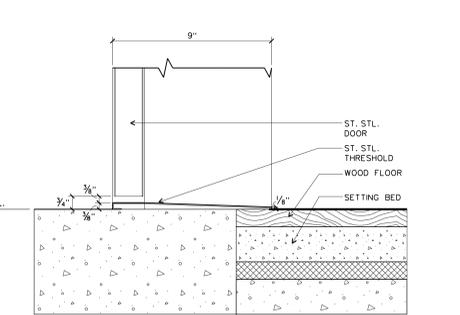


SILL DETAIL - STAIR 4,5
SCALE: 3" = 1'-0"
d-door02.dgn **10**

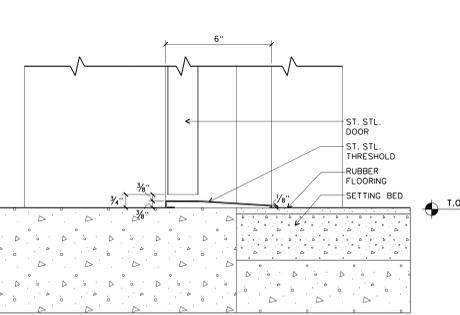


SILL DETAIL - STAIR 4,5
SCALE: 3" = 1'-0"
d-door02.dgn **11**

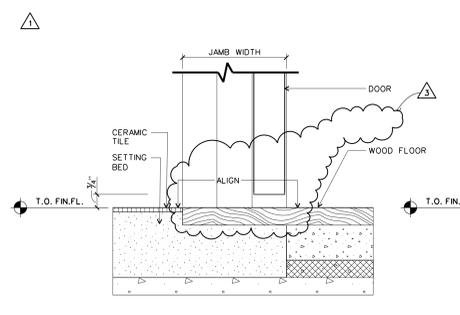

SILL DETAIL - CERAMIC TILE/WOOD
SCALE: 3" = 1'-0"
d-door02.dgn **12**

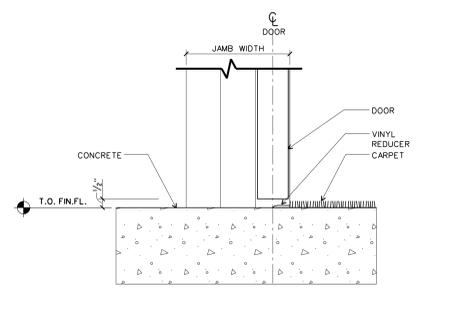

SILL DETAIL - CONCRETE/CARPET
SCALE: 3" = 1'-0"
d-door02.dgn **13**

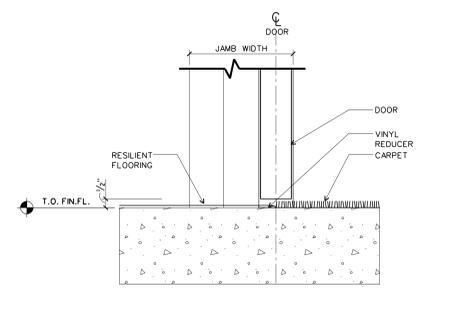

SILL DETAIL - RUBBER FLOORING/CARPET
SCALE: 3" = 1'-0"
d-door02.dgn **14**