




CARPET AT OVAL OFFICE

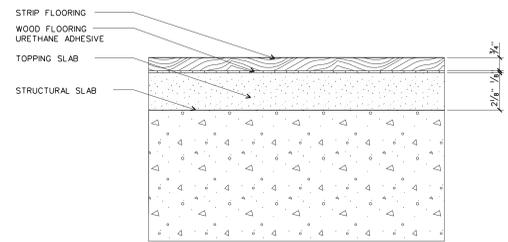


WOOD FLOORING - SOLID LUMBER

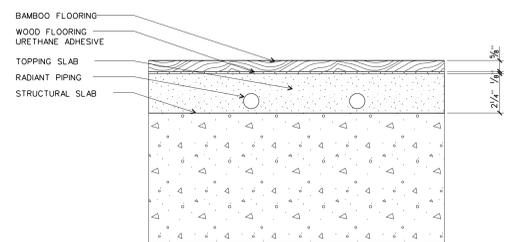


WOOD FLOORING - BAMBOO

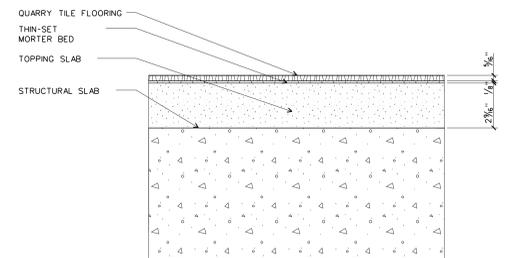


QUARRY TILE

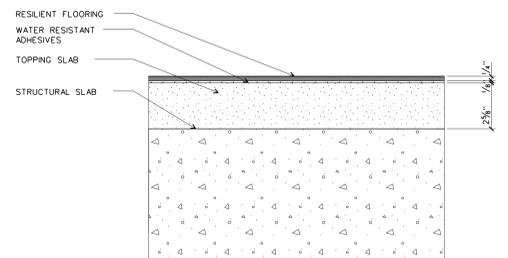


RESILIENT FLOORING

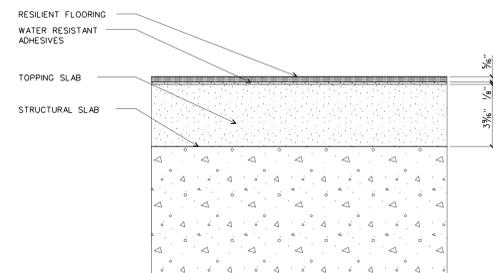


RESILIENT FLOORING

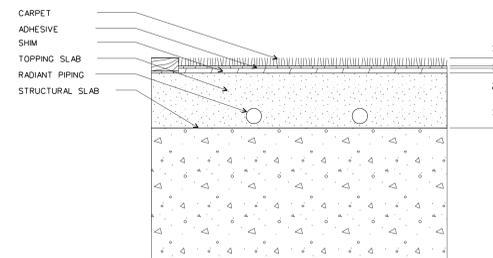


CARPET AT CABINET ROOM

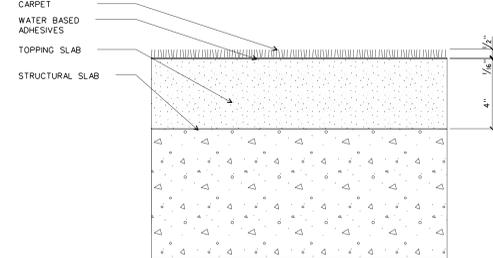


CARPET AT ORIENTATION THEATER

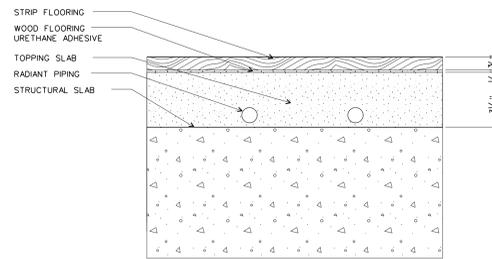


WOOD FLOORING - SOLID LUMBER

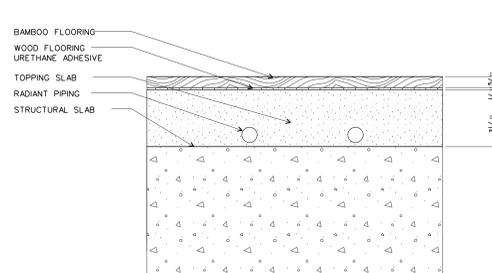


WOOD FLOORING - BAMBOO

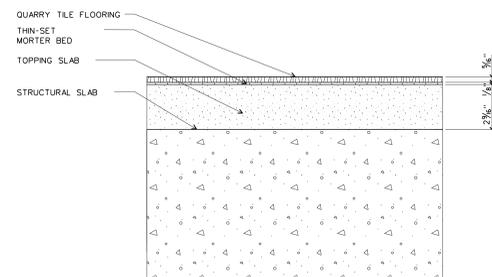


QUARRY TILE

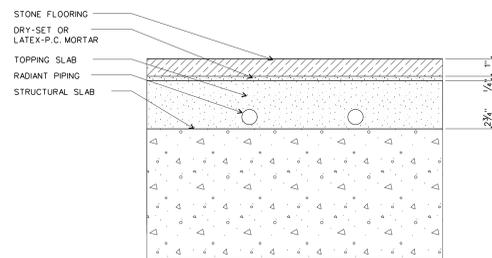


STONE FLOORING

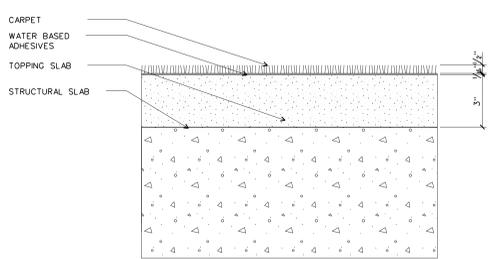


CARPET

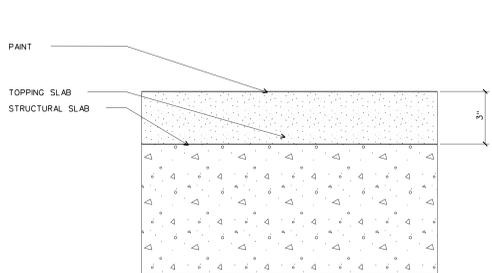

CONCRETE

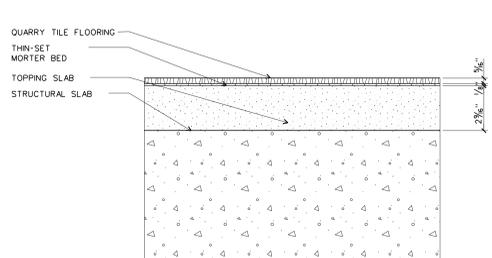

QUARRY TILE

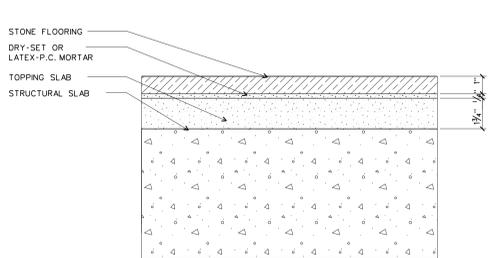

STONE FLOORING