


Issue	Date
100% Construction Documents	09/27/02
90% Progress Printing	08/30/02
100% Struct./ CD Progress	07/01/02
100% Steel & Concrete CD	05/15/02
& Architectural CD Progress	
100% Design Development	03/01/02

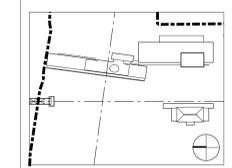


Job No. 9908
Scale 1/4" = 1'-0"
Date September 27, 2002
Title

**MUSEUM BUILDING
INTERIOR ELEVATIONS:
BASEMENT**

Sheet No.

A411

FOR OFFICIAL USE ONLY

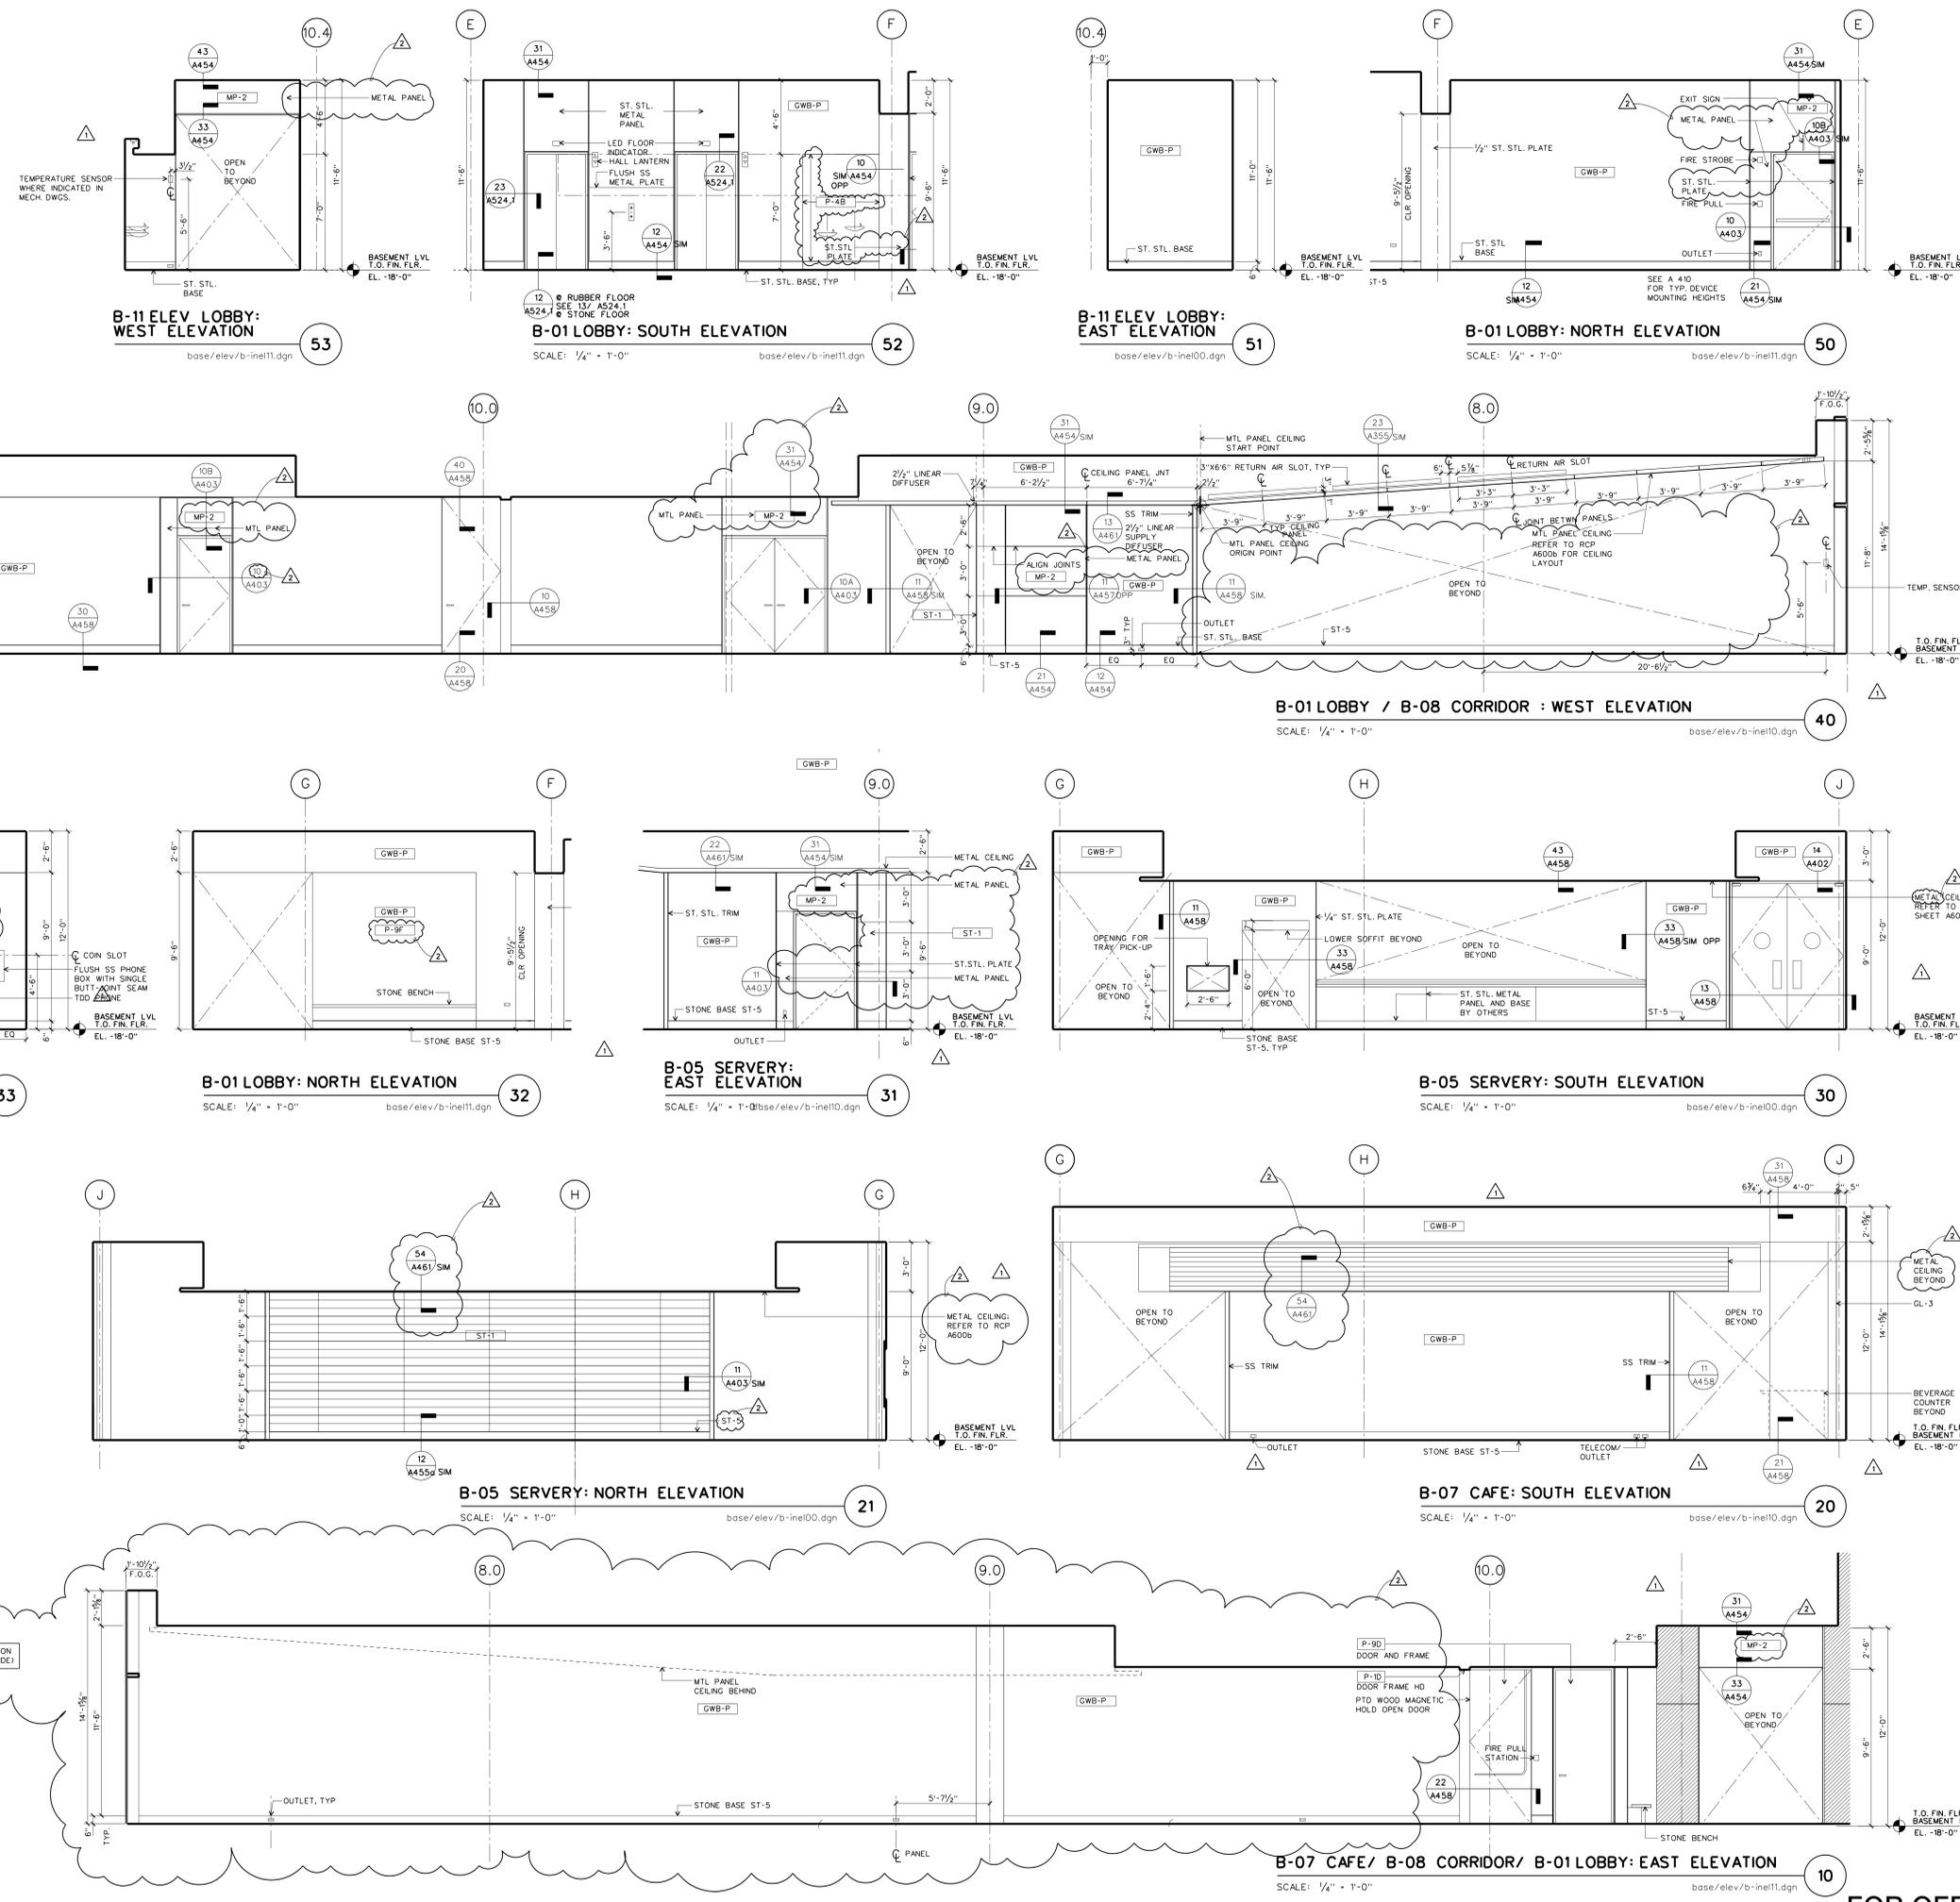

SEE SHEET 206 FOR EAST & WEST ELEVATION EXTERIOR WALL(S) AND DOOR(S) (TERRACE SIDE)