

**WILLIAM J. CLINTON  
PRESIDENTIAL  
CENTER**

LITTLE ROCK, ARKANSAS

Architect  
**POLSHKE PARTNERSHIP LLP**  
320 West 13th Street  
New York, New York 10014  
212.807.7171

Coordinating Architects  
**POLK STANLEY YEARY ARCHITECTS Ltd**  
700 South Schiller Street  
Little Rock, Arkansas 72201  
501.378.0878

**WITSELL EVANS RASCO**  
901 West Third Street  
Little Rock, Arkansas 72201  
501.374.5300

**WOODS CARADINE ARCHITECTS**  
2200 South Main Street  
Little Rock, Arkansas 72206  
501.374.4060

Landscape Architects  
**HARGREAVES ASSOCIATES**  
118 Magazine Street  
Cambridge, Massachusetts 02139  
617.661.0070

**LANDSCAPE ARCHITECTURE, Inc.**  
2300 Cottondale Lane Suite 202  
Little Rock, Arkansas 72202  
501.374.5810

Structural Engineer  
**LESLIE E. ROBERTSON ASSOC., RLLP**  
30 Broad Street, 47th Floor  
New York, New York 10004  
212.750.9000


MEP Engineers  
**FLACK + KURTZ, Inc.**  
475 Fifth Avenue  
New York, New York 10017  
212.532.9600

**CROMWELL ARCHITECTS ENGINEERS**  
101 South Spring Street  
Little Rock, Arkansas 72201  
501.372.2900


Curtainwall Consultant  
**R. A. HEINTGES ARCHITECTS**  
126 Fifth Avenue, 9th Floor  
New York, New York 10011  
212.652-2968

Seal

ASI #24	10/24/03
ASI #23	09/12/03
ASI #20	06/06/03
Addenda #	01/06/03
Addenda #1	11/15/02
100% Construction Documents	09/27/02
90% Progress Printing	08/30/02
100% Struct./CD Progress	07/01/02
100% Steel & Concrete CD	05/15/02
& Architectural CD Progress	
100% Design Development	03/01/02
Issue	Date

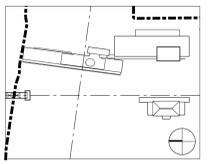

Job No. 9908  
Scale 1/4" = 1'-0"  
Date September 27, 2002  
Title **MUSEUM BUILDING  
INTERIOR ELEVATIONS:  
GROUND FLOOR**  
Sheet No.

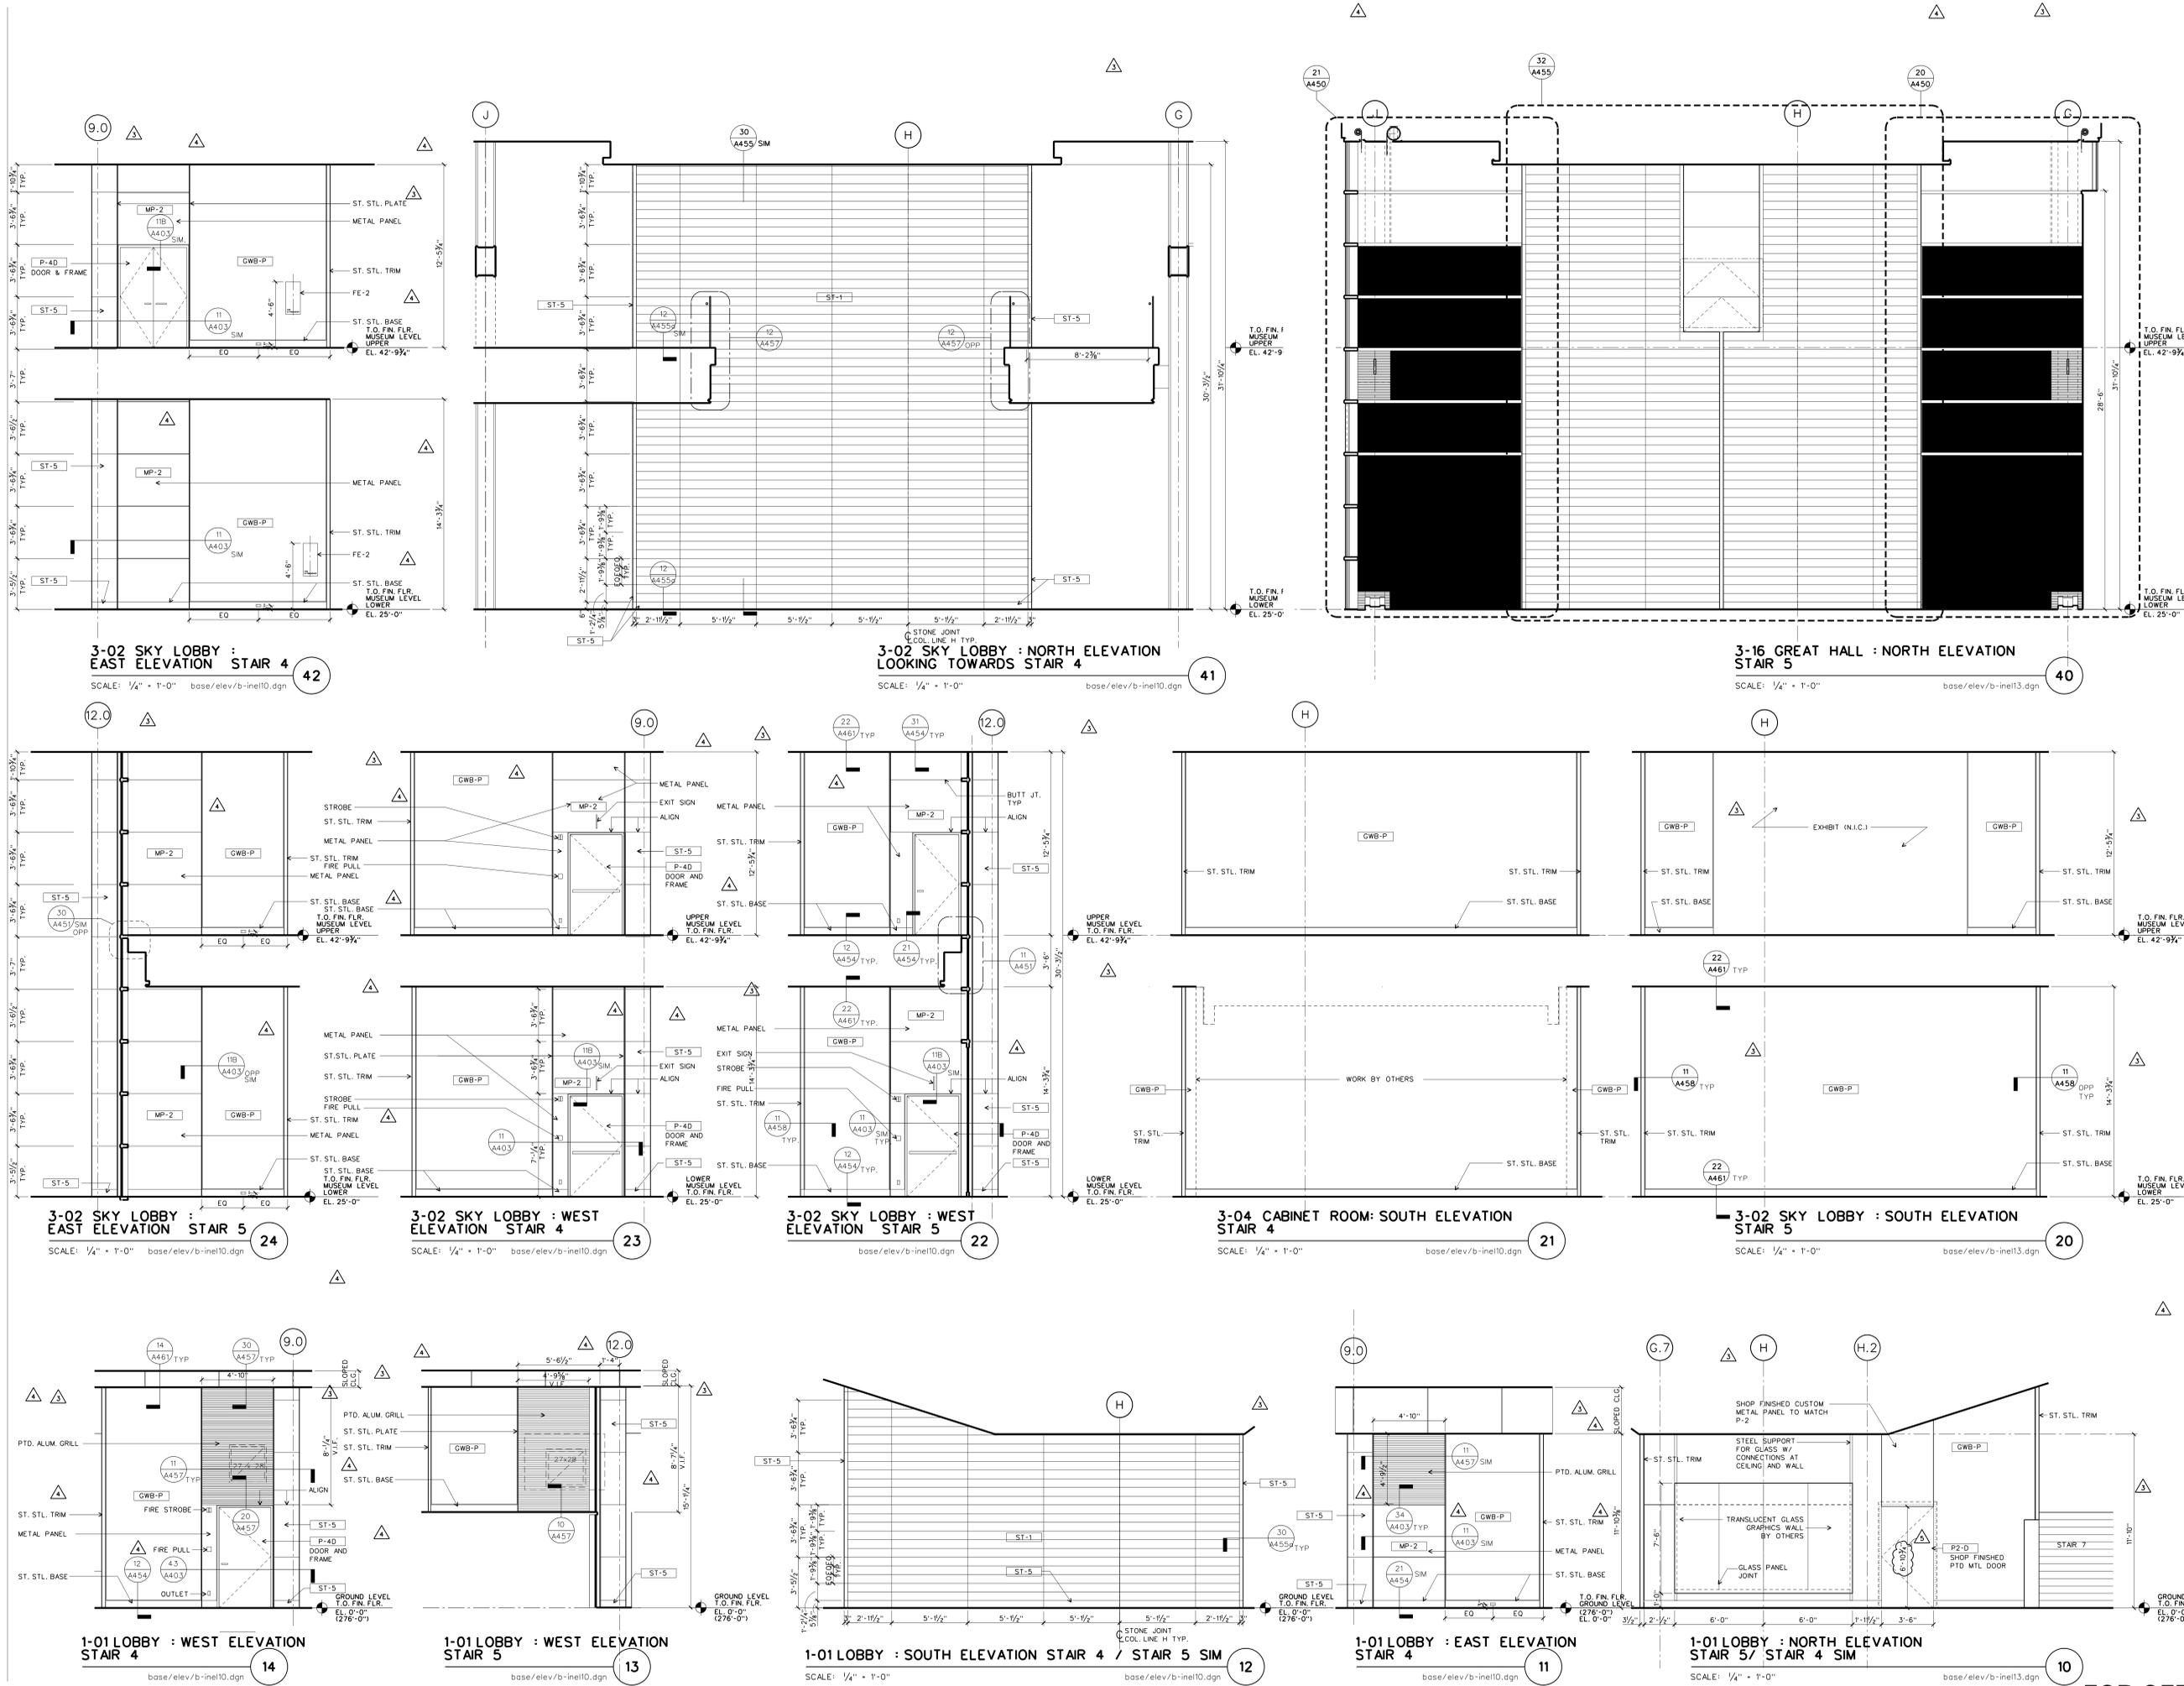

**A412**

FOR OFFICIAL USE ONLY