


Revision	Date
ASI #26	01/16/04
ASI #25	12/19/03
ASI #24	10/24/03
ASI #23	09/12/03
ASI #20	08/06/03
Addendum #2	11/15/02
100% Construction Documents	09/27/02
90% Progress Printing	08/30/02
100% Struct./ CD Progress	07/01/02
100% Steel & Concrete CD	05/15/02
& Architectural CD Progress	03/01/02
100% Design Development	03/01/02
Issue	Date

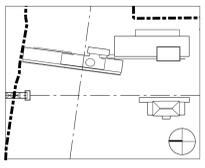

Job No. 9908

Scale 1/4" = 1'-0"

Date September 27, 2002







Title

MUSEUM BUILDING
INTERIOR ELEVATIONS:

Sheet No.

A413

FOR OFFICIAL USE ONLY

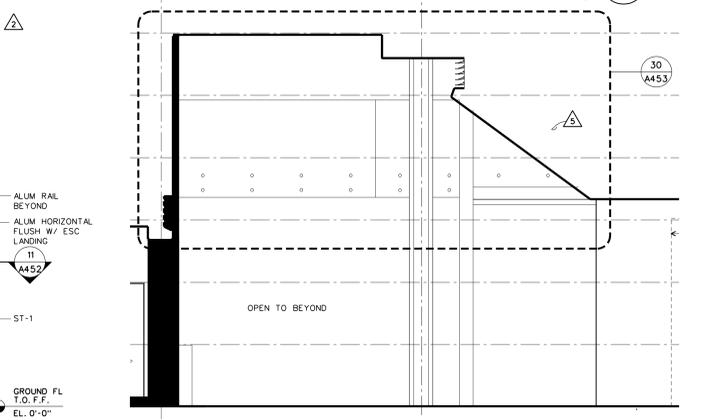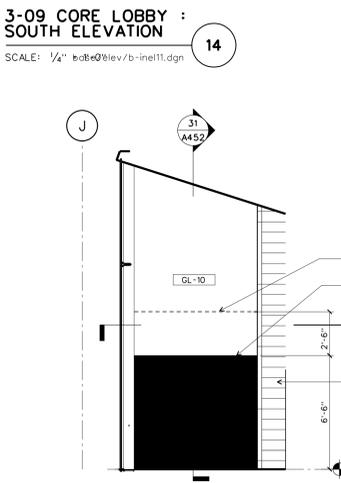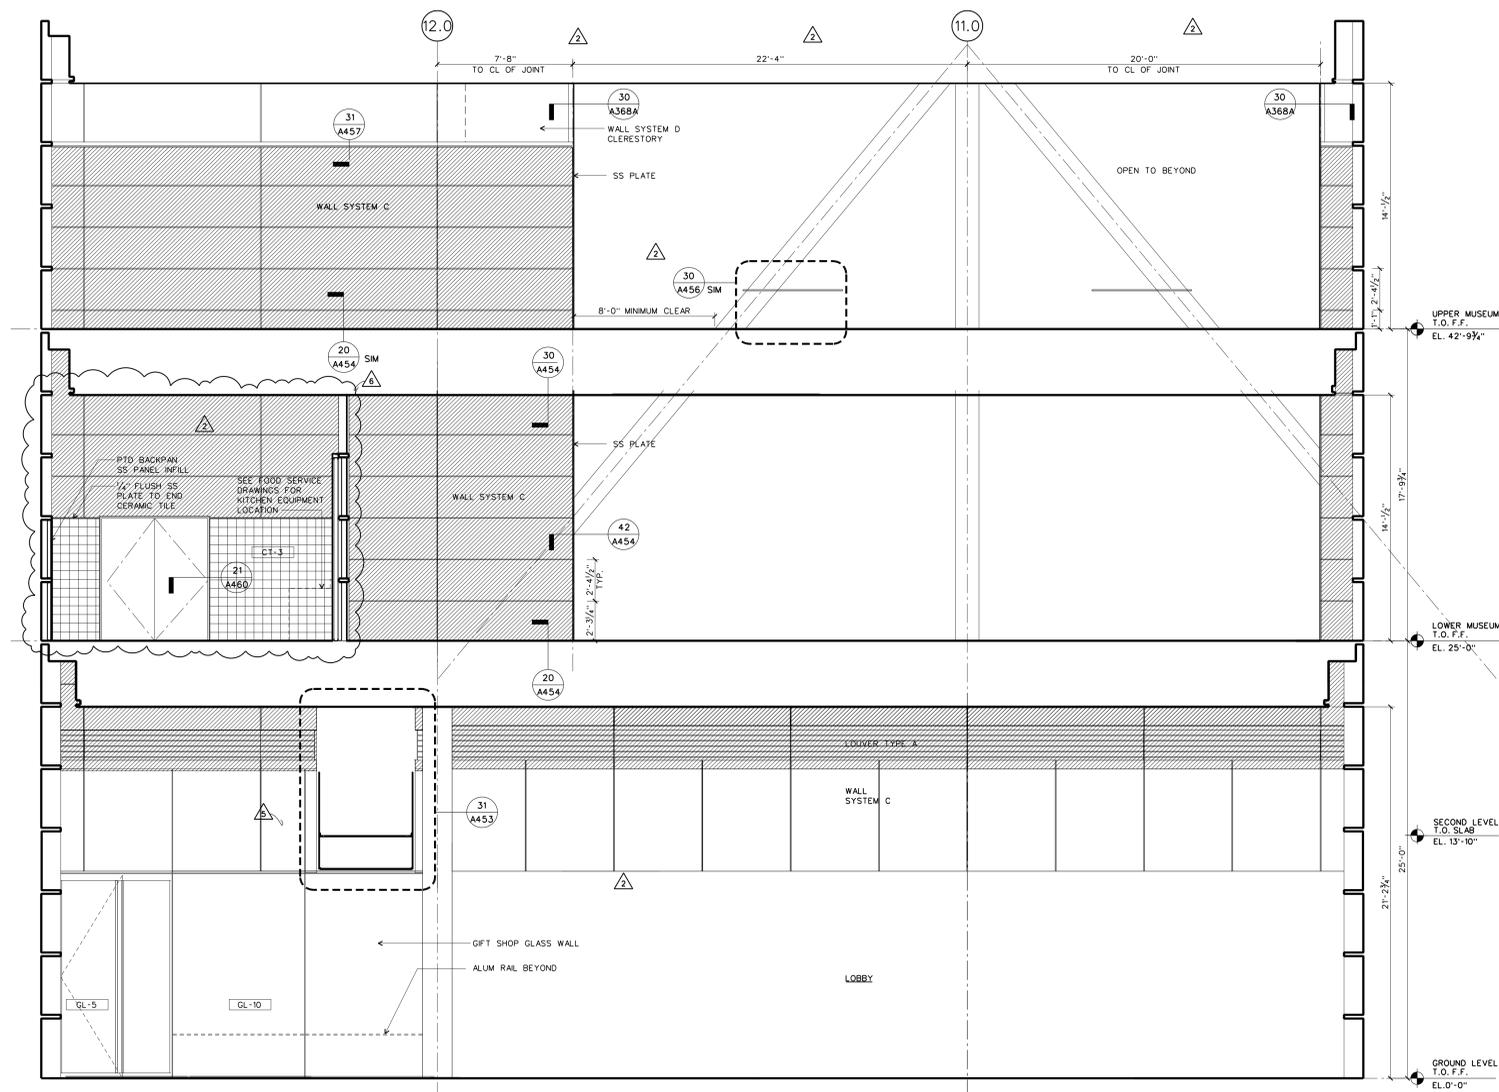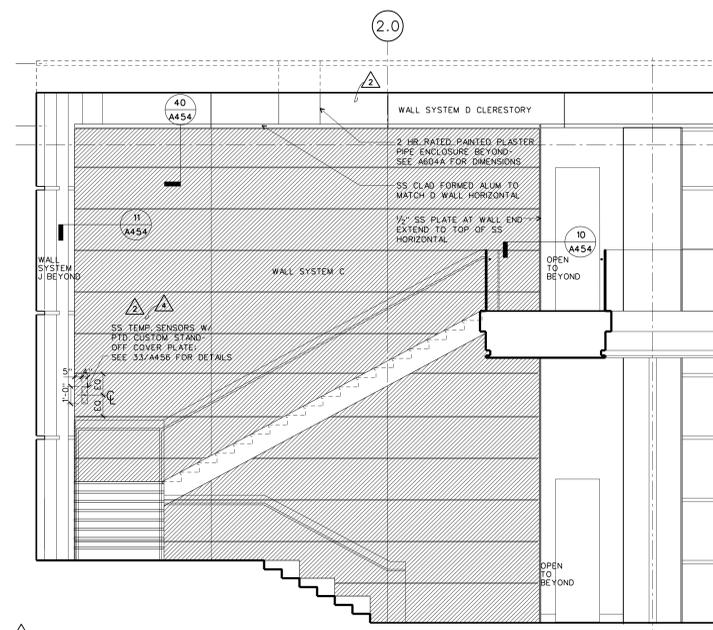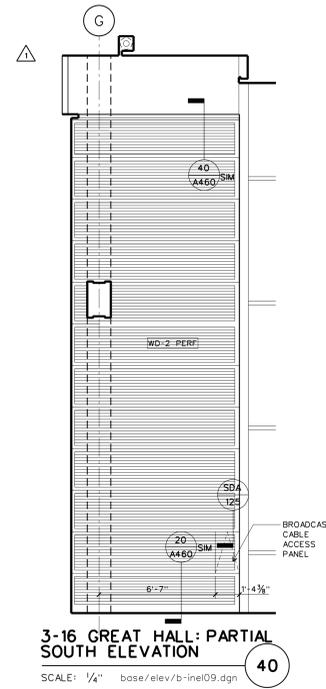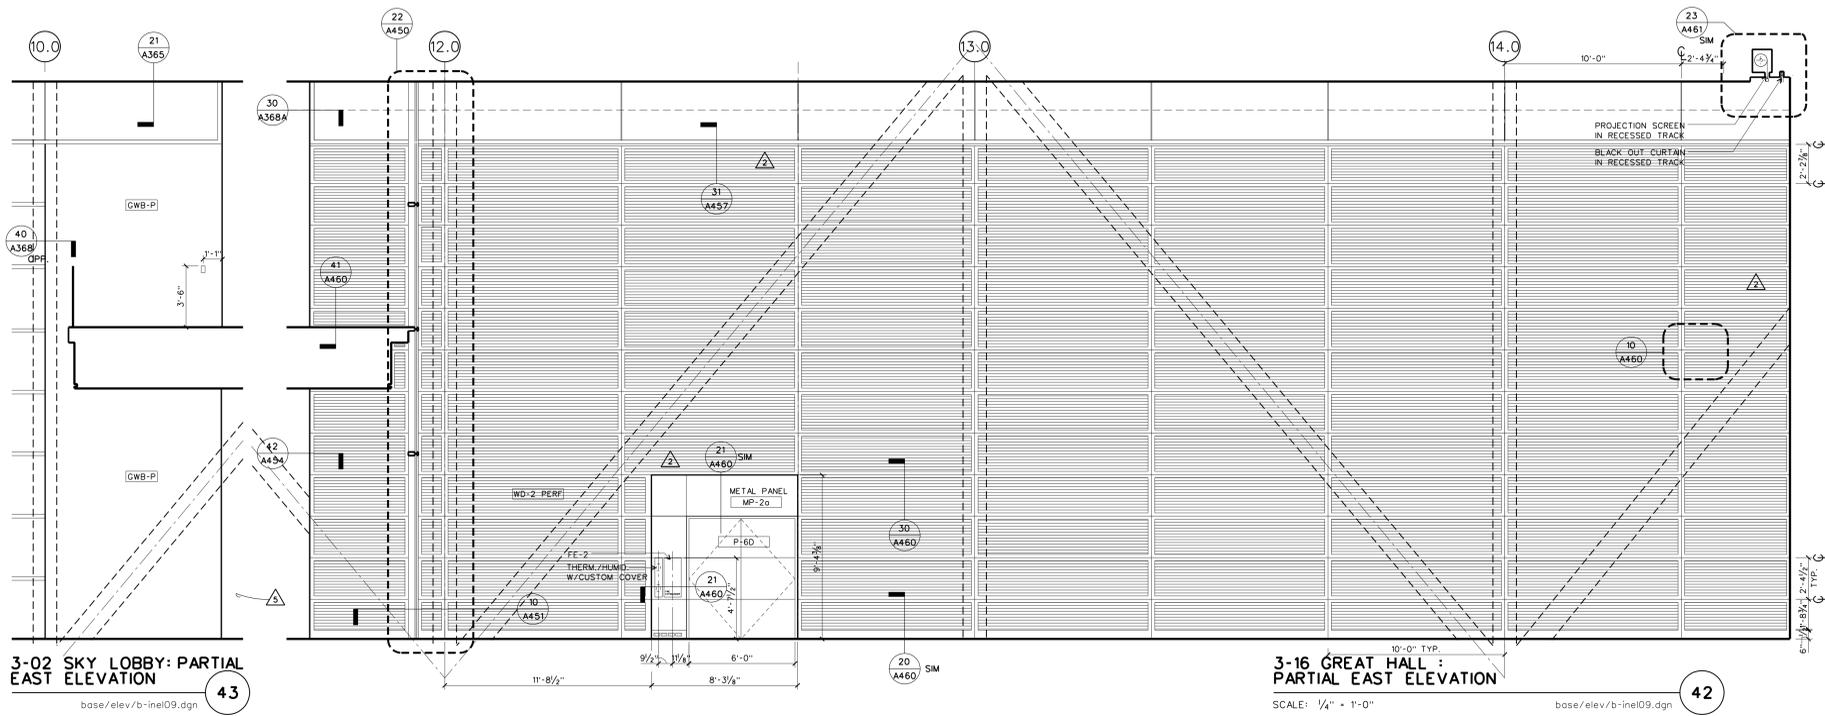

1-06 GIFT SHOP:
NORTH ELEVATION
SCALE: 1/4" = 1'-0" base/elev/b-inel02.dgn

1-07 CORE LOBBY :
SOUTH ELEVATION
SCALE: 1/4" = 1'-0" base/elev/b-inel11.dgn

1-07, 3-09, 4-07 CORE LOBBIES:
WEST ELEVATION
SCALE: 1/4" = 1'-0" base/elev/b-inel02.dgn

3-09 CORE LOBBY :
SOUTH ELEVATION
SCALE: 1/4" = 1'-0" base/elev/b-inel11.dgn

3-06 STAIR LANDING:
EAST ELEVATION
SCALE: 1/4" = 1'-0" base/elev/b-inel03.dgn

3-16 GREAT HALL :
PARTIAL EAST ELEVATION
SCALE: 1/4" = 1'-0" base/elev/b-inel09.dgn

3-16 GREAT HALL :
PARTIAL SOUTH ELEVATION
SCALE: 1/4" base/elev/b-inel09.dgn

3-02 SKY LOBBY: PARTIAL
EAST ELEVATION
SCALE: 1/4" = 1'-0" base/elev/b-inel09.dgn