


ASI #32	04/09/04
ASI #26	01/16/04
ASI #25	12/19/03
ASI #24	10/24/03
ASI #23	09/12/03
ASI #20	08/08/03
100% Construction Documents	09/27/02
90% Progress Printing	08/30/02
100% Struct./CD Progress	07/01/02
100% Steel & Concrete CD	05/15/02
& Architectural CD Progress	
100% Design Development	03/01/02
Issue	Date




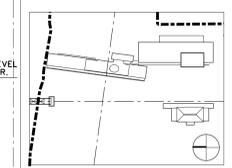


Job No. 9908
Scale 1/4" = 1'-0"
Date September 27, 2002
Title

**MUSEUM BUILDING
INTERIOR ELEVATIONS:**

Sheet No. **A414**

FOR OFFICIAL USE ONLY

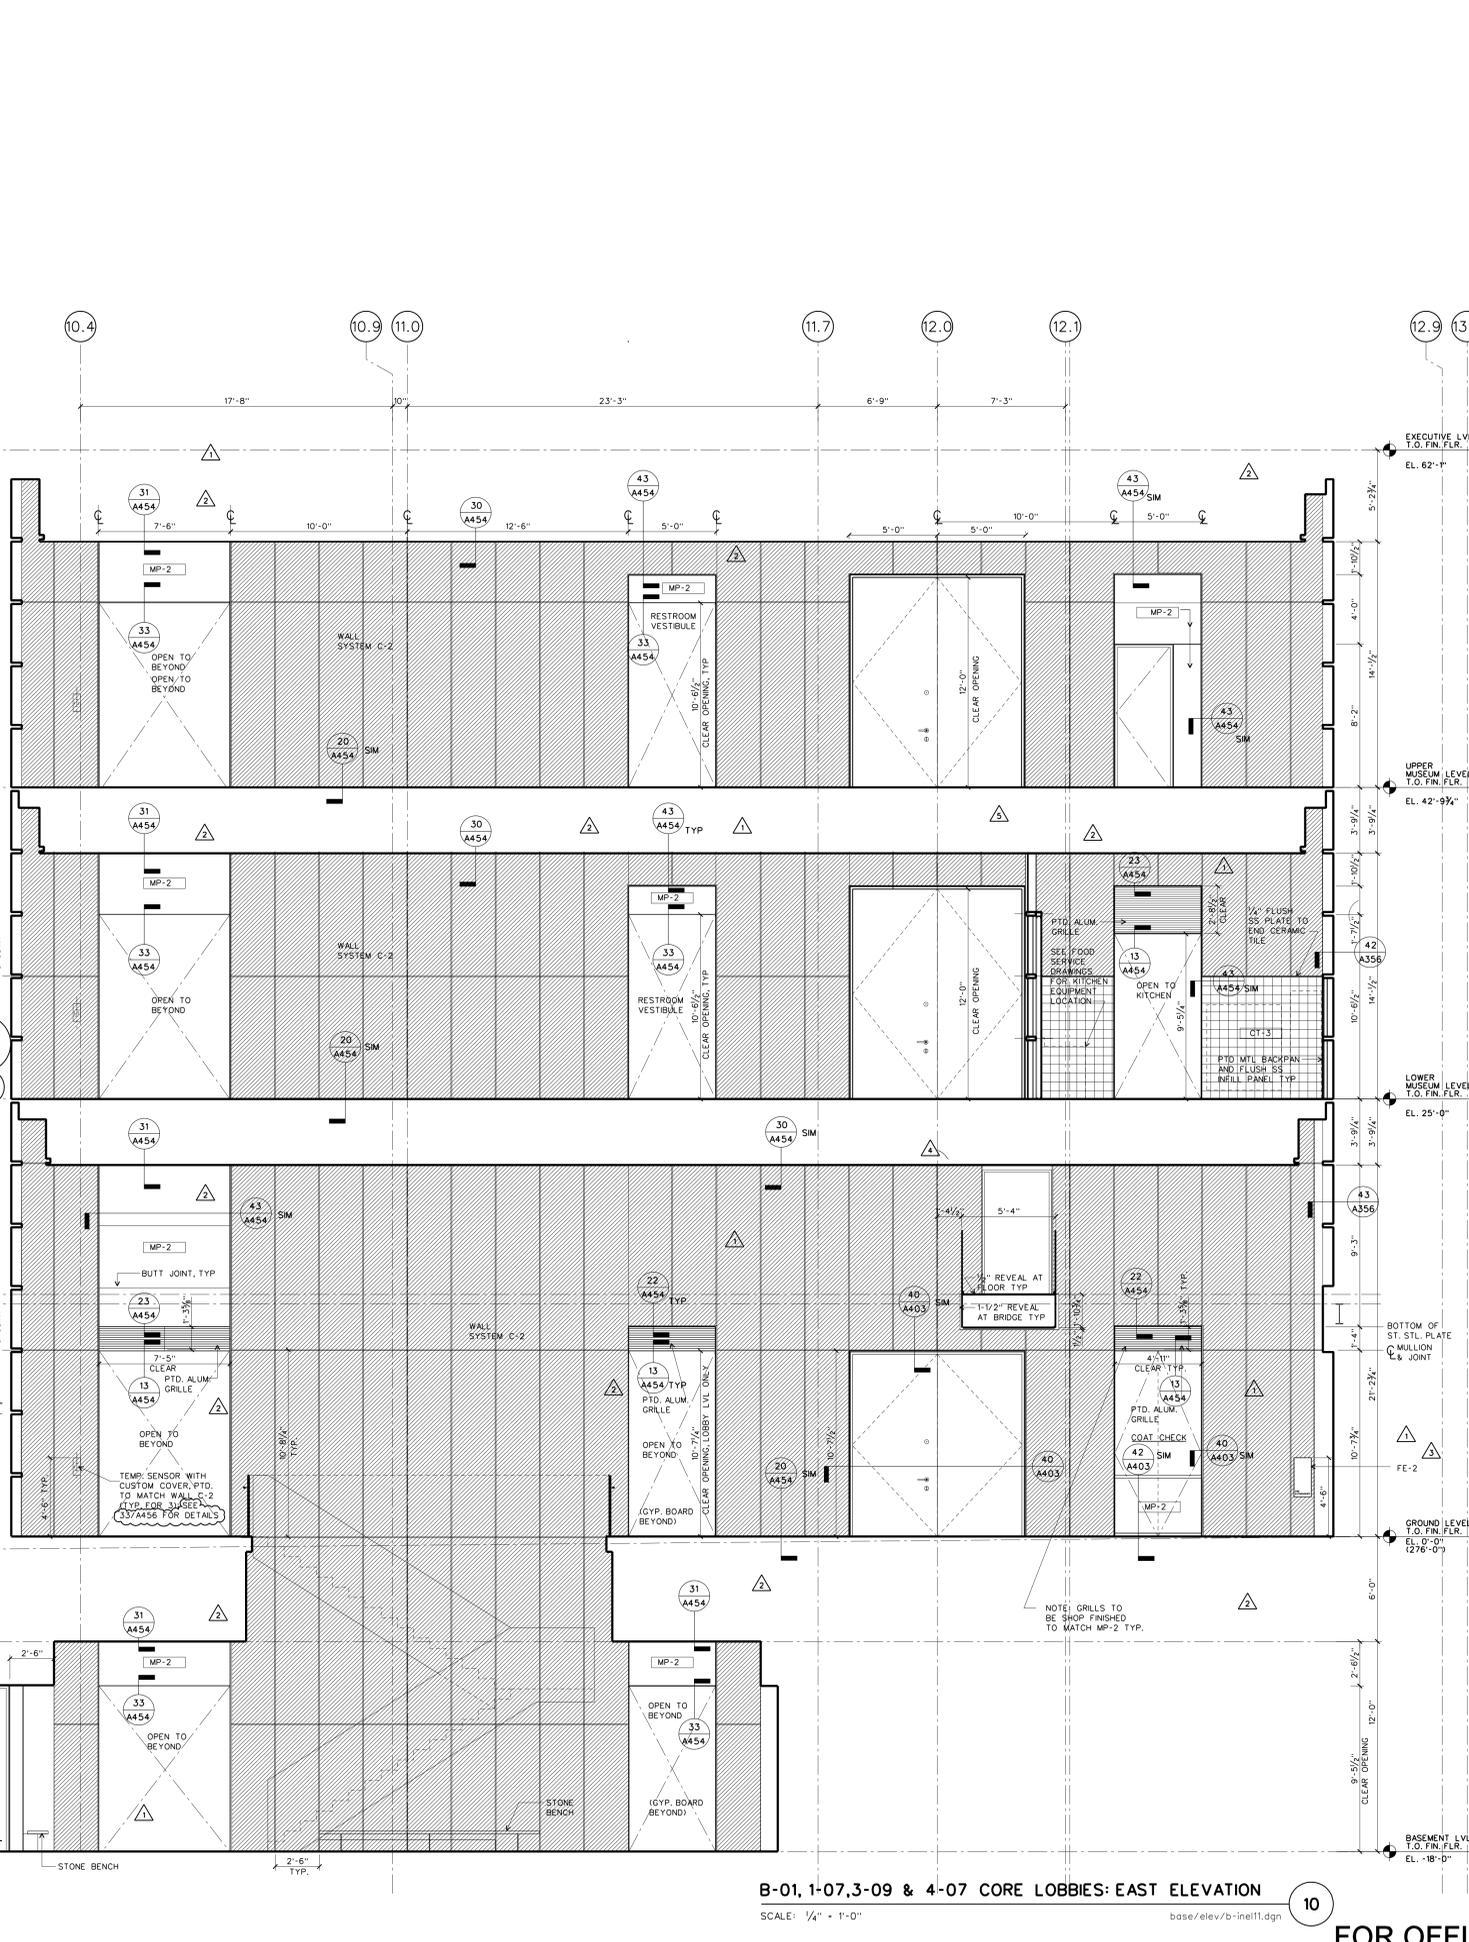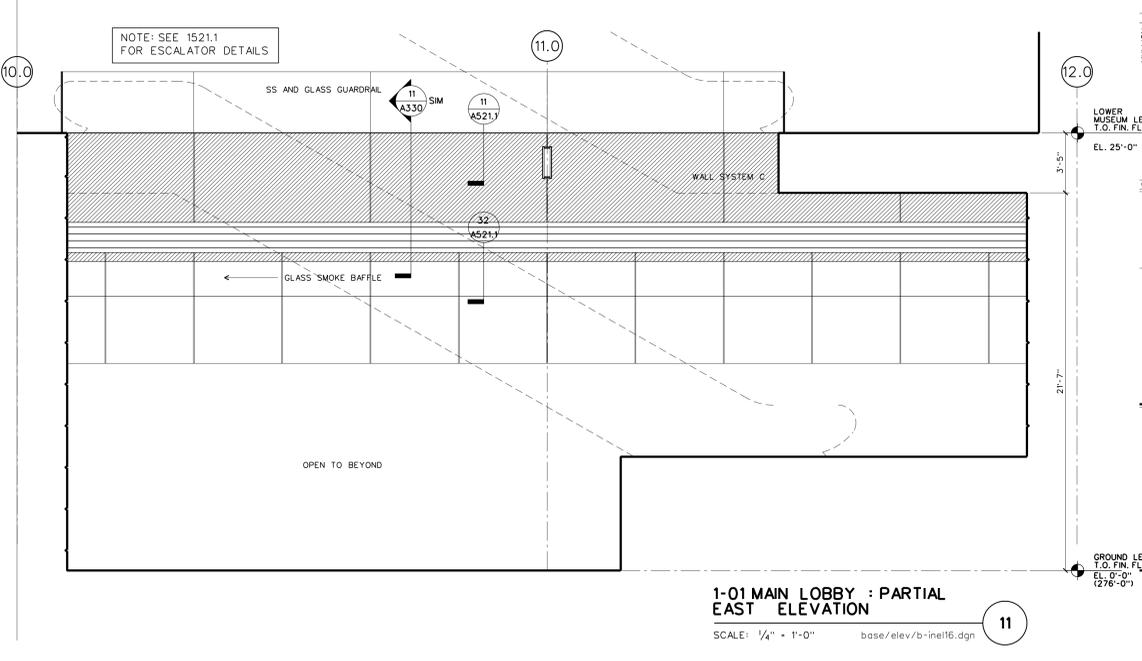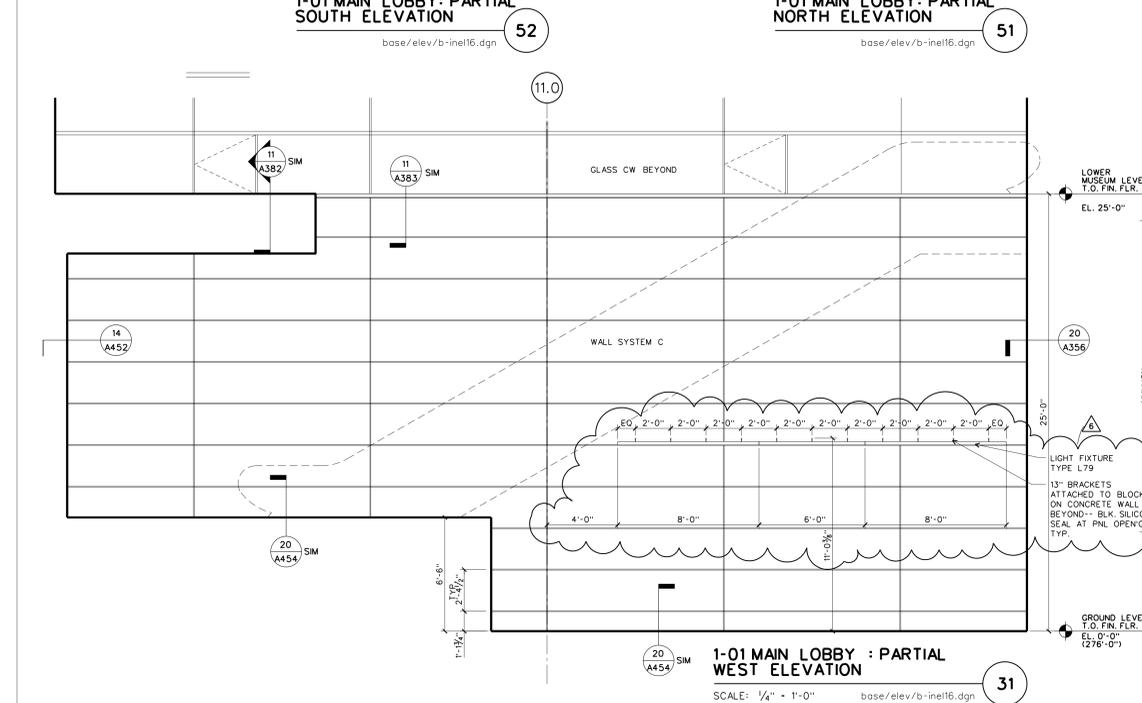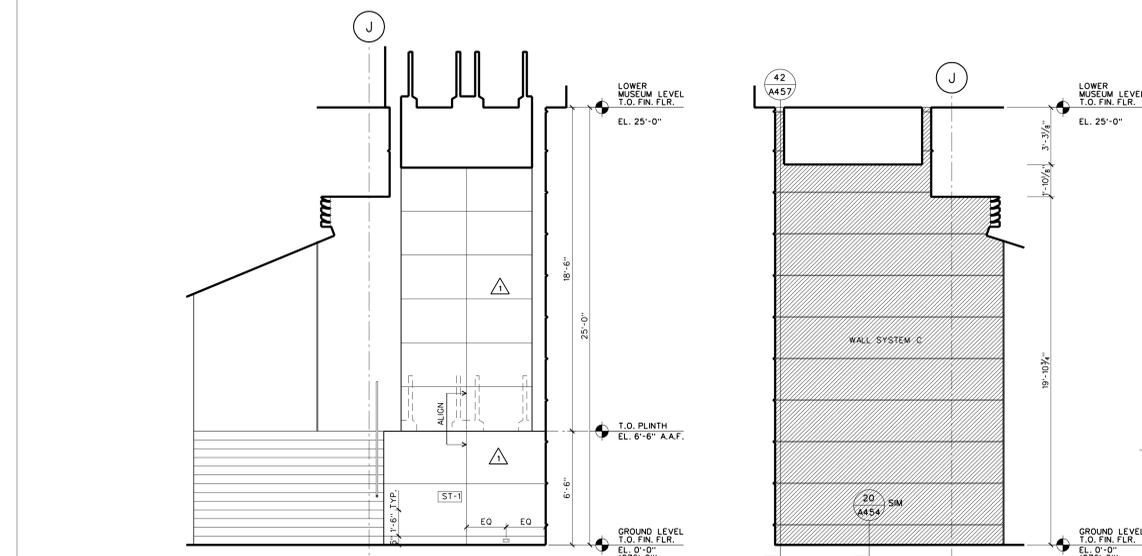

B-01, 1-07, 3-09 & 4-07 CORE LOBBIES: EAST ELEVATION
SCALE: 1/4" = 1'-0" base/elev/b-inell1.dgn