


ASI #20	08/06/03
Addendum #2	11/15/02
100% Construction Documents	09/27/02
90% Progress Printing	08/30/02
100% Struct./ CD Progress	07/01/02
100% Steel & Concrete CD	05/15/02
& Architectural CD Progress	
100% Design Development	03/01/02
Issue	Date

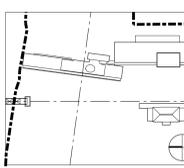

Job No. 9908

Scale 1/4" = 1'-0"

Date September 27, 2002


Title

**MUSEUM BUILDING
INTERIOR ELEVATIONS:
GLASS RAILINGS**


Sheet No.

A420


FOR OFFICIAL USE ONLY

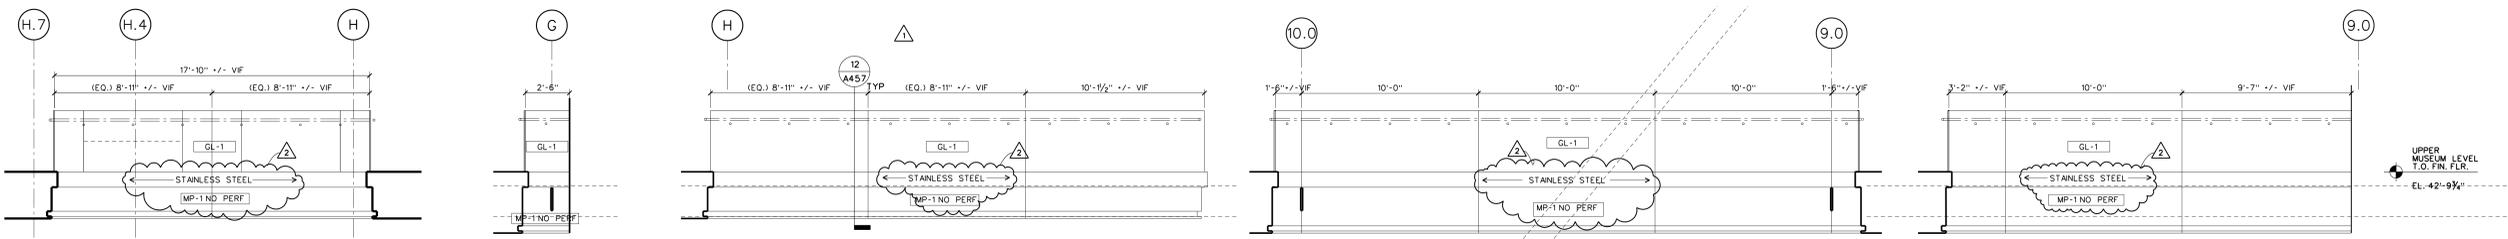


CATWALK ELEVATION - NORTH 1 SCALE: 1/4" = 1'-0" b-inel-rail01.dgn **64**
CATWALK ELEV. NORTH 2 SCALE: 1/4" = 1'-0" b-inel-rail02 **63**
CATWALK ELEVATION - SOUTH 1 SCALE: 1/4" = 1'-0" b-inel-rail02.dgn **62**
CATWALK ELEVATION - WEST 3 SCALE: 1/4" = 1'-0" b-inel-rail03.dgn **61**
CATWALK ELEVATION - WEST 2 SCALE: 1/4" = 1'-0" b-inel-rail02.dgn **60**

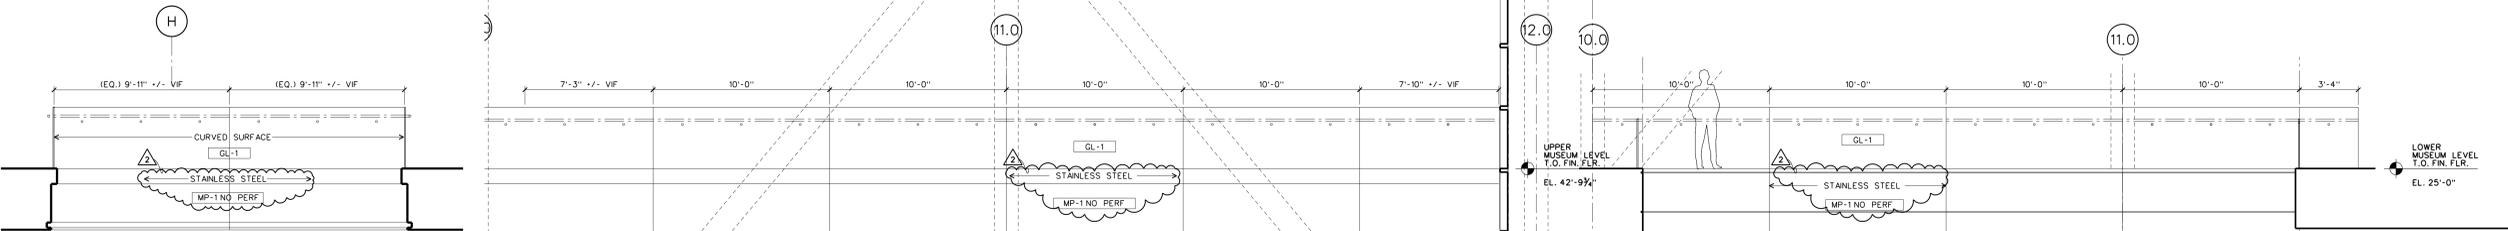


CATWALK ELEVATION - SOUTH 2 SCALE: 1/4" = 1'-0" b-inel-rail01.dgn **52**
CATWALK ELEVATION - EAST 3 SCALE: 1/4" = 1'-0" b-inel-rail03.dgn **51**
CATWALK ELEVATION - EAST 4 SCALE: 1/4" = 1'-0" b-inel-rail03.dgn **50**

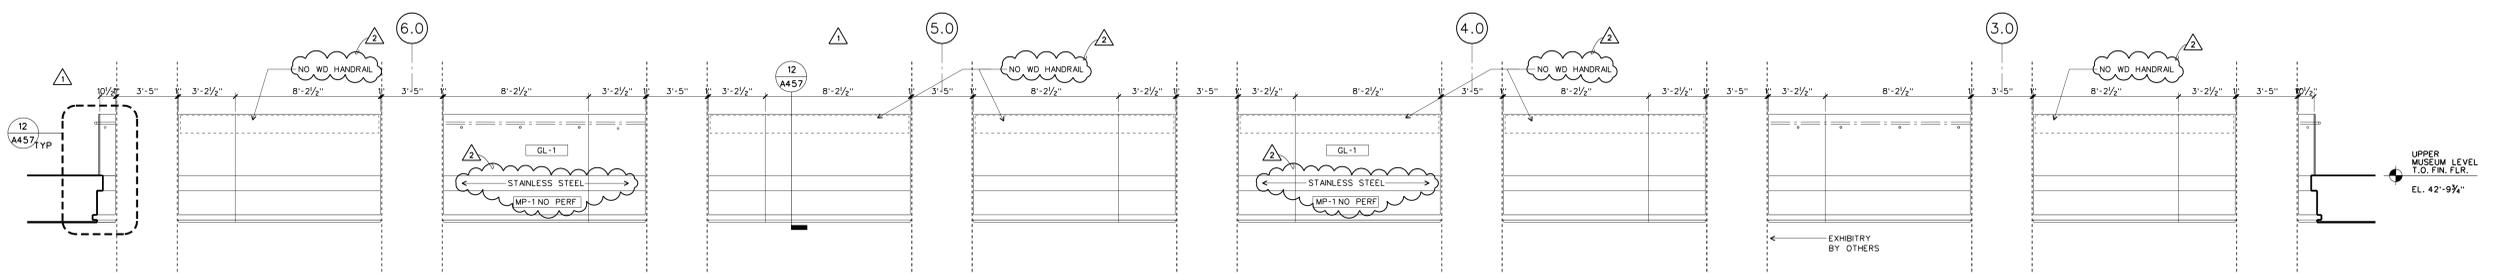


CATWALK ELEVATION - WEST 1 SCALE: 1/4" = 1'-0" b-inel-rail01.dgn **40**

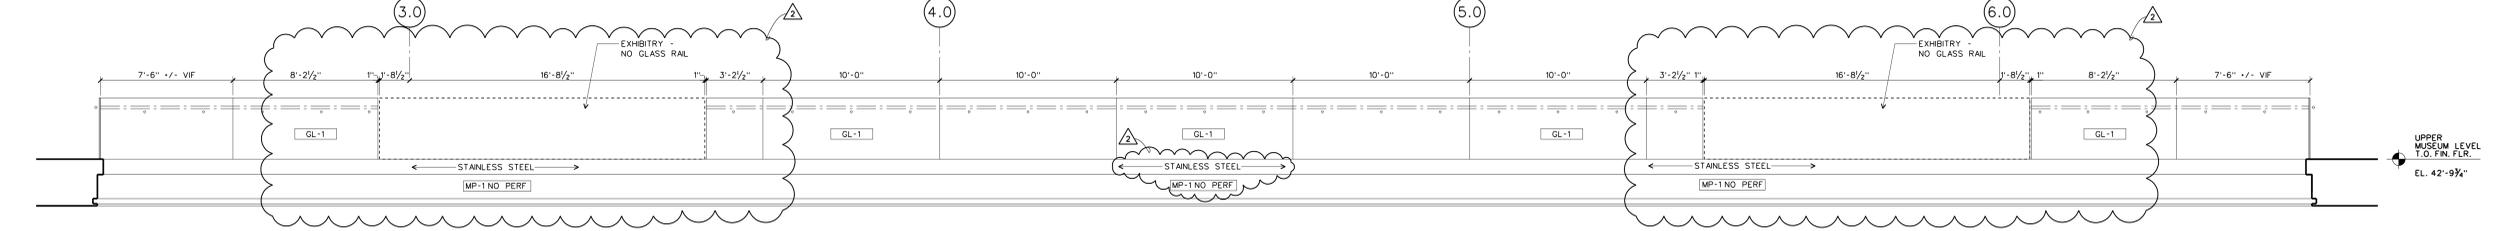

CATWALK ELEVATION - EAST 1 SCALE: 1/4" = 1'-0" b-inel-rail01.dgn **30**

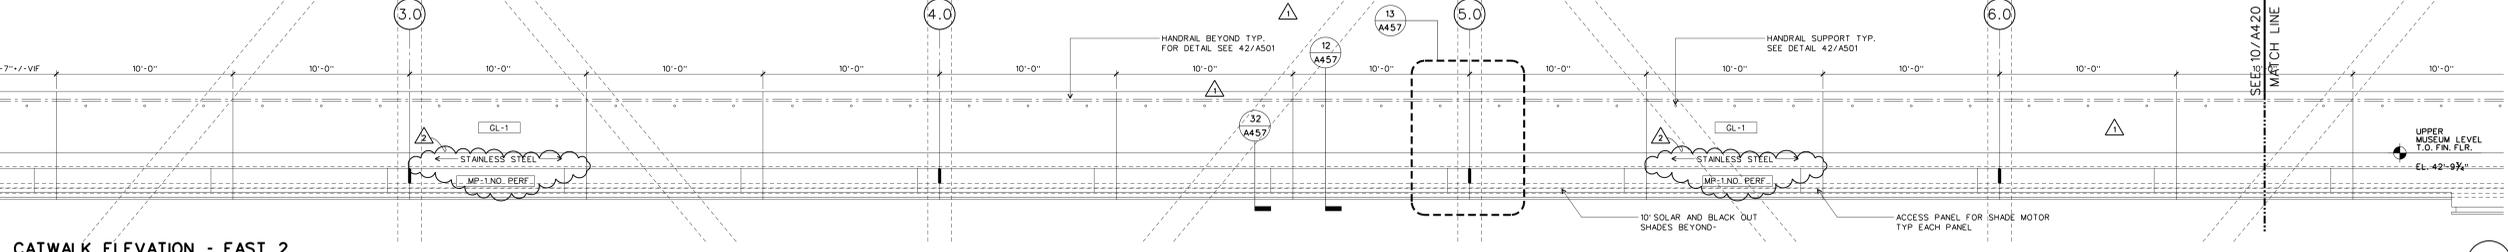

CATWALK ELEVATION - EAST 2 SCALE: 1/4" = 1'-0" b-inel-rail02.dgn **20**

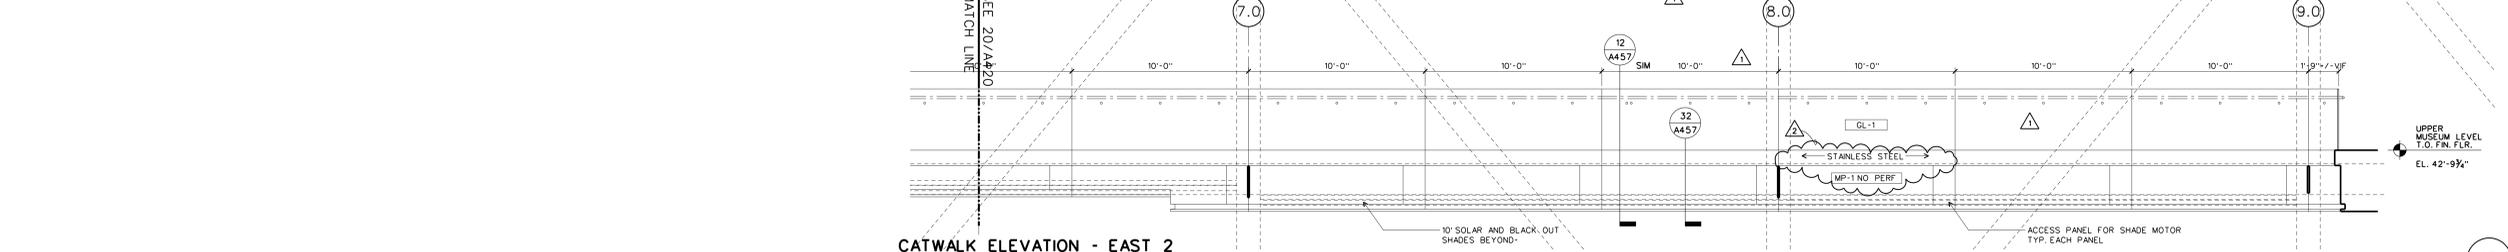

CATWALK ELEVATION - EAST 3 SCALE: 1/4" = 1'-0" b-inel-rail02.dgn **10**