

**WILLIAM J. CLINTON
PRESIDENTIAL
CENTER**

LITTLE ROCK, ARKANSAS

Architect
POLSHEK PARTNERSHIP LLP
320 West 13th Street
New York, New York 10014
212.807.7171

Coordinating Architects
POLK STANLEY YEARY ARCHITECTS Ltd
700 South Schiller Street
Little Rock, Arkansas 72201
501.378.0878

WITSELL EVANS RASCO
901 West Third Street
Little Rock, Arkansas 72201
501.374.5300

WOODS CARADINE ARCHITECTS
2200 South Main Street
Little Rock, Arkansas 72206
501.374.4060

Landscape Architects
HARGREAVES ASSOCIATES
118 Magazine Street
Cambridge, Massachusetts 02139
617.661.0070

LANDSCAPE ARCHITECTURE, Inc.
2300 Cottondale Lane Suite 202
Little Rock, Arkansas 72202
501.374.5610

Structural Engineer
LESLIE E. ROBERTSON ASSOC., RLLP
30 Broad Street, 47th Floor
New York, New York 10004
212.750.9000

MEP Engineers
FLACK + KURTZ Inc.
475 Fifth Avenue
New York, New York 10017
212.532.9600

CROMWELL ARCHITECTS ENGINEERS
101 South Spring Street
Little Rock, Arkansas 72201
501.372.2900

Curtainwall Consultant
R. A. HEINTGES ARCHITECTS
126 Fifth Avenue, 9th Floor
New York, New York 10011
212.652-2968

Seal

| Revision | Date |
|---|----------|
| ASI #26 | 01/18/04 |
| ASI #20 | 08/06/03 |
| Addendum #2 | 11/15/02 |
| 100% Construction Documents | 09/27/02 |
| 90% Progress Printing | 08/30/02 |
| 100% Struct./CD Progress | 07/01/02 |
| Issue | Date |
| *New. Former A450 details on A450 dwgs. | |

Job No. 9908

Scale 1/2" = 1'-0"

Date September 27, 2002


Title

MUSEUM INTERIOR
DETAILS: INTERIOR
STOREFRONT SYSTEM

Sheet No.


A450

FOR OFFICIAL USE ONLY

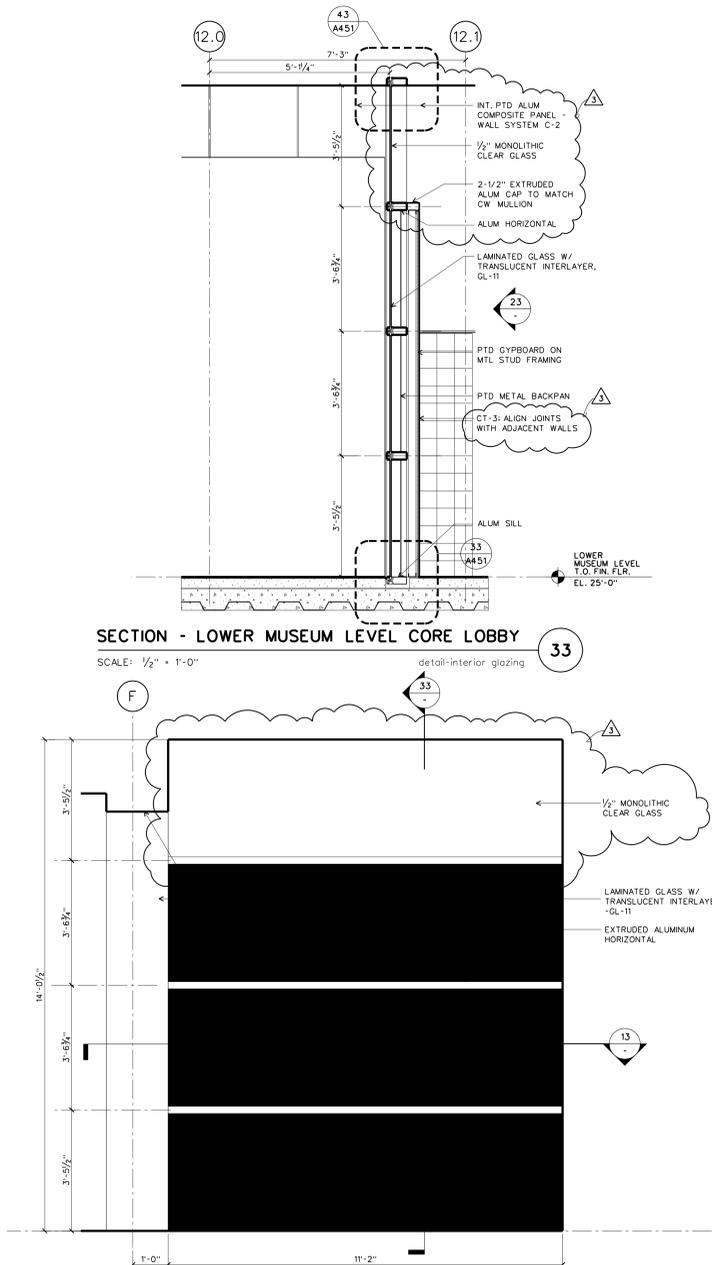


SECTION - LOWER MUSEUM LEVEL CORE LOBBY 33
SCALE: 1/2" = 1'-0"
detail-interior glazing


ELEVATION - LOWER MUSEUM LEVEL CORE LOBBY 23
SCALE: 1/2" = 1'-0"
detail-interior glazing

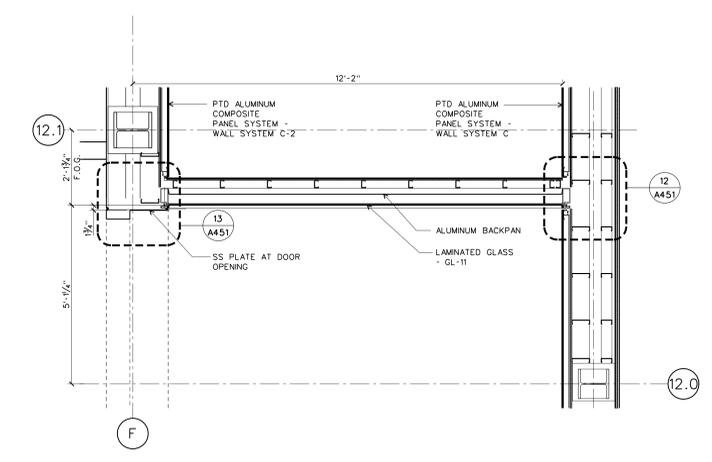


PLAN DTL - LOWER MUSEUM LEVEL CORE LOBBY 13
SCALE: 1/2" = 1'-0"
detail-interior glazing

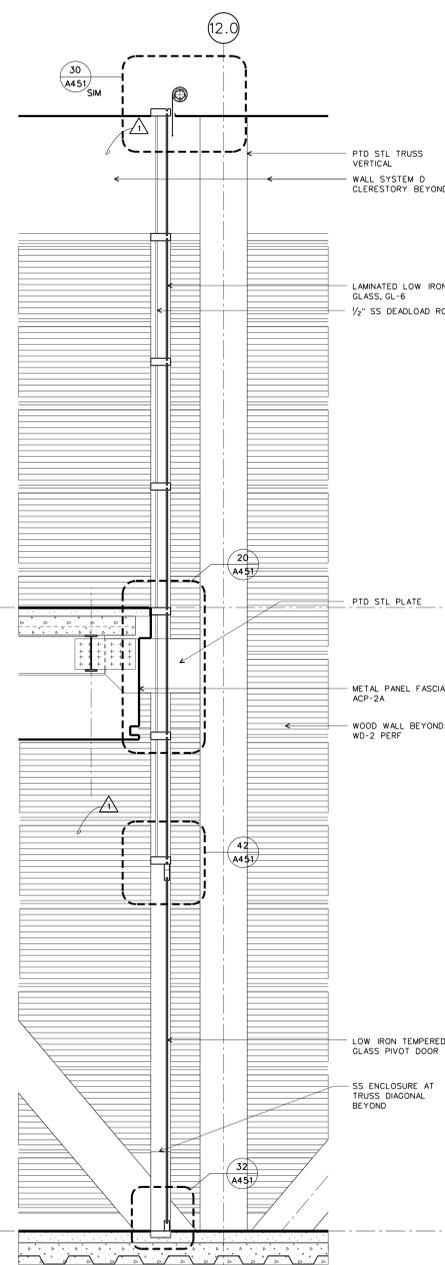


SECTION INTERIOR GLAZING GREAT HALL 22
SCALE: 1/2" = 1'-0"
detail-interior glazing

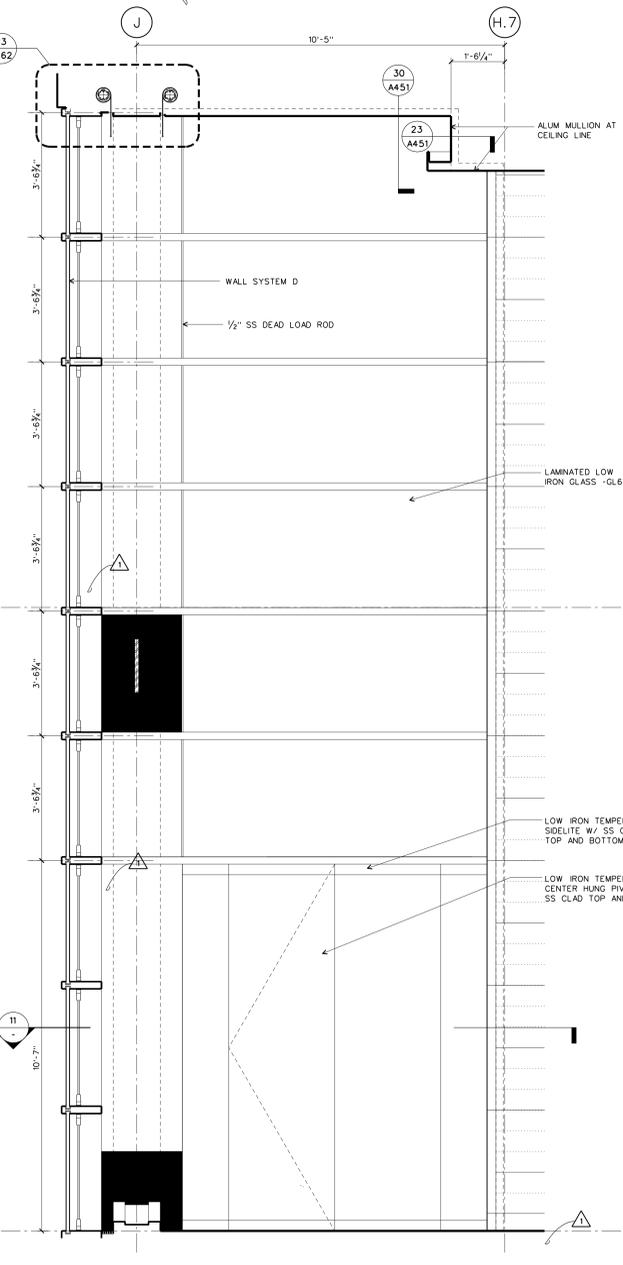


GREAT HALL GLASS WALL ELEVATION - WEST 21
SCALE: 1/2" = 1'-0"
detail-interior glazing

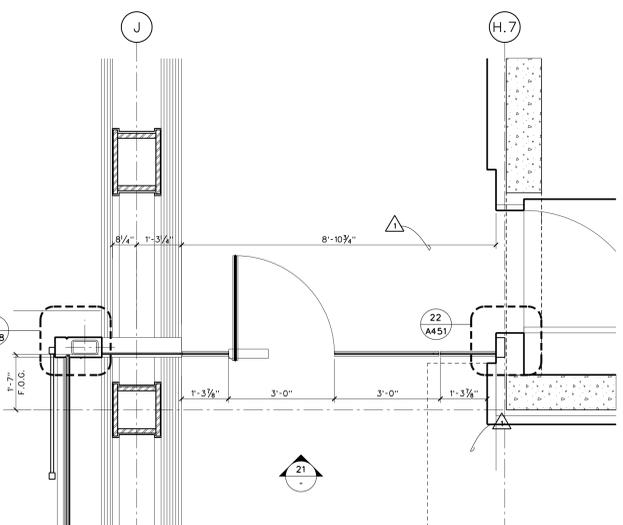

GREAT HALL GLASS WALL - WEST 11
SCALE: 1/2" = 1'-0"
detail-interior glazing

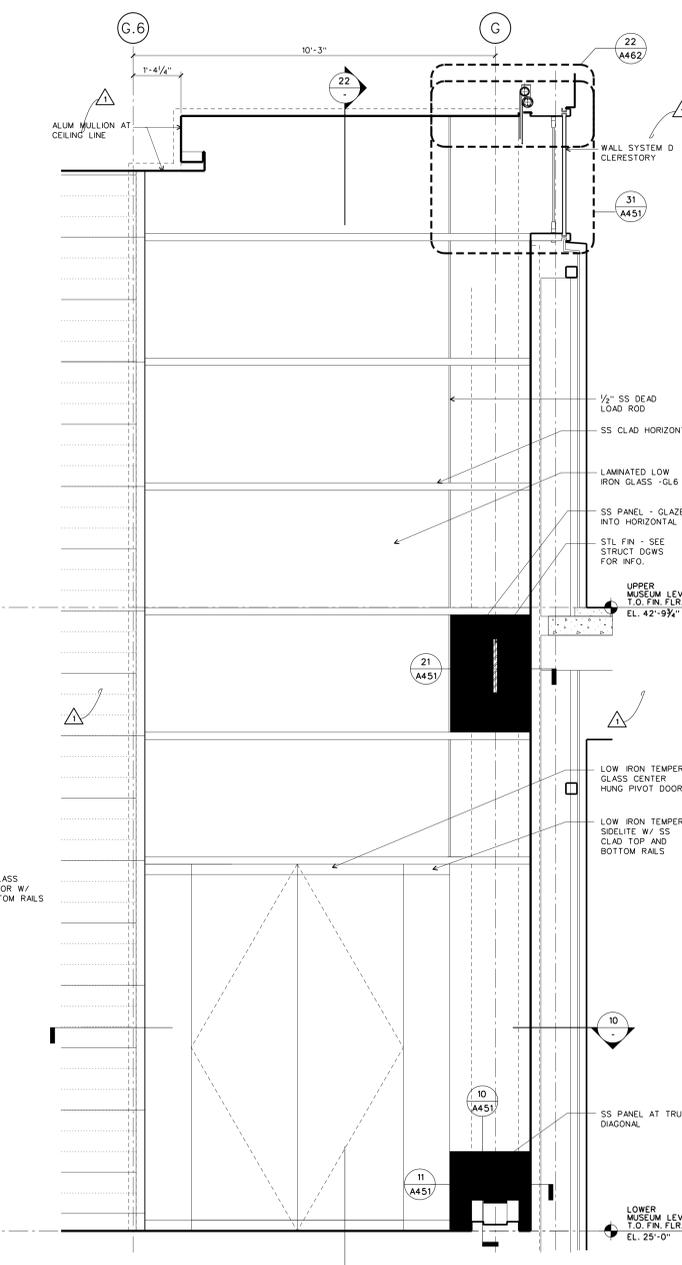

GREAT HALL GLASS WALL ELEVATION - EAST 20
SCALE: 1/2" = 1'-0"
detail-interior glazing

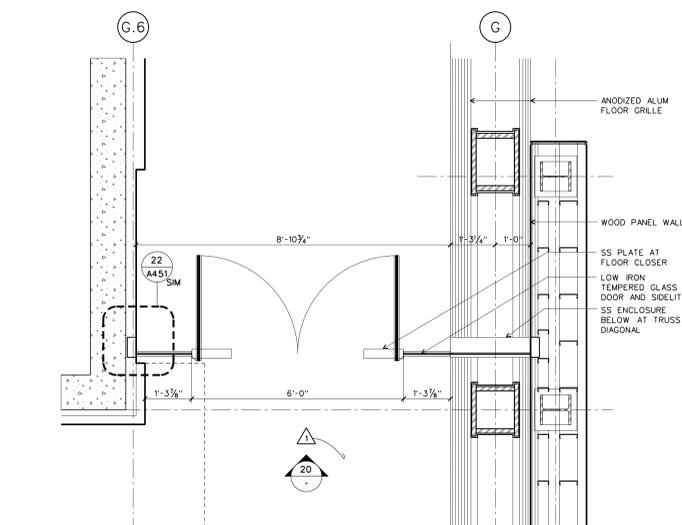

GREAT HALL GLASS WALL - EAST 10
SCALE: 1/2" = 1'-0"
detail-interior glazing