


AS1 #26	01/16/04
AS1 #23	09/12/03
AS1 #20	06/06/03
Addendum #4	11/22/02
Addendum #2	11/15/02
100% Construction Documents	09/27/02
90% Progress Printing	08/30/02
100% Struct./CD Progress	07/01/02
Issue	Date
*New, Former A451 details on A623.1	

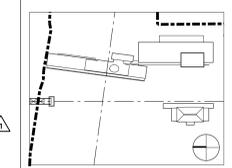

Job No. 9908

Scale 3" = 1'-0"


Date September 27, 2002

Title **MUSEUM BUILDING
INTERIOR DETAILS:
INTERIOR STOREFRONT
SYSTEM**


Sheet No.

A451


FOR OFFICIAL USE ONLY

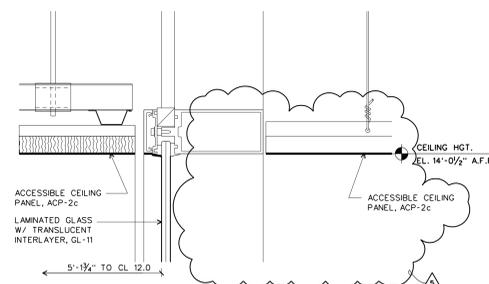


SECTION AT ELEVATOR LOBBY GLAZING (43)
SCALE: 3" = 1'-0"
d-interior-glazing-01

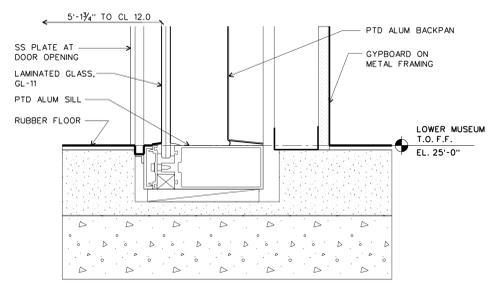


SECTION DETAIL AT ELEVATOR LOBBY SILL (33)
SCALE: 3" = 1'-0"
d-interior-glazing-01

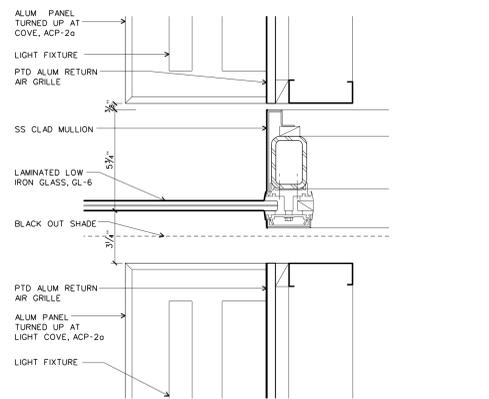


PLAN DETAIL AT GREAT HALL LIGHT COVE (23)
SCALE: 3" = 1'-0"
d-interior-glazing-01

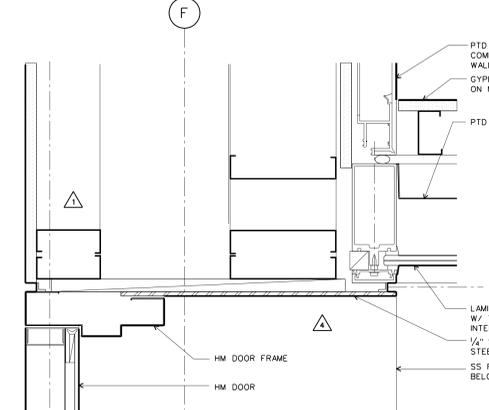


PLAN DETAIL AT ELEVATOR LOBBY GLAZING (13)
SCALE: 3" = 1'-0"
d-interior-glazing-01

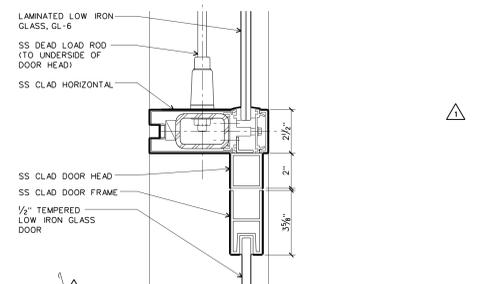


SECTION DETAIL AT GREAT HALL DOOR HEAD (42)
SCALE: 3" = 1'-0"
d-interior-glazing-01

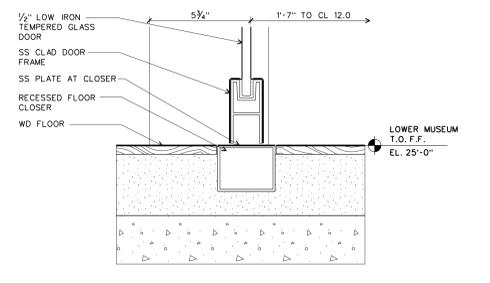


SECTION DETAIL AT GREAT HALL DOOR SILL (32)
SCALE: 3" = 1'-0"
d-interior-glazing-01

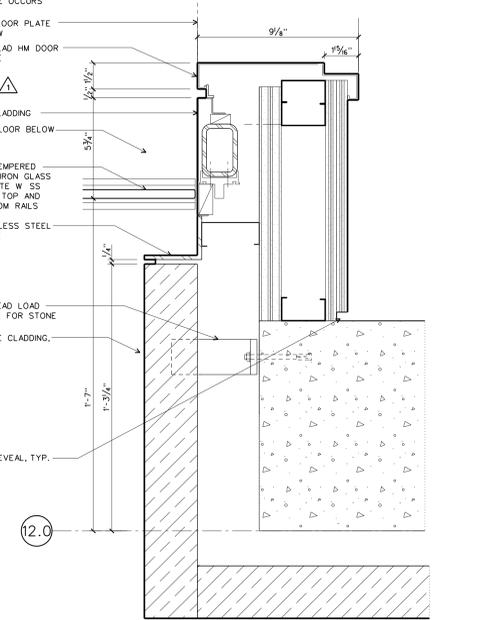


PLAN DETAIL AT GREAT HALL GLAZING (22)
SCALE: 3" = 1'-0"
d-interior-glazing-01

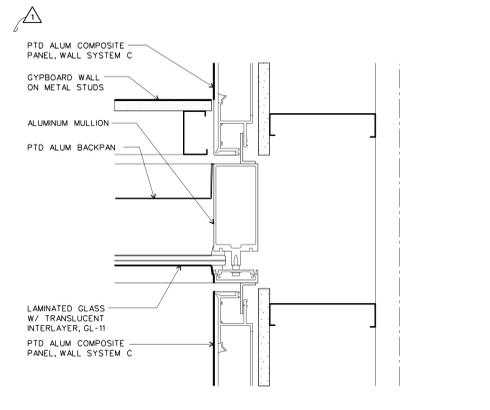


PLAN DETAIL AT ELEVATOR LOBBY GLAZING (12)
SCALE: 3" = 1'-0"
d-interior-glazing-01

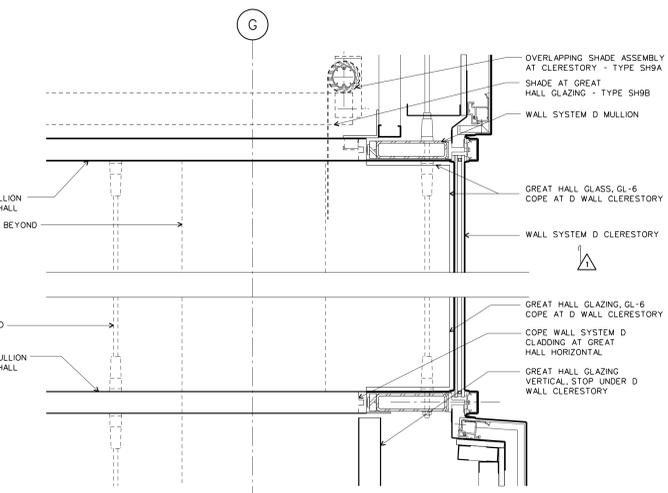


SECTION DETAIL AT GREAT HALL GLAZING AT CLERESTORY (31)
SCALE: 1'-1/2" = 1'-0"
d-interior-glazing-01

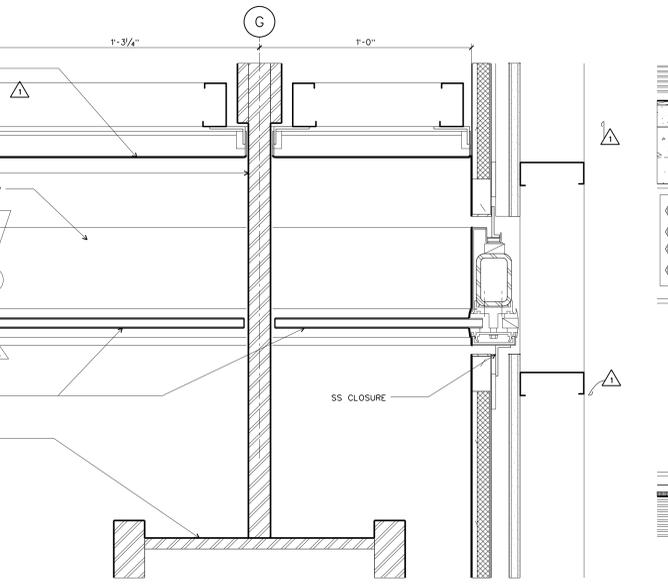


PLAN DETAIL AT STEEL PLATE PENETRATION (21)
SCALE: 3" = 1'-0"
d-interior-glazing-01

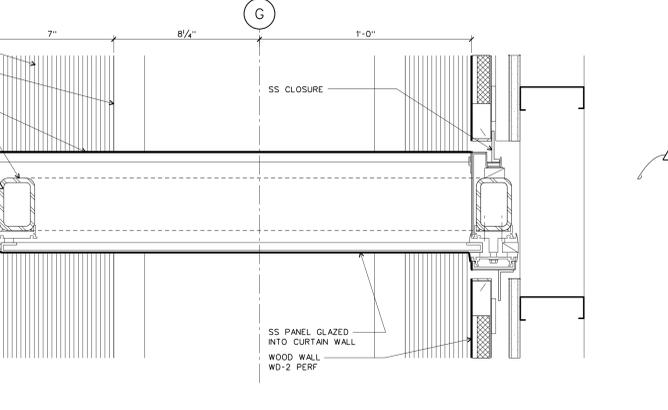


PLAN DETAIL AT TRUSS DIAGONAL ENCLOSURE (11)
SCALE: 3" = 1'-0"
d-interior-glazing-01

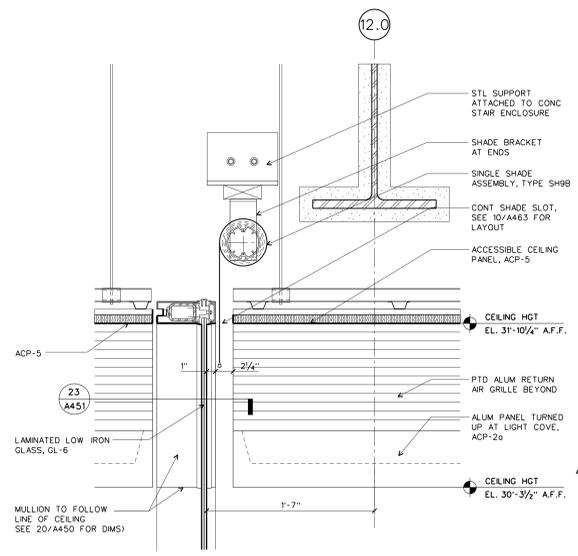

SECTION DETAIL AT CEILING (30)
SCALE: 1'-1/2" = 1'-0"
d-interior-glazing-01

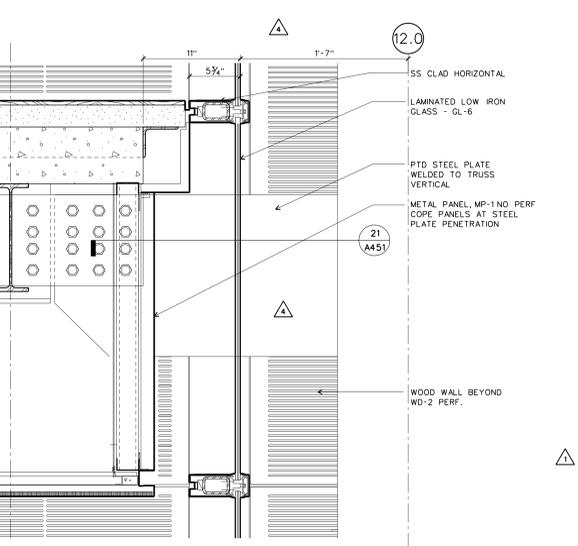

SECTION DETAIL AT UPPER MUSEUM LEVEL (20)
SCALE: 1'-1/2" = 1'-0"
d-interior-glazing-01

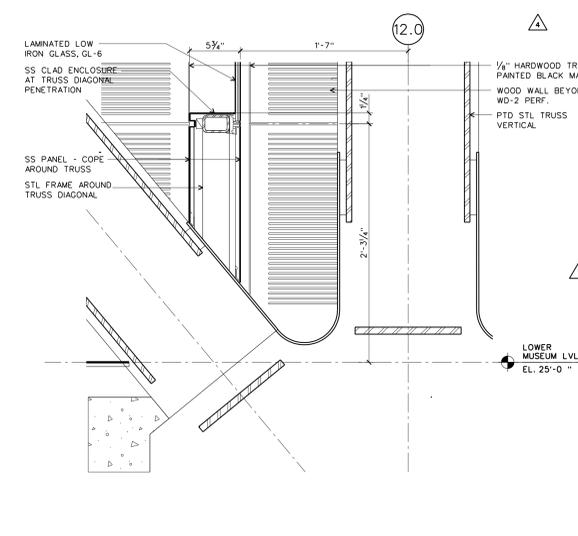

SECTION DETAIL AT TRUSS DIAGONAL (10)
SCALE: 1'-1/2" = 1'-0"
d-interior-glazing-01