

**WILLIAM J. CLINTON
PRESIDENTIAL
CENTER**

LITTLE ROCK, ARKANSAS

Architect
POLSHEK PARTNERSHIP LLP
320 West 13th Street
New York, New York 10014
212.807.7171

Coordinating Architects
POLK STANLEY YEARY ARCHITECTS Ltd
700 South Schiller Street
Little Rock, Arkansas 72201
501.378.0878

WITSELL EVANS RASCO
901 West Third Street
Little Rock, Arkansas 72201
501.374.5300

WOODS CARADINE ARCHITECTS
2200 South Main Street
Little Rock, Arkansas 72206
501.374.4960

Landscape Architects
HARGREAVES ASSOCIATES
118 Magazine Street
Cambridge, Massachusetts 02139
617.661.0070

LANDSCAPE ARCHITECTURE, Inc.
2300 Cottondale Lane Suite 202
Little Rock, Arkansas 72202
501.374.5810

Structural Engineer
LESLIE E. ROBERTSON ASSOC., RLLP
30 Broad Street, 47th Floor
New York, New York 10004
212.750.9000

MEP Engineers
FLACK + KURTZ, Inc.
475 Fifth Avenue
New York, New York 10017
212.532.9600

CROMWELL ARCHITECTS ENGINEERS
101 South Spring Street
Little Rock, Arkansas 72201
501.372.2900

Curtainwall Consultant
R. A. HEINTGES ARCHITECTS
126 Fifth Avenue, 9th Floor
New York, New York 10011
212.652.2968

Seal

AS1 #25	12/19/03
AS1 #22	08/01/03
AS1 #12	02/07/03
100% Construction Documents	09/27/02
90% Progress Printing	08/30/02
100% Struct./CD Progress	07/01/02
Issue	Date
*New. Former A452 details on A620 dwgs.	

Job No. 9908

Scale AS NOTED


Date September 27, 2002

Title **MUSEUM BUILDING
INTERIOR DETAILS:
INTERIOR STOREFRONT
SYSTEMS**


Sheet No.

A452


FOR OFFICIAL USE ONLY

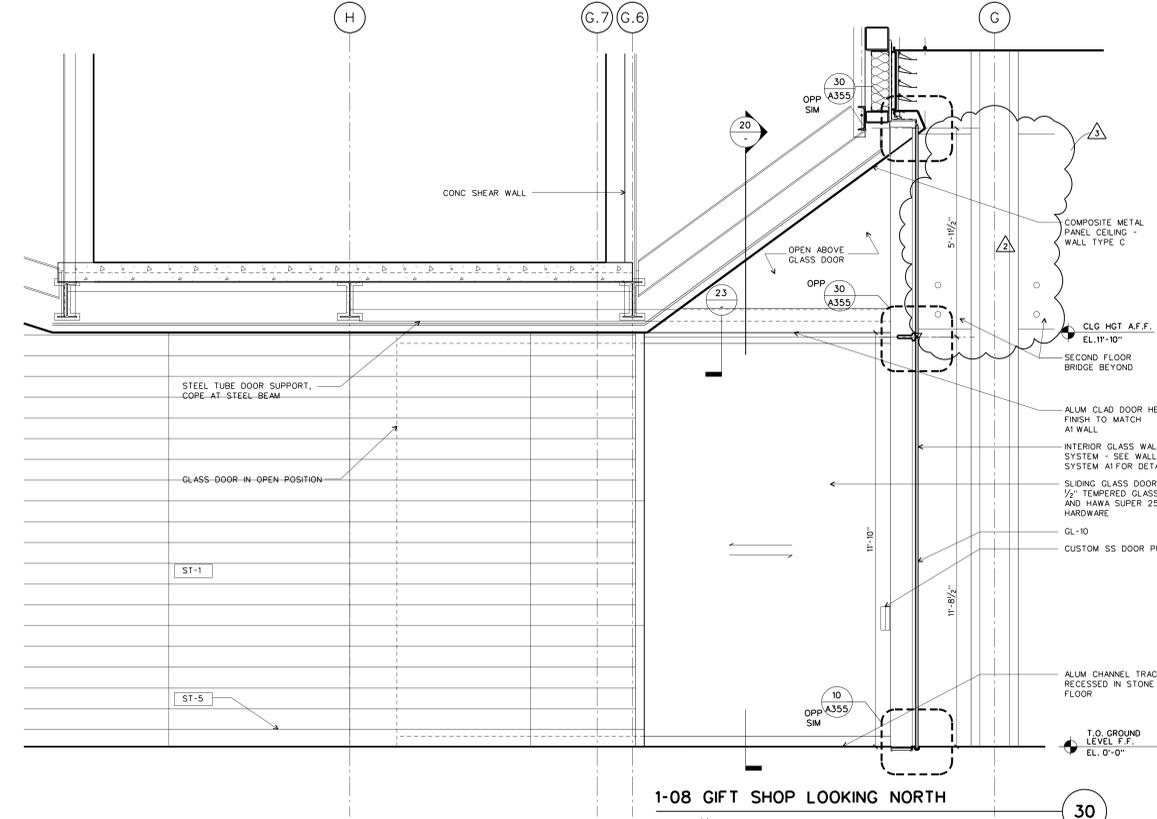


1-08 GIFT SHOP LOOKING NORTH
SCALE: 1/2" = 1'-0"
d-interiorglazing02 30

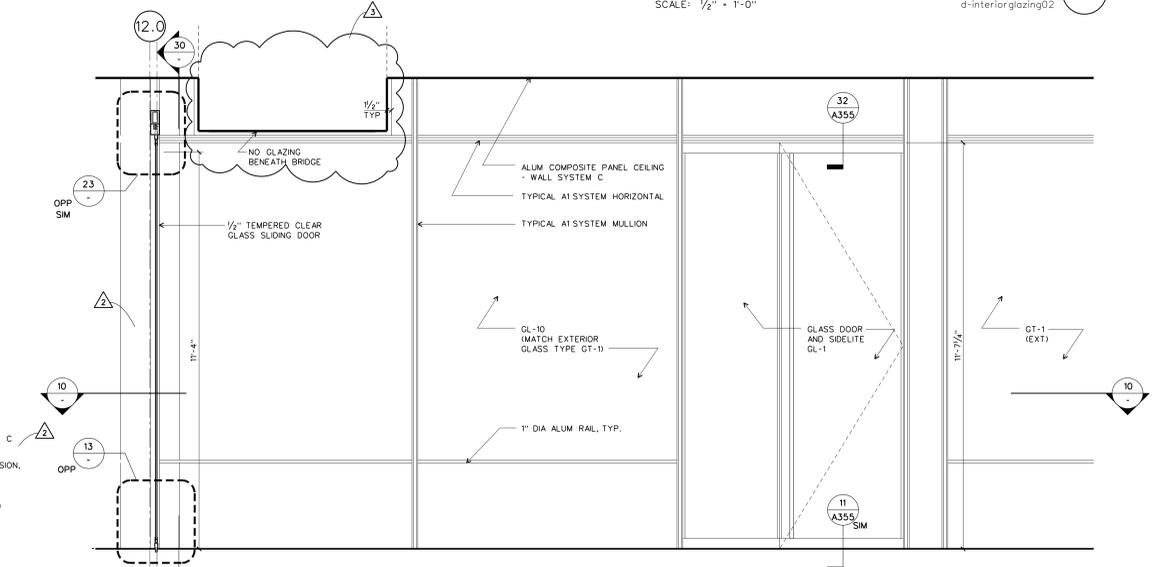


PARTIAL ELEVATION AT GIFT SHOP LOOKING EAST
SCALE: 1/2" = 1'-0"
D-INTERIOR-GLAZING-02 20

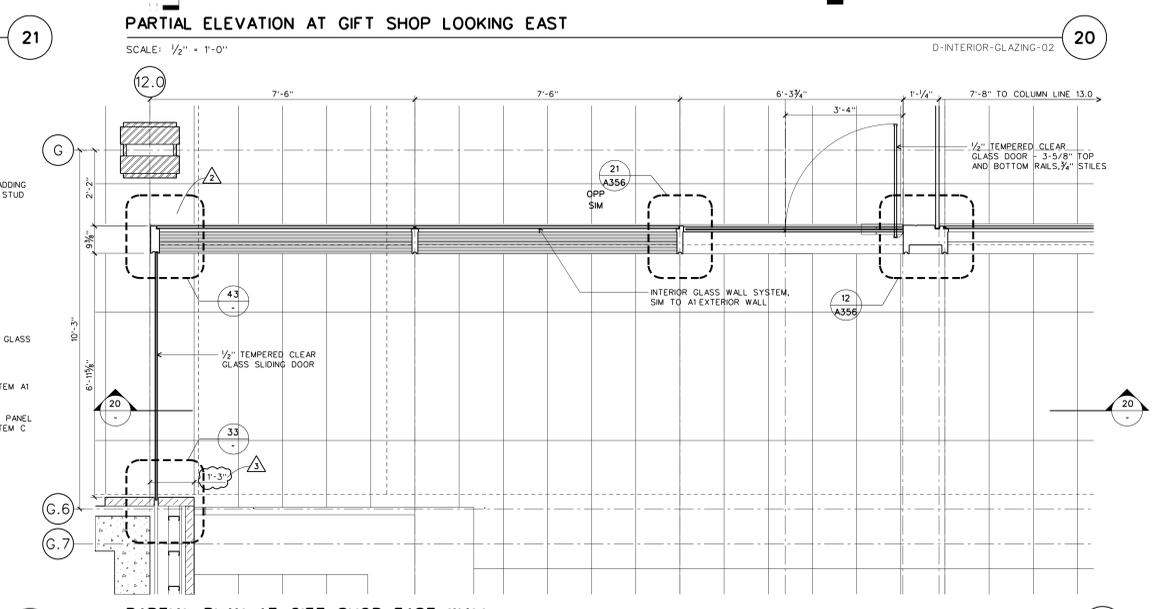


PARTIAL PLAN AT GIFT SHOP EAST WALL
SCALE: 1/2" = 1'-0"
D-INTERIOR-GLAZING-02 10

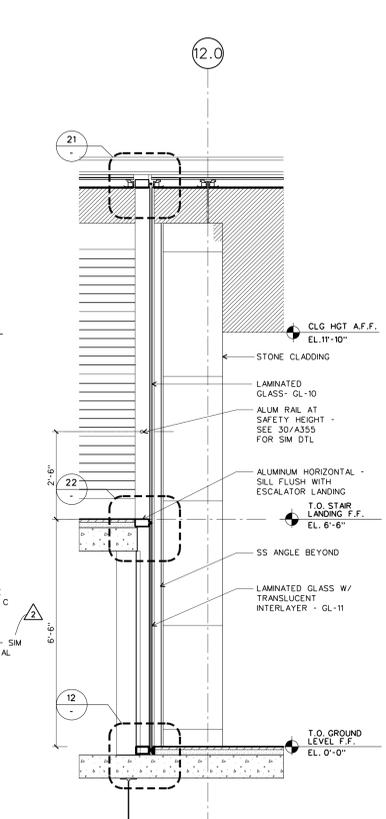


1-08 GIFT SHOP @ ESC LANDING
SCALE: 1/2" = 1'-0"
d-interiorglazing02 31

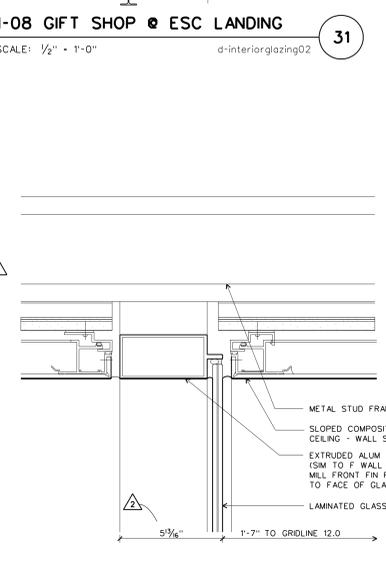


SECTION DETAIL AT GLASS WALL HEAD
SCALE: 1/2" = 1'-0"
d-interiorglazing02 21

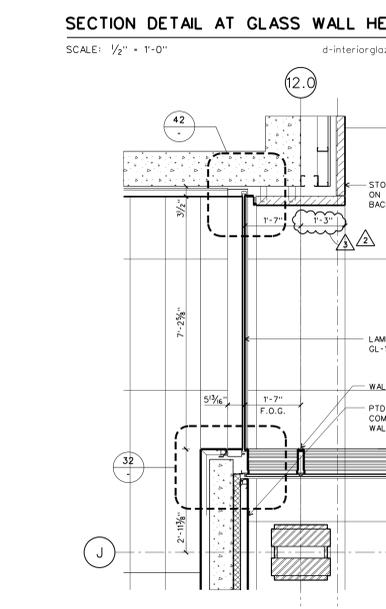


PARTIAL PLAN AT GIFT SHOP
SCALE: 1/2" = 1'-0"
d-interiorglazing02 11

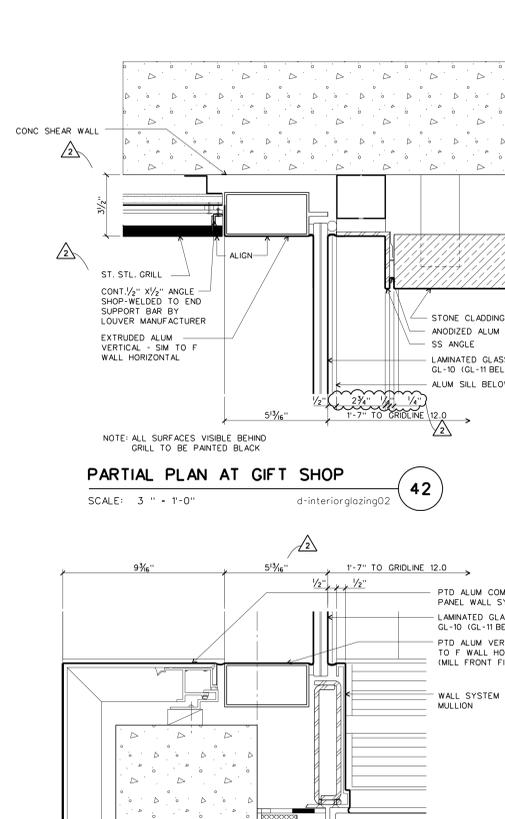


PARTIAL PLAN AT GIFT SHOP
SCALE: 3/4" = 1'-0"
d-interiorglazing02 42

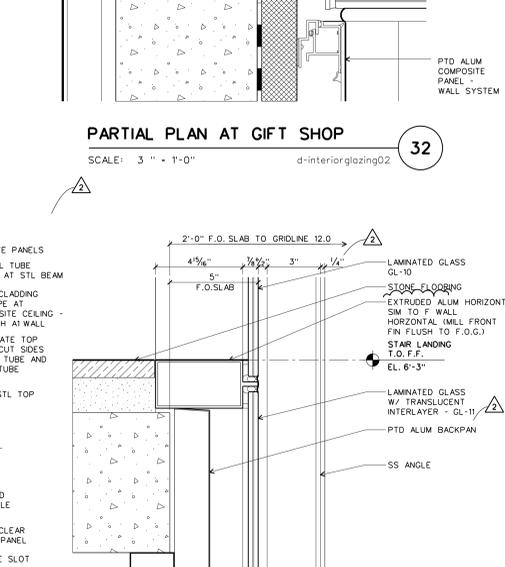


PARTIAL PLAN AT GIFT SHOP
SCALE: 3/4" = 1'-0"
d-interiorglazing02 32

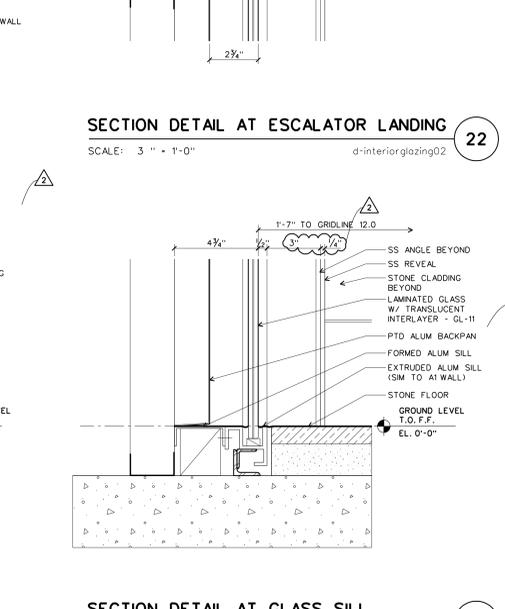


SECTION DETAIL AT ESCALATOR LANDING
SCALE: 3/4" = 1'-0"
d-interiorglazing02 22

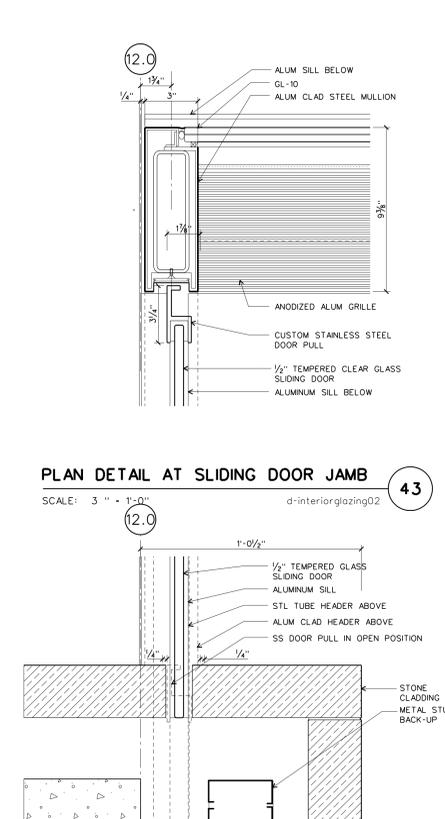


PLAN DETAIL AT SLIDING DOOR JAMB
SCALE: 3/4" = 1'-0"
d-interiorglazing02 43

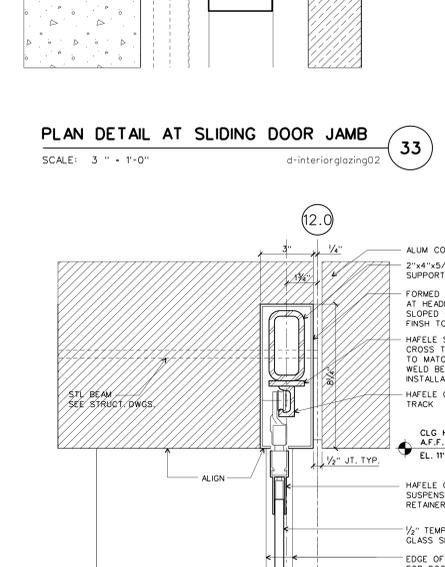

SECTION AT GIFT SHOP DOOR HEAD
SCALE: 3/4" = 1'-0"
d-interiorglazing02 23

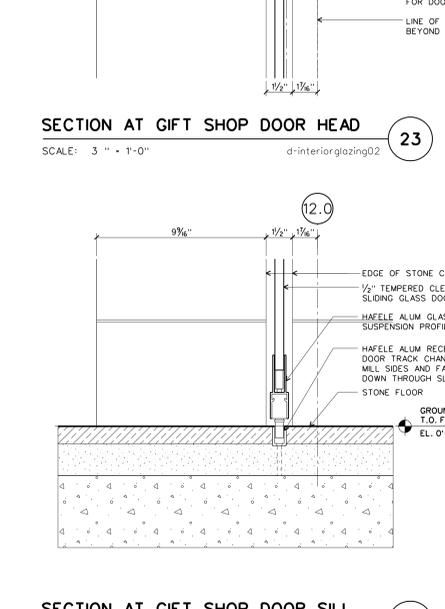

SECTION AT GIFT SHOP DOOR SILL
SCALE: 3/4" = 1'-0"
d-interiorglazing02 13

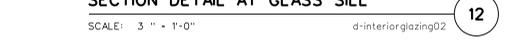

SECTION DETAIL AT GLASS SILL
SCALE: 3/4" = 1'-0"
d-interiorglazing02 12