

**WILLIAM J. CLINTON  
PRESIDENTIAL  
CENTER**

LITTLE ROCK, ARKANSAS

Architect

**POLSHEK PARTNERSHIP LLP**  
320 West 13th Street  
New York, New York 10014  
212.807.7171

Coordinating Architects

**POLK STANLEY YEARY ARCHITECTS Ltd**  
700 South Schiller Street  
Little Rock, Arkansas 72201  
501.378.0878

**WITSELL EVANS RASCO**

901 West Third Street  
Little Rock, Arkansas 72201  
501.374.5300

**WOODS CARADINE ARCHITECTS**

2200 South Main Street  
Little Rock, Arkansas 72206  
501.374.4060

Landscape Architects

**HARGREAVES ASSOCIATES**

118 Magazine Street  
Cambridge, Massachusetts 02139  
617.661.0070

**LANDSCAPE ARCHITECTURE, Inc.**

2300 Cottondale Lane Suite 202  
Little Rock, Arkansas 72202  
501.374.5810

Structural Engineer

**LESLIE E. ROBERTSON ASSOC., RLLP**

30 Broad Street, 47th Floor  
New York, New York 10004  
212.750.9000

MEP Engineers

**FLACK + KURTZ, Inc.**

475 Fifth Avenue  
New York, New York 10017  
212.532.9600

**CROMWELL ARCHITECTS ENGINEERS**

101 South Spring Street  
Little Rock, Arkansas 72201  
501.372.2900


Curtainwall Consultant

**R. A. HEINTGES ARCHITECTS**

126 Fifth Avenue, 9th Floor  
New York, New York 10011  
212.652.2968

Seal

ASI #23	09/12/03
ASI #20	08/06/03
Addendum #7	12/20/02
100% Construction Documents	09/27/02
90% Progress Printing	08/30/02
100% Struct./CD Progress	07/01/02
Issue	Date

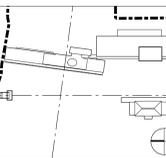

Job No. 9908

Scale 1'-1 1/2" / 3" = 1'-0"

Date September 27, 2002


Title

**MUSEUM BUILDING  
INTERIOR DETAILS:  
STONE**

Sheet No.


**A455**

FOR OFFICIAL USE ONLY

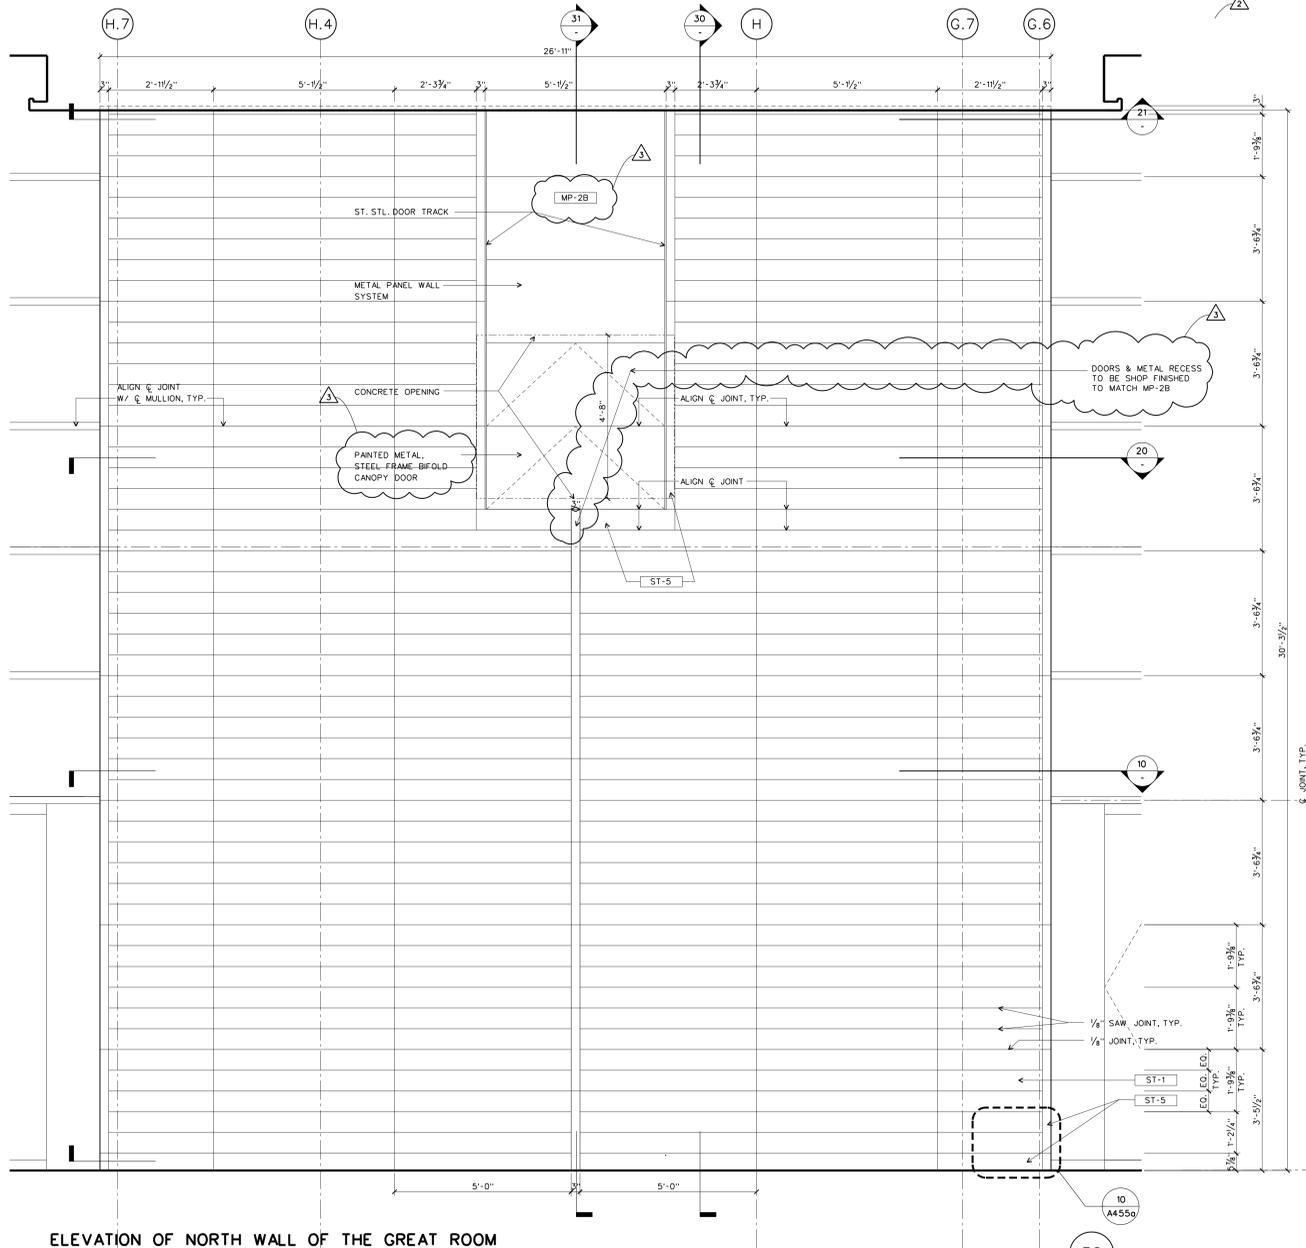

**ELEVATION OF NORTH WALL OF THE GREAT ROOM**

SCALE: 1/2" = 1'-0"

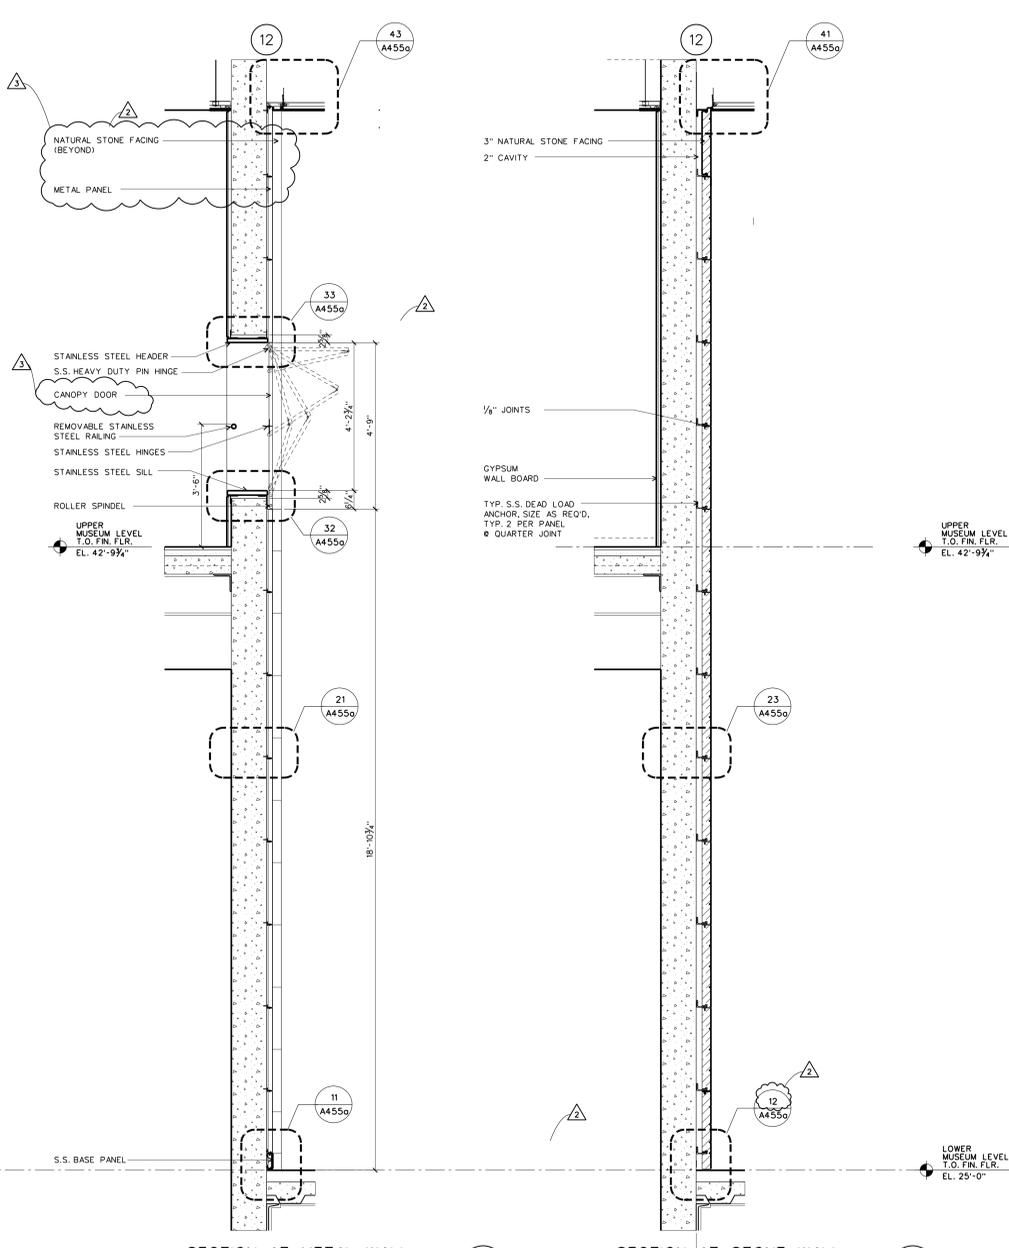


**SECTION AT METAL WALL**

SCALE: 1/2" = 1'-0"


**SECTION AT STONE WALL**

SCALE: 1/2" = 1'-0"

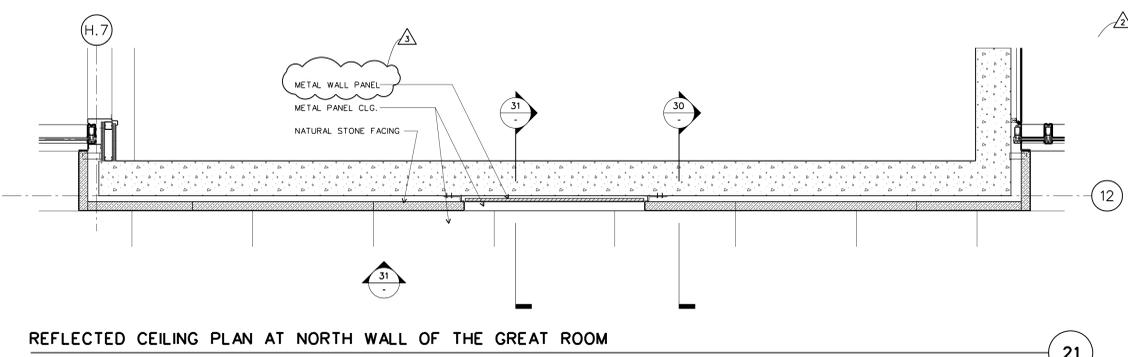


**REFLECTED CEILING PLAN AT NORTH WALL OF THE GREAT ROOM**

SCALE: 1/2" = 1'-0"

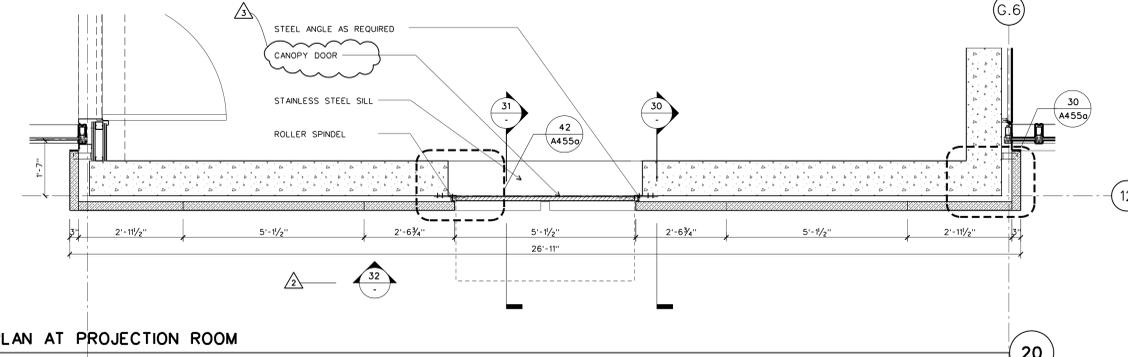

**PLAN AT PROJECTION ROOM**

SCALE: 1/2" = 1'-0"

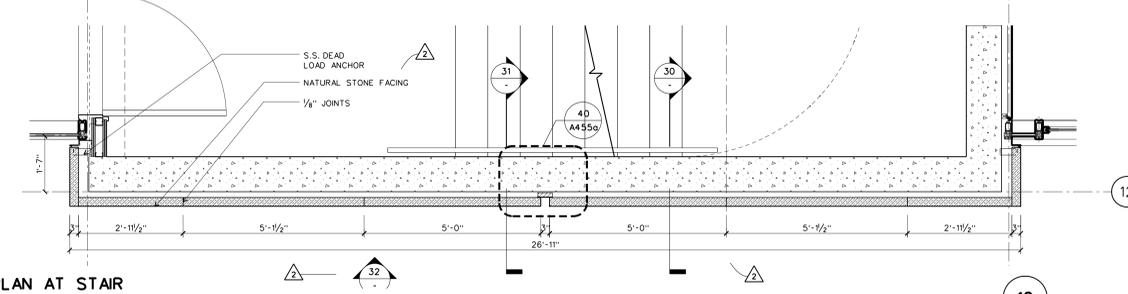

**PLAN AT STAIR**

SCALE: 1/2" = 1'-0"