


Seal

ASI #25	12/19/03
ASI #24	10/24/03
Issue	Date

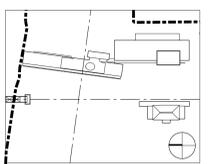

Job No. 9908

Scale As Noted

Date September 27, 2002


Title

MUSEUM BUILDING
INTERIOR DETAILS

Sheet No.


A456a

FOR OFFICIAL USE ONLY

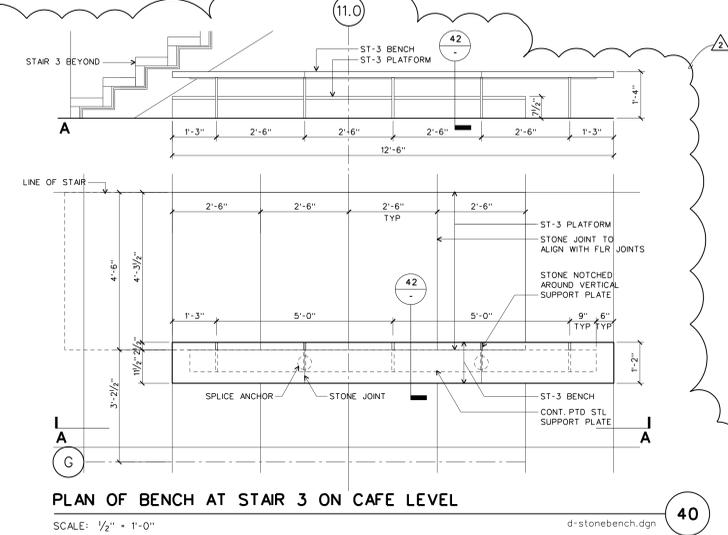


PLAN OF BENCH AT STAIR 3 ON CAFE LEVEL

SCALE: 1/2" = 1'-0"

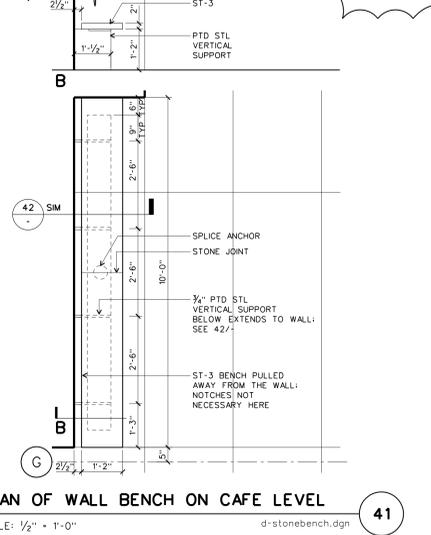


PLAN OF WALL BENCH ON CAFE LEVEL

SCALE: 1/2" = 1'-0"

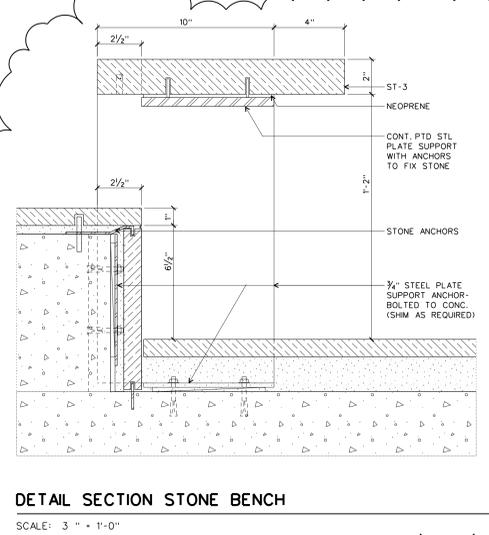


DETAIL SECTION STONE BENCH

SCALE: 3/4" = 1'-0"

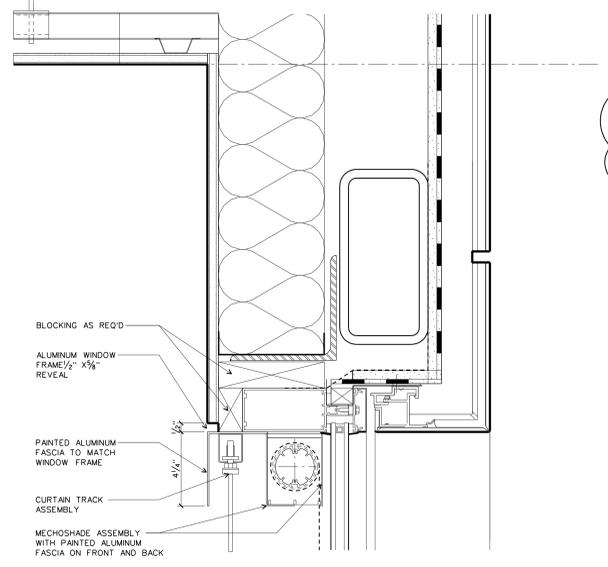


DETAIL AT MECHOSHADE AND WINDOW IN GREEN ROOM

SCALE: 3/4" = 1'-0"

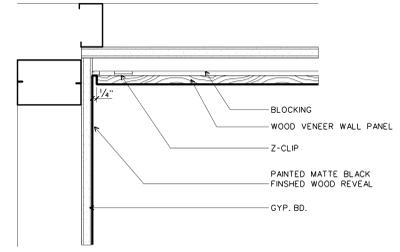

DETAIL AT WOOD VENEER WALL AND GYP. BD. WALL


SCALE: 3/4" = 1'-0"

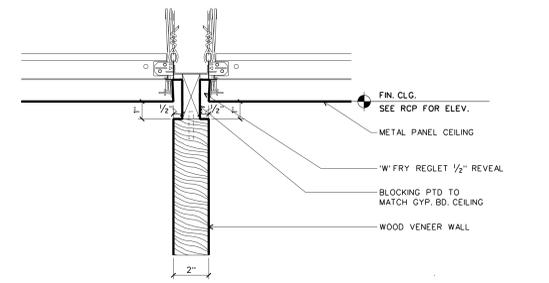

DETAIL AT WOOD WALL IN VESTIBULE


SCALE: 3/4" = 1'-0"

NOT USED

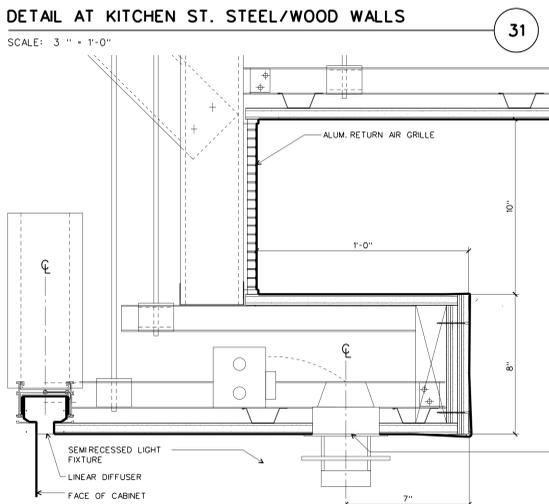


DETAIL AT CEILING SOFFIT IN KITCHEN

SCALE: 3/4" = 1'-0"

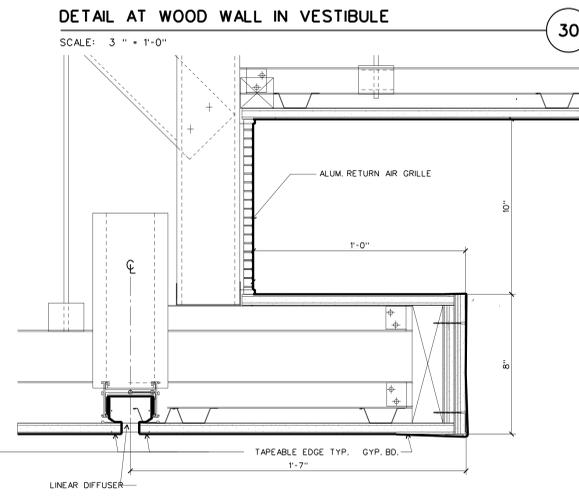

DETAIL AT CEILING SOFFIT IN GREEN ROOM


SCALE: 3/4" = 1'-0"

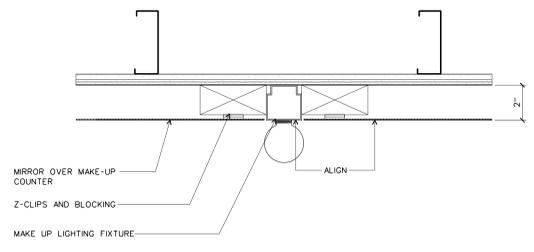

DETAIL AT MIRROR MAKE UP LIGHT FIXTURE


SCALE: 3/4" = 1'-0"

NOT USED

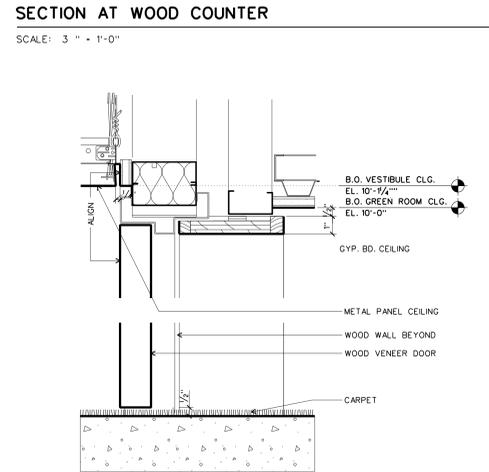


SECTION DETAIL AT GREEN ROOM DOOR

SCALE: 3/4" = 1'-0"

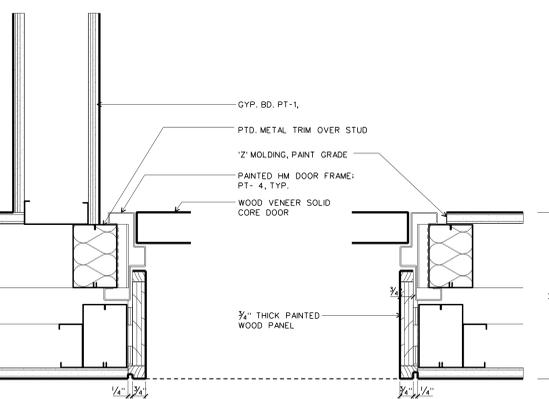


PLAN DETAIL AT GREEN ROOM DOOR

SCALE: 3/4" = 1'-0"

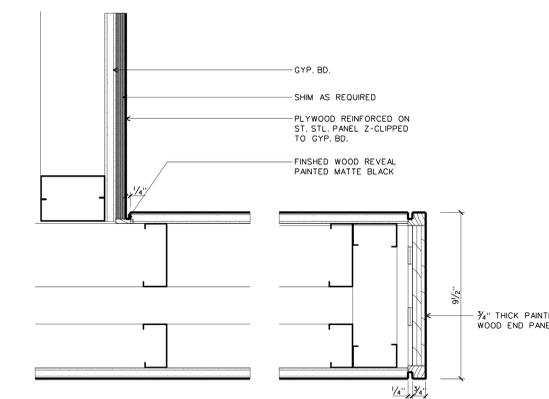

PLAN DETAIL AT GREEN ROOM WALL

SCALE: 3/4" = 1'-0"

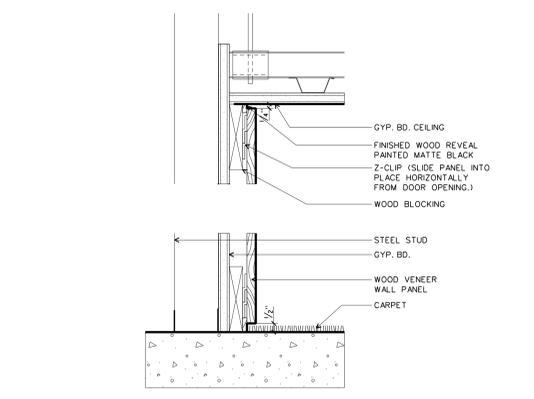

WOOD VENEER WALL AT CEILING AND BASE

SCALE: 3/4" = 1'-0"