


HEAD DETAIL AT SERVERY OPENING

SCALE: 3" = 1'-0"

details/dtl-wd-02.dgn

43

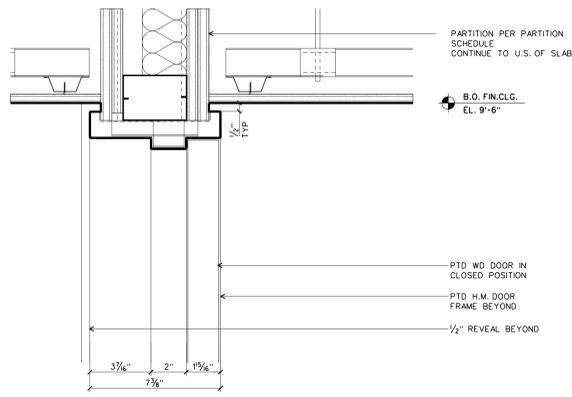


HEAD DETAIL AT HOLD OPEN DOOR

SCALE: 3" = 1'-0"


details/dtl-wd-02.dgn

42

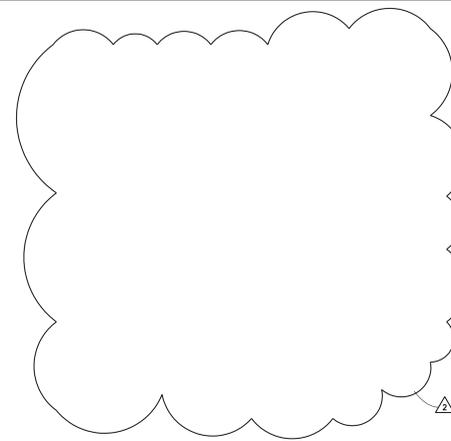


NOT USED

41

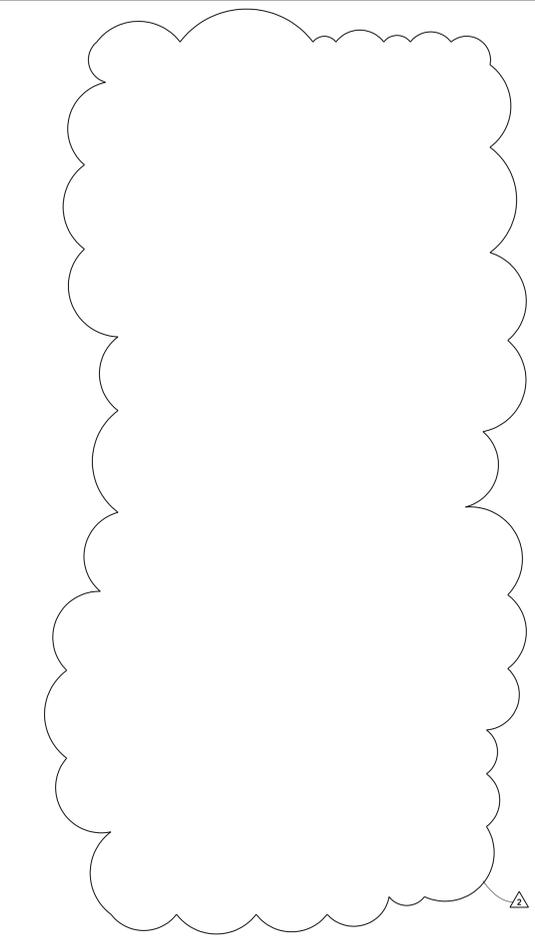

NOT USED

30

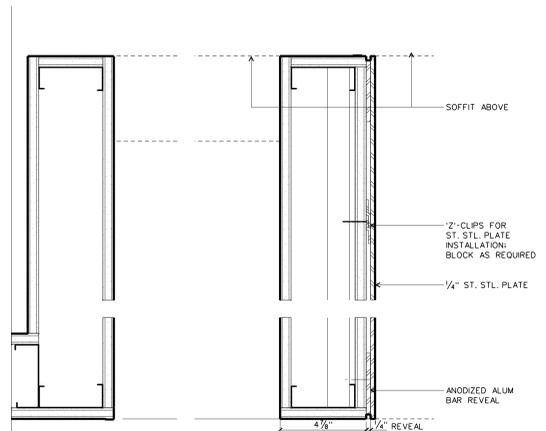


PLAN DETAIL AT SERVERY OPENING

SCALE: 3" = 1'-0"

details/dtl-wd-02.dgn

33

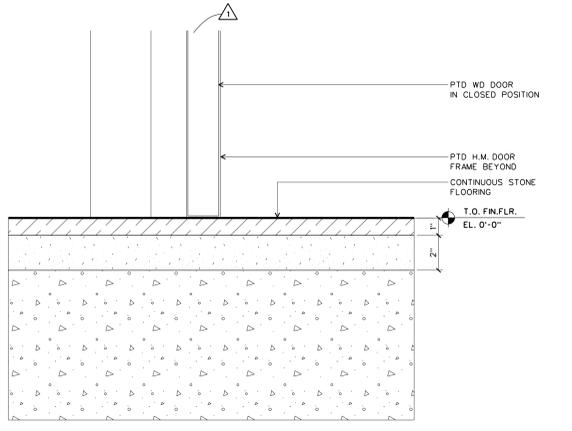


SILL DETAIL AT HOLD OPEN DOOR

SCALE: 3" = 1'-0"

details/dtl-wd-02.dgn

32

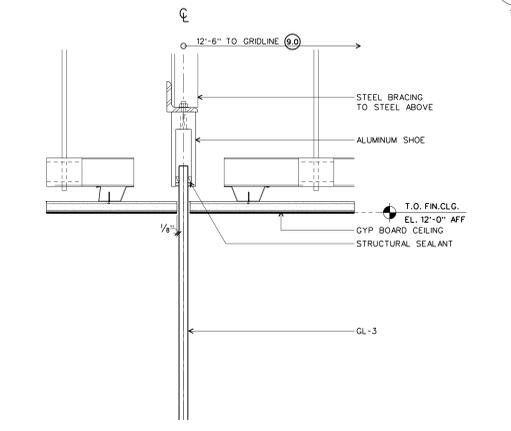


HEAD DETAIL AT FULL-HGT GLASS PARTITION

SCALE: 3" = 1'-0"

details/dtl-wd-02.dgn

31

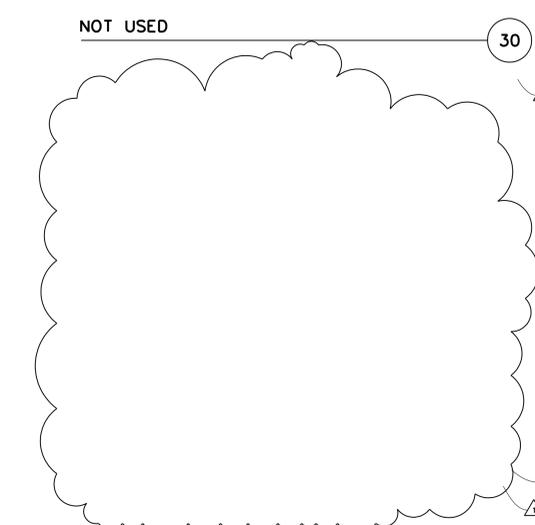


NOT USED

20

NOT USED

23

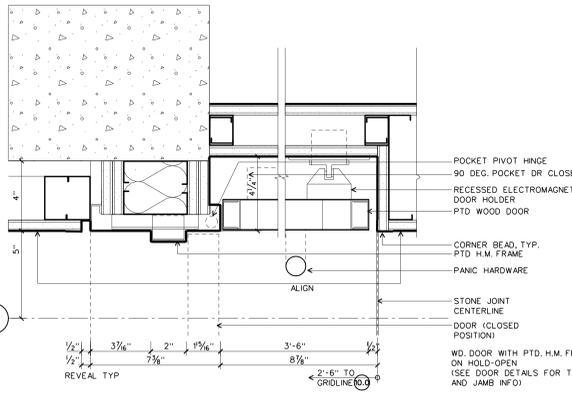


JAMB DETAIL AT HOLD OPEN DOOR

SCALE: 3" = 1'-0"

details/dtl-wd-02.dgn

22

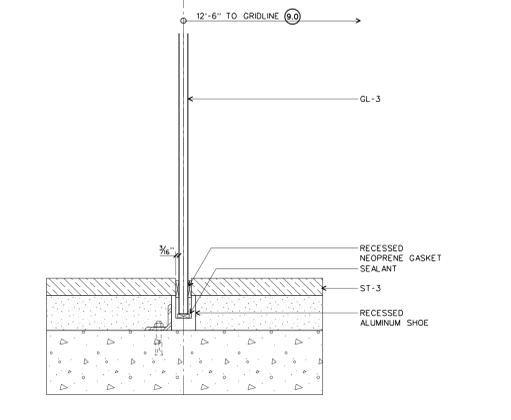


BASE DETAIL AT FULL-HGT GLASS PARTITION

SCALE: 3" = 1'-0"


details/dtl-wd-02.dgn

21

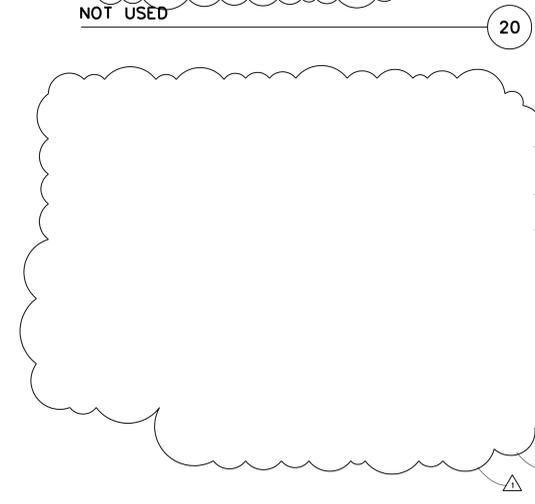

NOT USED

10

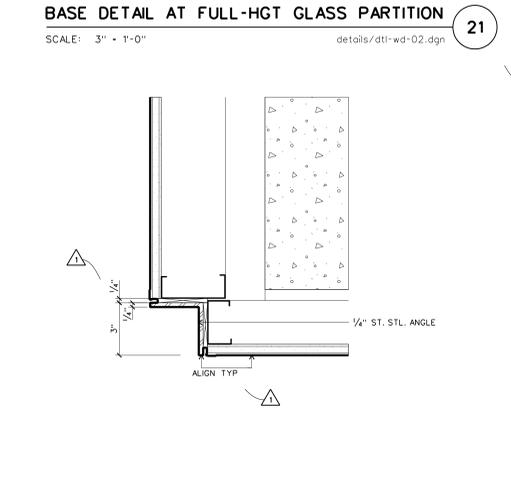

TYP. CORNER CONDITION

SCALE: 3" = 1'-0"

details/dtl-wd-02.dgn

11

NOT USED

13

NOT USED

12

**WILLIAM J. CLINTON
PRESIDENTIAL
CENTER**

LITTLE ROCK, ARKANSAS

Architect

POLSHEK PARTNERSHIP LLP
320 West 13th Street
New York, New York 10014
212.807.7171

Coordinating Architects

POLK STANLEY YEARY ARCHITECTS Ltd
700 South Schiller Street
Little Rock, Arkansas 72201
501.378.0878

WITSELL EVANS RASCO

901 West Third Street
Little Rock, Arkansas 72201
501.374.5300

WOODS CARADINE ARCHITECTS

2200 South Main Street
Little Rock, Arkansas 72206
501.374.4960

Landscape Architects

HARGREAVES ASSOCIATES

118 Magazine Street
Cambridge, Massachusetts 02139
617.661.0070

LANDSCAPE ARCHITECTURE, Inc.

2300 Cottontale Lane Suite 202
Little Rock, Arkansas 72202
501.374.5810

Structural Engineer

LESLIE E. ROBERTSON ASSOC., RLLP

30 Broad Street, 47th Floor
New York, New York 10004
212.750.9000

MEP Engineers

FLACK + KURTZ, Inc.

475 Fifth Avenue
New York, New York 10017
212.532.9600

CROMWELL ARCHITECTS ENGINEERS

101 South Spring Street
Little Rock, Arkansas 72201
501.372.2900


Curtainwall Consultant

R. A. HEINTGES ARCHITECTS

126 Fifth Avenue, 9th Floor
New York, New York 10011
212.652.2968

Seal

Issue	Date
ASI #23	09/12/03
ASI #20	08/06/03
100% Construction Documents	09/27/02
100% Struct./ CD Progress	07/01/02

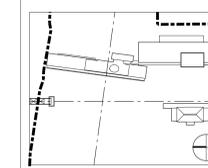

Job No. 9908

Scale

Date September 27, 2002

Title

MUSEUM BUILDING
WOOD PANEL
SYSTEM: DETAILS

Sheet No.

A458

FOR OFFICIAL USE ONLY