


▲ ASI #23	09/12/03
▲ ASI #20	06/06/03
▲ ASI #18	04/18/03
▲ ASI #15	02/28/03
100% Construction Documents	09/27/02
100% Struct./CD Progress	07/01/02
Issue	Date

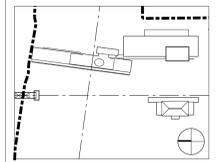

Job No. 9908

Scale

Date

September 27, 2002


Title

**MUSEUM BUILDING  
WOOD PANEL  
SYSTEM: DETAILS**

Sheet No.


**A459**

FOR OFFICIAL USE ONLY

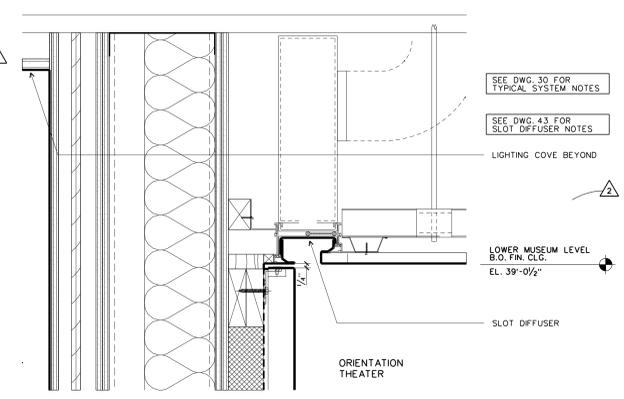


**PANEL CEILING DETAIL  
AT ORIENTATION THEATER**

SCALE: 3" = 1'-0" details/dtl-wd-03

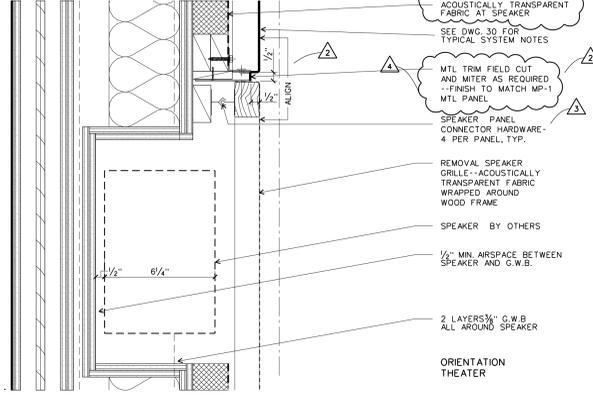


**WOOD PANEL DETAIL AT WALL SPEAKER**

SCALE: 3" = 1'-0" details/dtl-wd-03

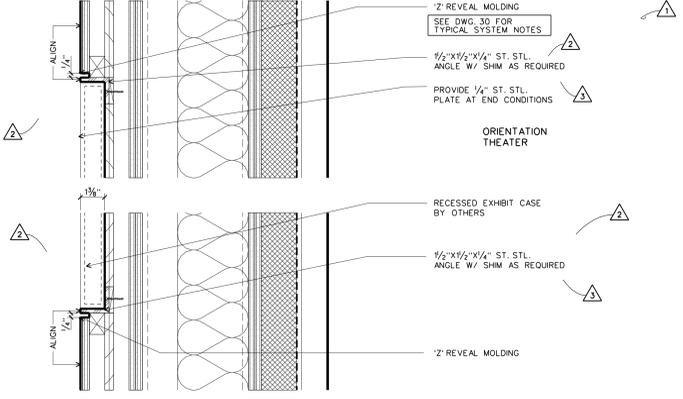


**EXHIBIT DETAIL**

SCALE: 3" = 1'-0" details/dtl-wd-03

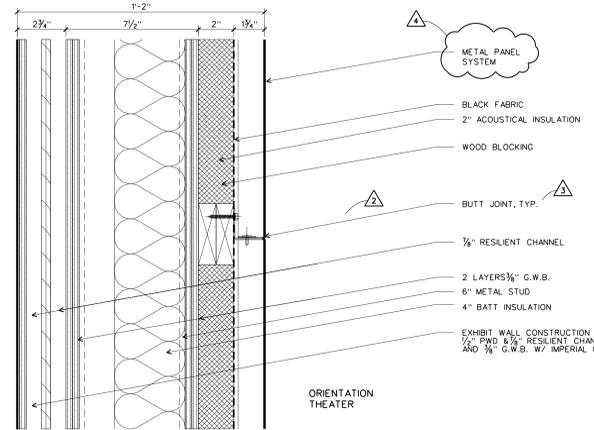


**PANEL HORIZ. JOINT AT  
ORIENTATION THEATER**

SCALE: 3" = 1'-0" details/dtl-wd-03

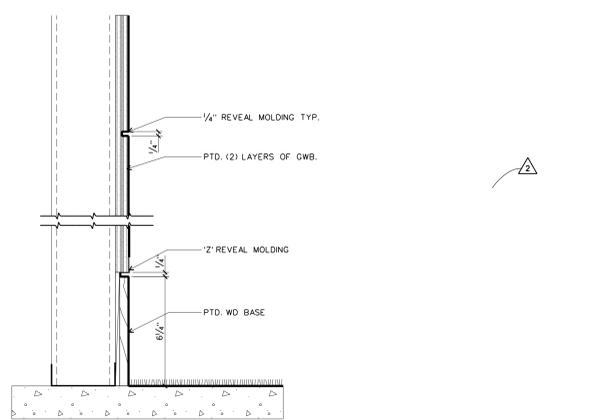


**GWB. AND BASE  
AT ORIENTATION THEATER**

SCALE: 3" = 1'-0" details/dtl-wd-03

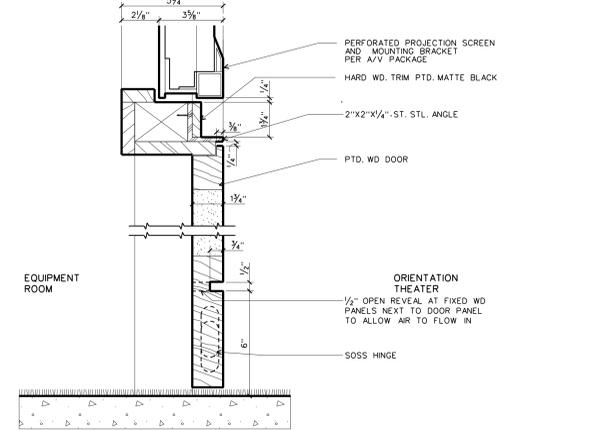


**ACCESS PANEL DOOR HEAD & SILL  
AT ORIENTATION THEATER**

SCALE: 3" = 1'-0" details/dtl-wd-03

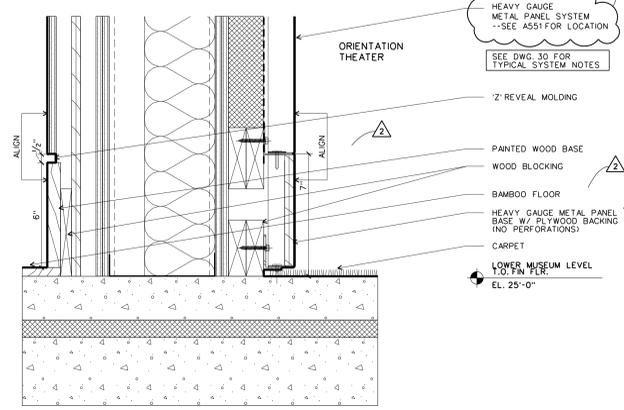


**PANEL BASE DETAIL  
AT ORIENTATION THEATER**

SCALE: 3" = 1'-0" details/dtl-wd-03

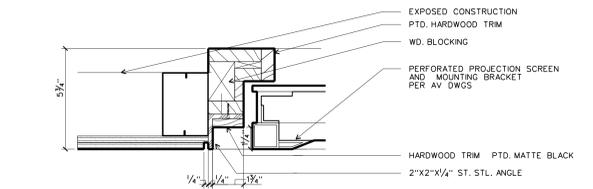


**PROJECTION SCREEN FRAME**

SCALE: 3" = 1'-0" details/dtl-wd-03

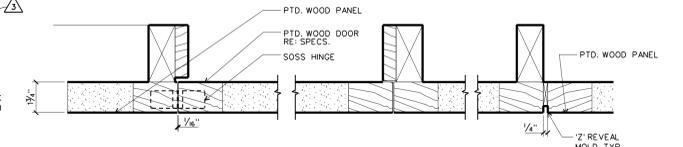


**ACCESS PANEL DOOR JAMB  
AT ORIENTATION THEATER**

SCALE: 3" = 1'-0" details/dtl-wd-03

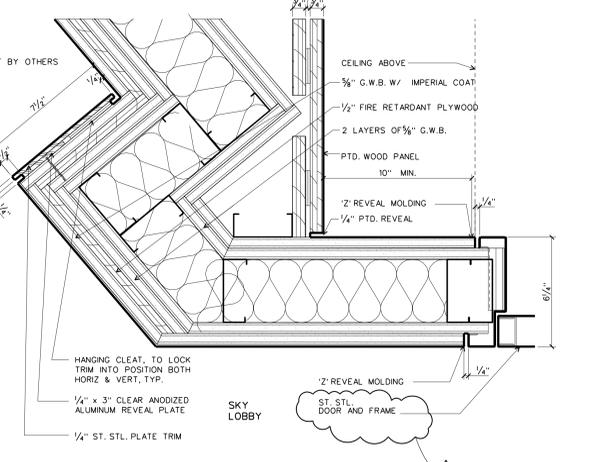


**PLAN DETAIL  
AT ORIENTATION THEATER**

SCALE: 3" = 1'-0" details/dtl-wd-03

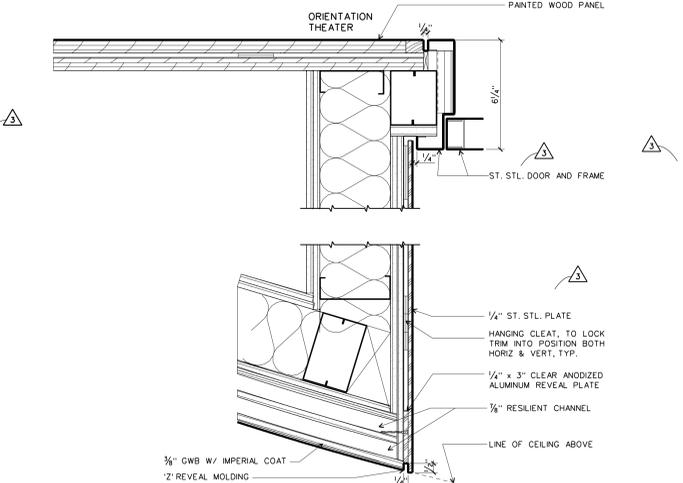


**PLAN DETAIL  
AT ORIENTATION THEATER**

SCALE: 3" = 1'-0" details/dtl-wd-03

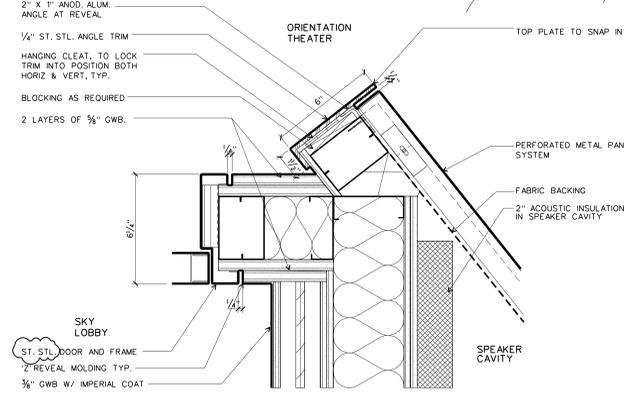

**PLAN DETAIL  
AT ORIENTATION THEATER**

SCALE: 3" = 1'-0" details/dtl-wd-03

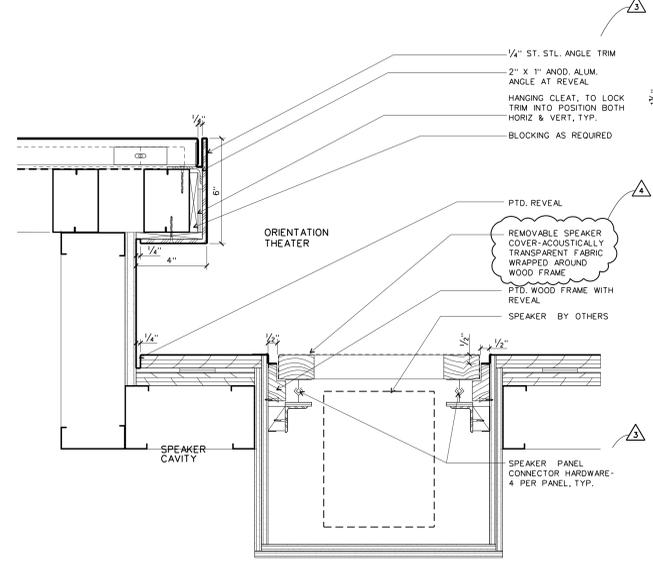

**PLAN DETAIL  
AT ORIENTATION THEATER**

SCALE: 3" = 1'-0" details/dtl-wd-02