


▲ ASI # 25	12/19/03
▲ ASI # 23	09/12/03
▲ ASI # 20	08/06/03
▲ ASI # 18	04/18/03
100% Construction Documents	09/27/02
100% Struct./ CD Progress	07/01/02
Issue	Date

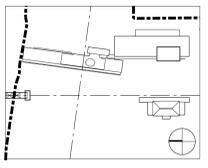

Job No. 9908

Scale

Date September 27, 2002

Title


**MUSEUM BUILDING
WOOD PANEL
SYSTEM: DETAILS**

Sheet No.

A460


FOR OFFICIAL USE ONLY

SECTION DETAIL OF WOOD PANEL AT HORIZONTAL MULLION

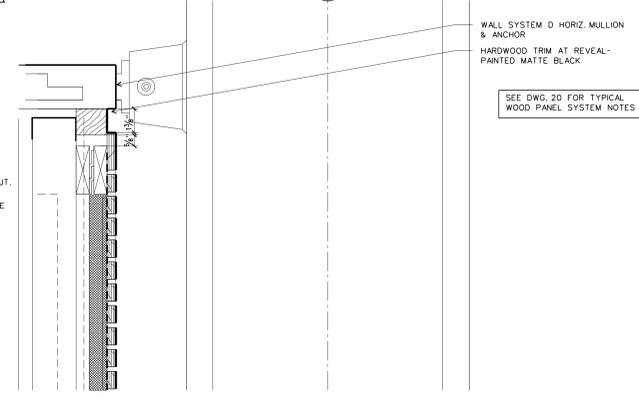


SCALE: 3"=1'-0"

BASE DETAIL OF WOOD PANEL AT UPPER MUSEUM LEVEL

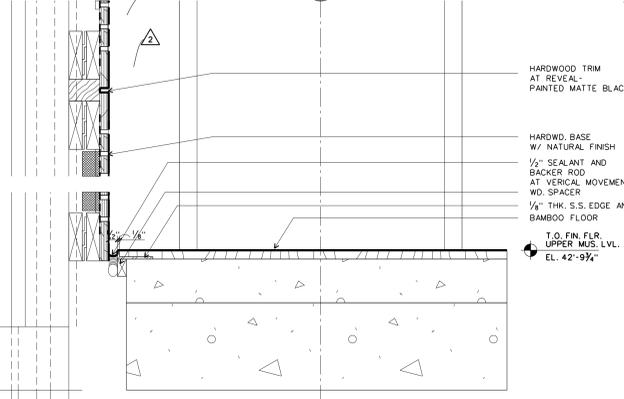


SCALE: 3"=1'-0"

FLOOR DETAIL AT UPPER MUSEUM LEVEL CORE LOBBY

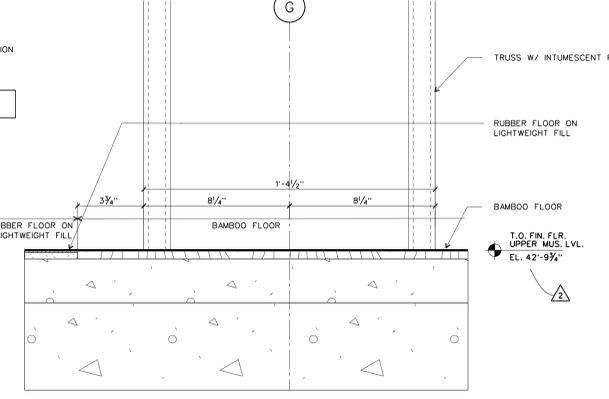


SCALE: 3"=1'-0"

BASE DETAIL AT GALLERY WALL UPPER MUSEUM LEVEL

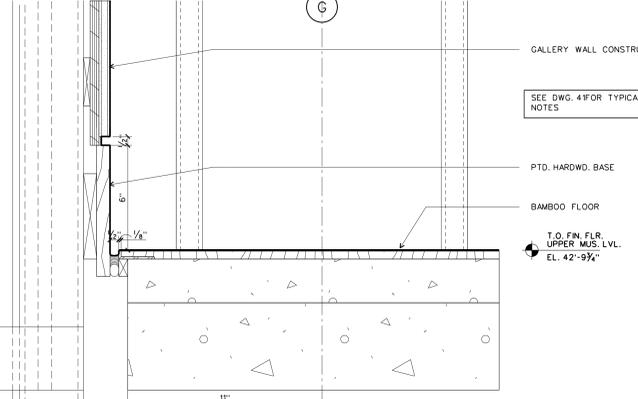


SCALE: 3"=1'-0"

TYP. HORIZ. JOINT AT WOOD PANEL (VERTICAL SIMILAR)

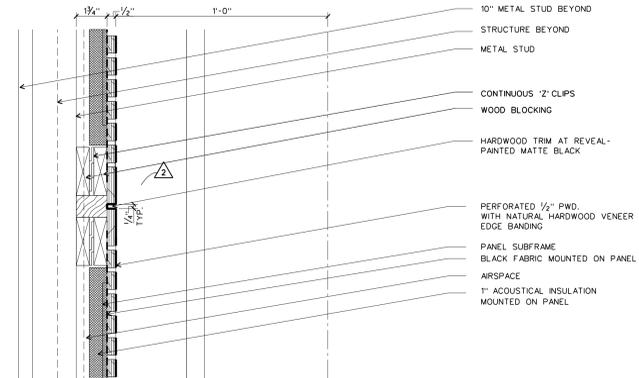


SCALE: 3"=1'-0"

LOWER MUSEUM LEVEL CEILING DETAIL AT WOOD PANEL

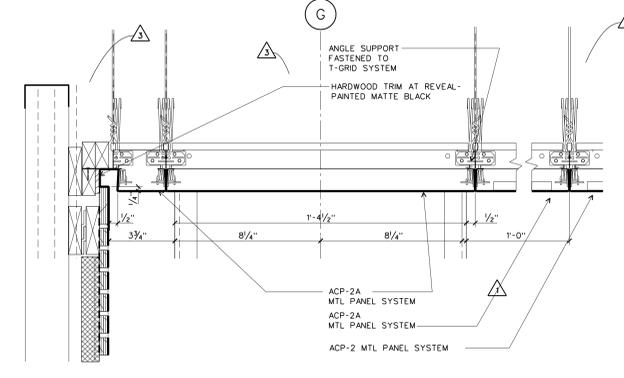


SCALE: 3"=1'-0"

LOWER MUSEUM LEVEL CEILING DETAIL AT CORE LOBBY

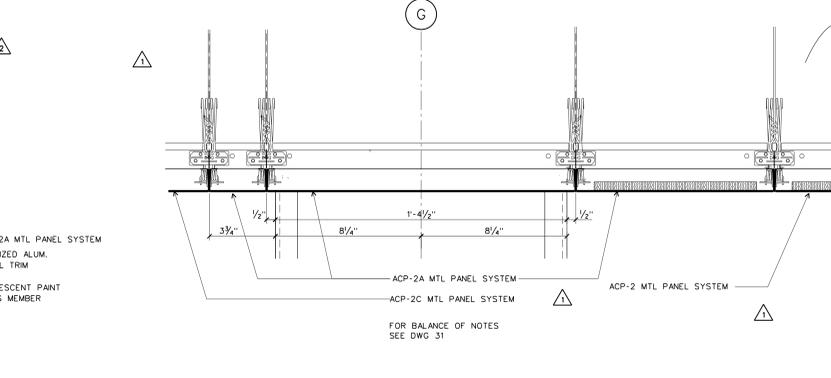


SCALE: 3"=1'-0"

LOWER MUSEUM LEVEL CEILING DETAIL AT TRUSS

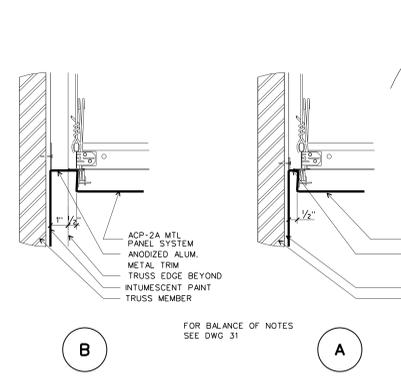


SCALE: 3"=1'-0"

BASE DETAIL AT WOOD PANEL LOWER MUSEUM LEVEL

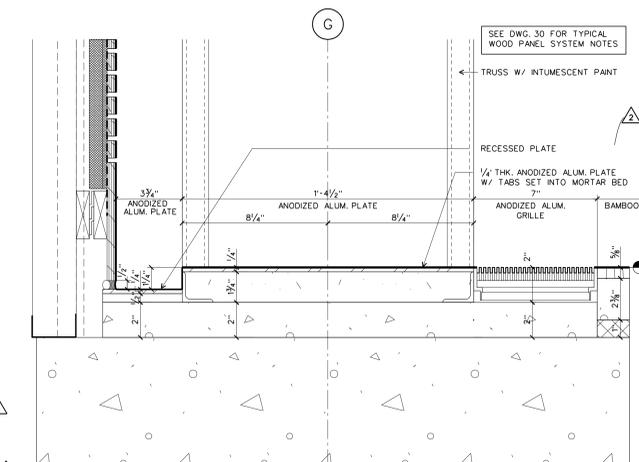


SCALE: 3"=1'-0"

PLAN DETAIL AT PANTRY DOOR (HD SIM)

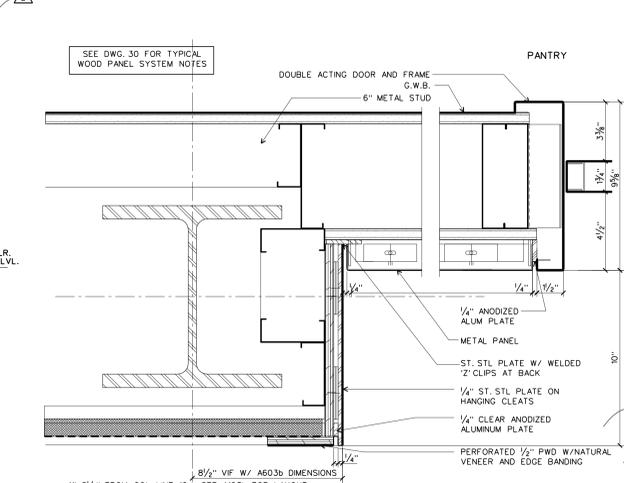


SCALE: 3"=1'-0"

FLOOR DETAIL AT LOWER MUSEUM LEVEL CORE LOBBY

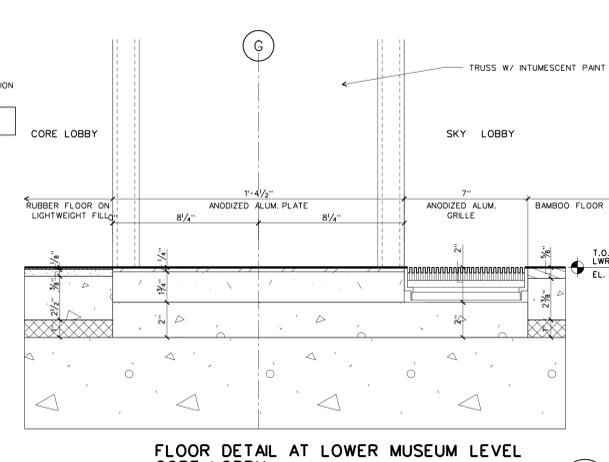


SCALE: 3"=1'-0"

BASE DETAIL AT GALLERY WALL LOWER MUSEUM LEVEL

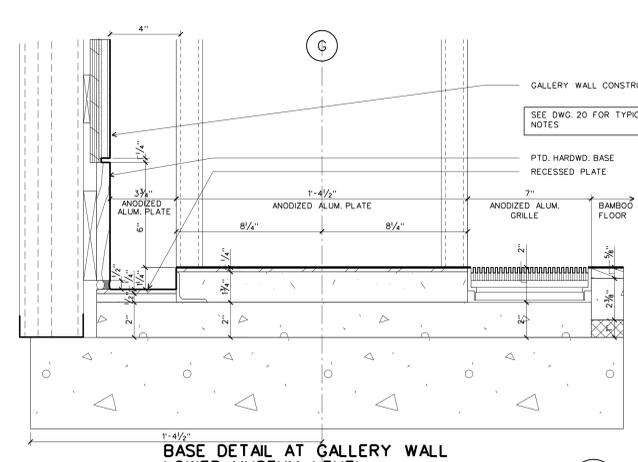


SCALE: 3"=1'-0"

ELEV. OF PERF. PATTERN AT WALL WOOD PANEL

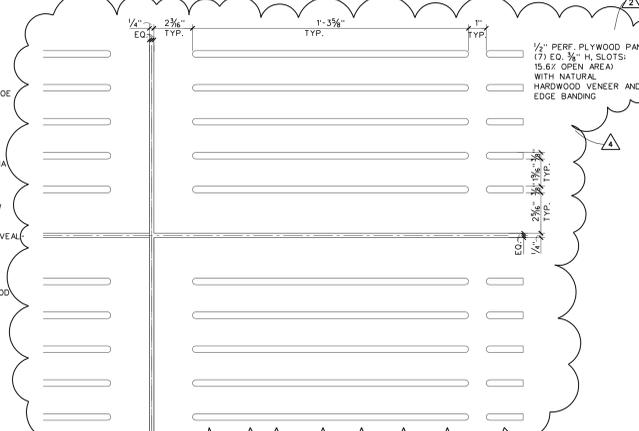


SCALE: 3"=1'-0"

VERTICAL JOINT AT UPPER MUSEUM LEVEL BASE

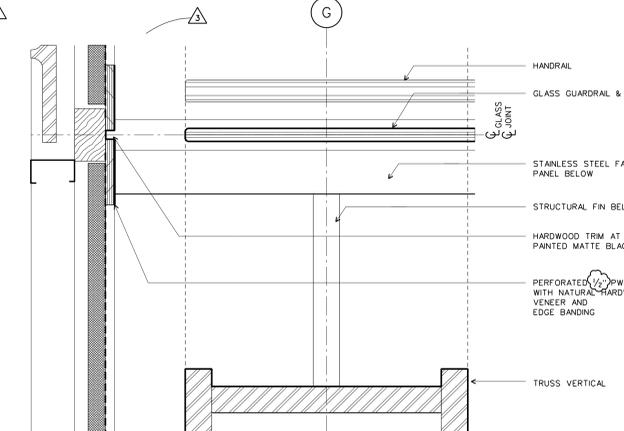


SCALE: 3"=1'-0"

TYPICAL BASE DETAIL AT TRUSS MEMBERS - UPPER MUSEUM LEVEL

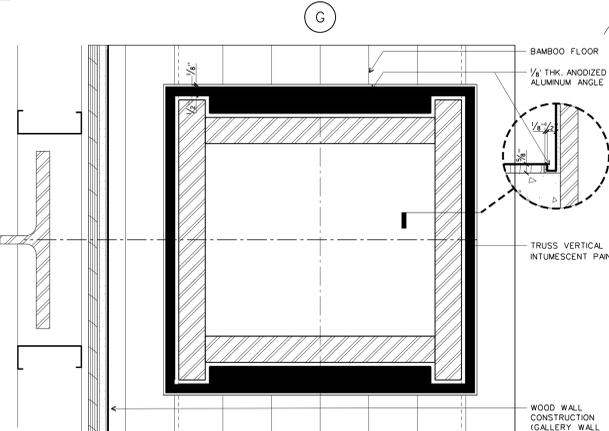

SCALE: 3"=1'-0"

ENLARGED REFLECTED CEILING PLAN AT TRUSS

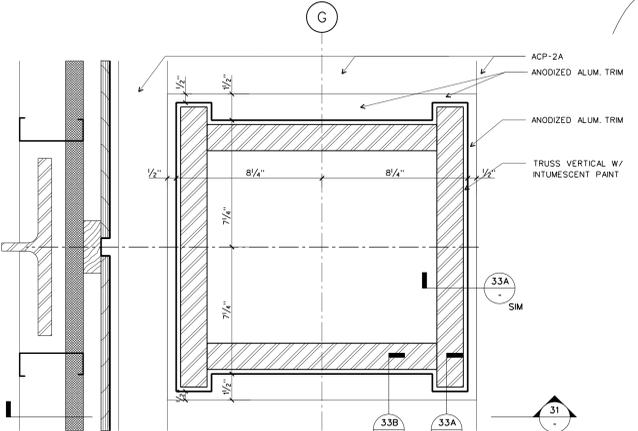

SCALE: 3"=1'-0"