


▲ ASI #23	09/12/03
▲ ASI #20	08/06/03
▲ ASI #19	05/07/03
▲ ASI #18	04/18/03
▲ Addendum #2	11/16/02
100% Construction Documents	09/27/02
Issue	Date

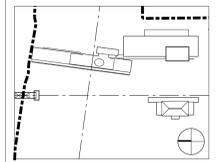


Job No. 9908
Scale 3" = 1'-0"
Date September 27, 2002
Title


CEILING DETAILS

Sheet No. **A461**


FOR OFFICIAL USE ONLY

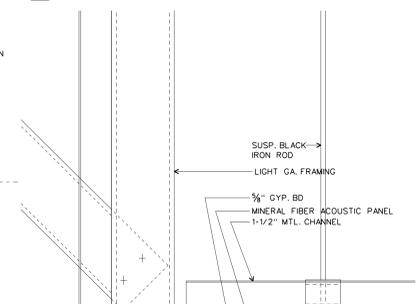


TYP. DETAIL AT METAL PANEL CEILING AT STAIR 4 & 5
SCALE: 3" = 1'-0"
D-CEILING-1.DGN

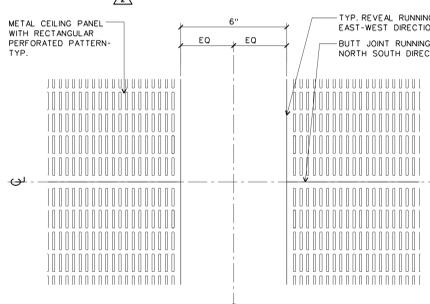


ENLARGED PLAN OF TYPICAL WOOD FINISH PERFORATED PANEL PATTERN
SCALE: 3" = 1'-0"
D-CEILING-1.DGN

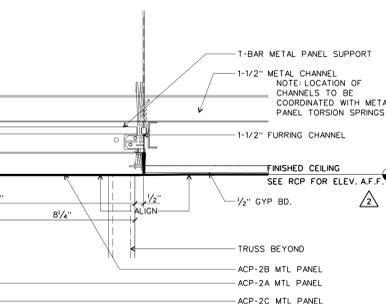


DETAIL AT TRUSS AT UPPER MUSEUM LEVEL CEILING
SCALE: 3" = 1'-0"
D-CEILING-1.DGN

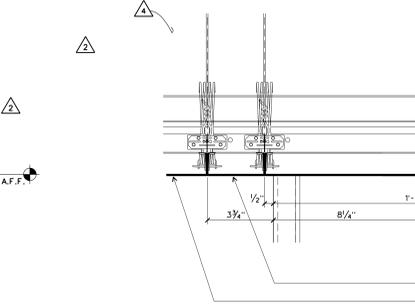


TYP. DETAIL AT METAL PANEL CEILING AT STAIR 4 & 5
SCALE: 3" = 1'-0"
D-CEILING-1.DGN

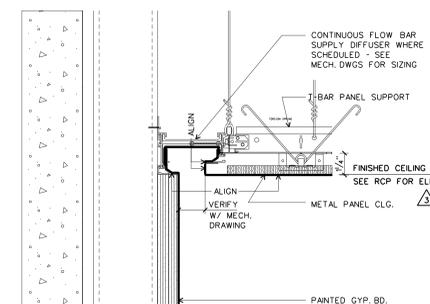


DETAIL AT METAL PANEL & GYP. BD CEILING
SCALE: 3" = 1'-0"
D-CEILING-1.DGN

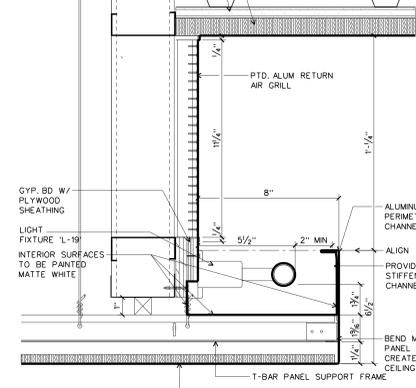


LIGHT COVE DETAIL AT UPPER MUSEUM LEVEL CEILING
SCALE: 3" = 1'-0"
D-CEILING-1.DGN

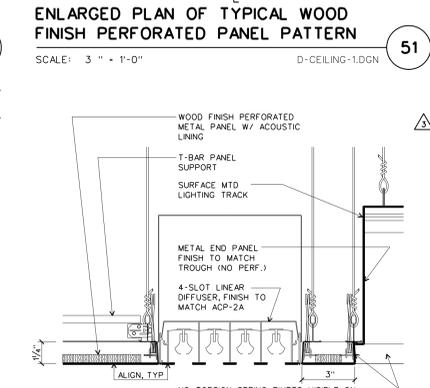

LINEAR SLOT DIFFUSER DETAIL AT UPPER MUSEUM LEVEL CEILING
SCALE: 3" = 1'-0"
D-CEILING-1.DGN

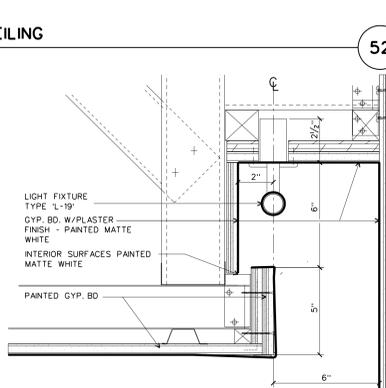


UPPER MUSEUM LEVEL LIGHT COVE DETAIL AT OVAL OFFICE
SCALE: 3" = 1'-0"
D-CEILING-1.DGN

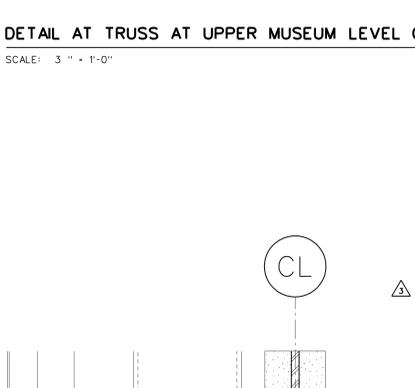


LOWER MUSEUM LEVEL LIGHT COVE DETAIL AT ORIENTATION THEATER
SCALE: 3" = 1'-0"
D-CEILING-1.DGN




TYP. DETAIL AT METAL PANEL CEILING
SCALE: 3" = 1'-0"
D-CEILING-1.DGN

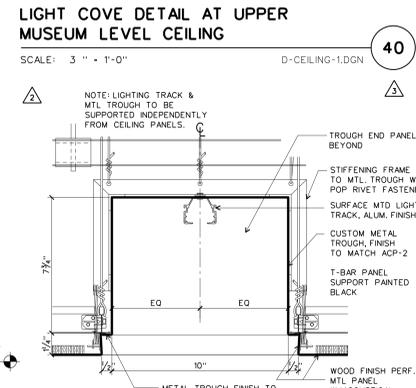


LIGHTING AND RETURN AIR TROUGH DETAIL AT UPPER MUSEUM LEVEL
SCALE: 3" = 1'-0"
D-CEILING-1.DGN

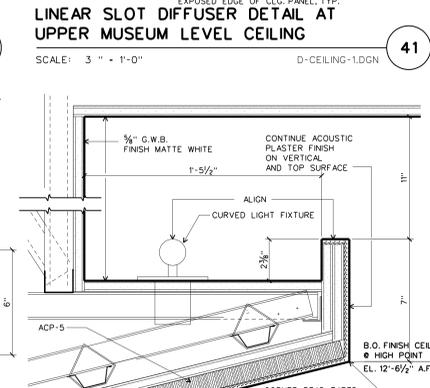


DETAIL AT ORIENTATION THEATER CEILING
SCALE: 3" = 1'-0"
D-CEILING-1.DGN

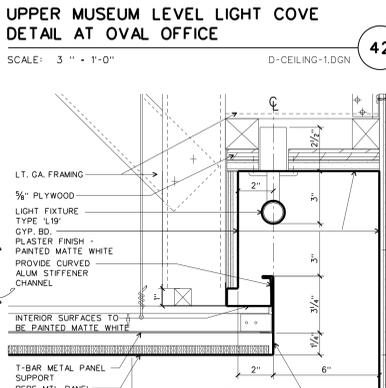


TYP. METAL CEILING DETAIL AT GYP. BD. WALL
SCALE: 3" = 1'-0"
D-CEILING-1.DGN

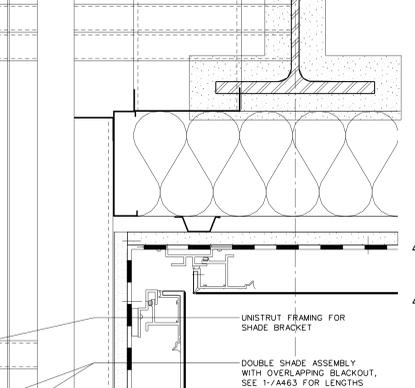


SHADE/ PROJ SCREEN DETAIL AT GREAT HALL CEILING SOUTH
SCALE: 3" = 1'-0"
D-CEILING-1.DGN

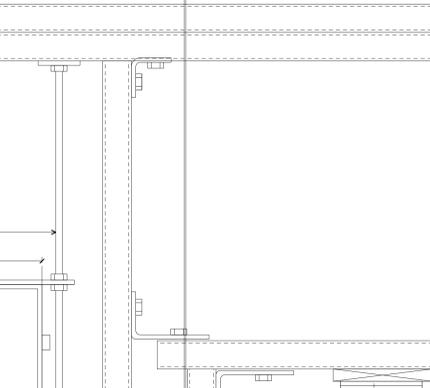


CEILING DETAIL AT ESCALATOR AT GROUND LEVEL
SCALE: 3" = 1'-0"
D-CEILING-1.DGN

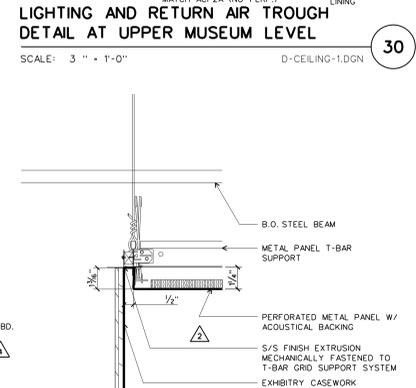


METAL PANEL CEILING DETAIL AT LOWER MUSEUM LEVEL
SCALE: 3" = 1'-0"
D-CEILING-1.DGN

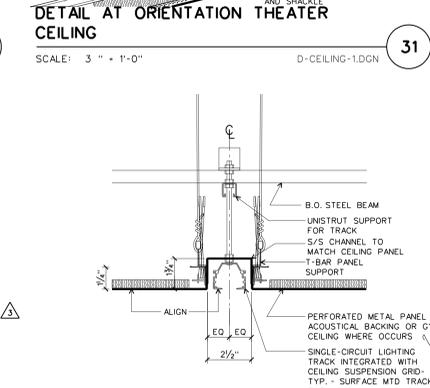


TYP. CEILING DETAIL AT RECESSED TRACK LIGHTS AT LWR MUSEUM LVL
SCALE: 3" = 1'-0"
D-CEILING-1.DGN

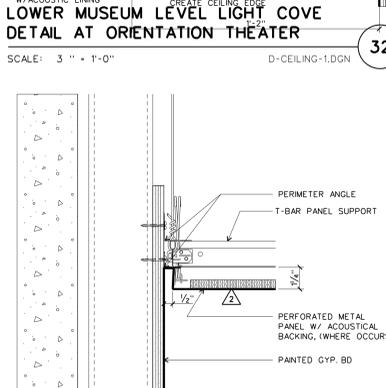


TYP. CEILING THRESHOLD DETAIL AT DRINKING FOUNTAINS
SCALE: 3" = 1'-0"
D-CEILING-1.DGN

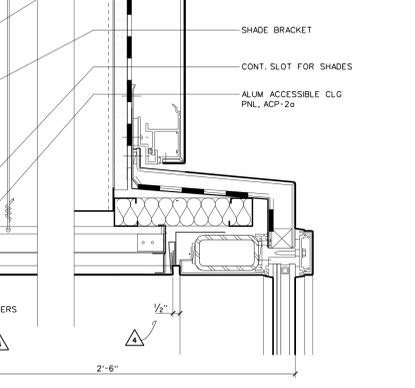


CEILING DETAIL AT STAIR 4 & 5 AT GROUND LEVEL
SCALE: 3" = 1'-0"
D-CEILING-1.DGN

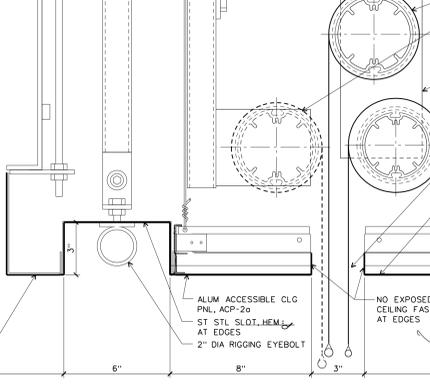


NOT USED
SCALE: 3" = 1'-0"
D-CEILING-1.DGN

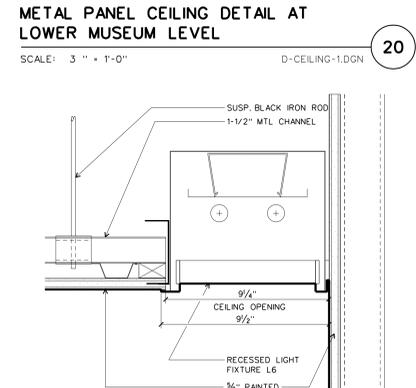


TYP. CEILING DETAIL AT RESTROOM LIGHT FIXTURE
SCALE: 3" = 1'-0"
D-CEILING-1.DGN

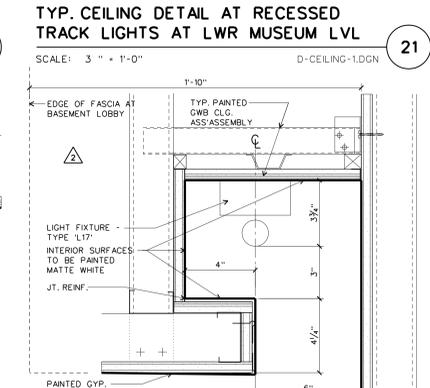


TYP. CEILING LIGHT COVE DETAIL AT DRINKING FOUNTAINS & BASEMENT LOBBY
SCALE: 3" = 1'-0"
D-CEILING-1.DGN

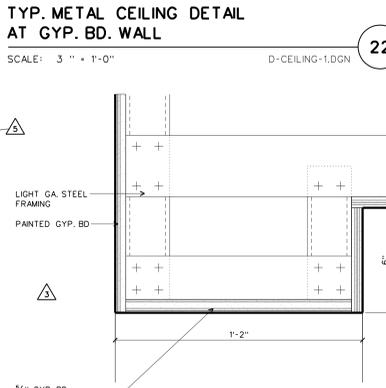


CEILING DETAIL AT STAIR 4 & 5 AT GROUND LEVEL
SCALE: 3" = 1'-0"
D-CEILING-1.DGN

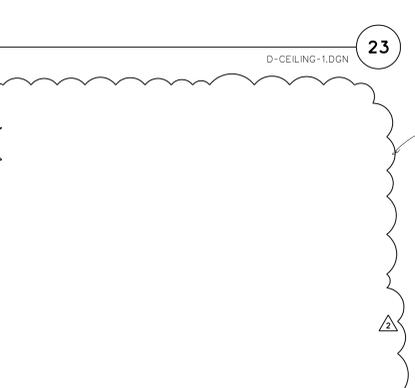

CEILING DETAIL AT ESCALATOR AT GROUND LEVEL
SCALE: 3" = 1'-0"
D-CEILING-1.DGN

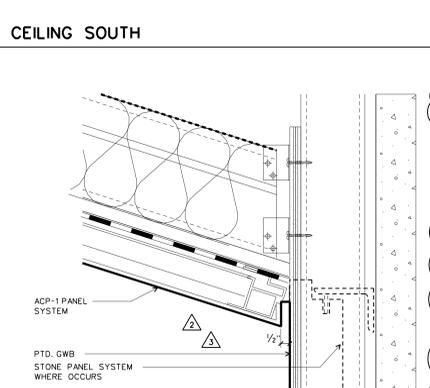

SHADE/ PROJ SCREEN DETAIL AT GREAT HALL CEILING SOUTH
SCALE: 3" = 1'-0"
D-CEILING-1.DGN

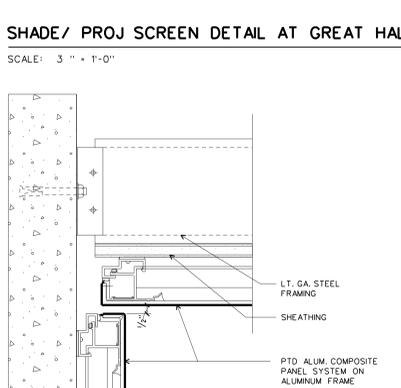

DETAIL AT METAL PANEL & GYP. BD CEILING
SCALE: 3" = 1'-0"
D-CEILING-1.DGN