


Issue	Date
ASI #23	09/12/03
ASI #19	05/07/03
ASI #18	4/18/03
Addendum #2	11/15/02

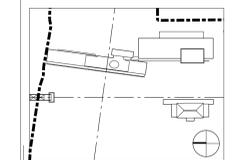

Job No. 9908

Scale

Date September 27, 2002


Title

CEILING DETAILS


Sheet No.

A462


FOR OFFICIAL USE ONLY

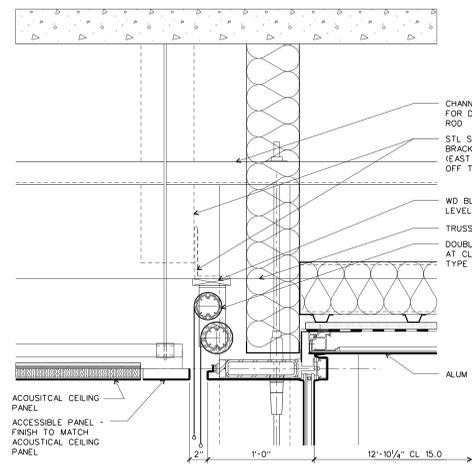


SHADE DETAIL - GREAT HALL SOUTH ELEV.
SCALE: 1-1/2" = 1'-0"
D-1-CEILING-3

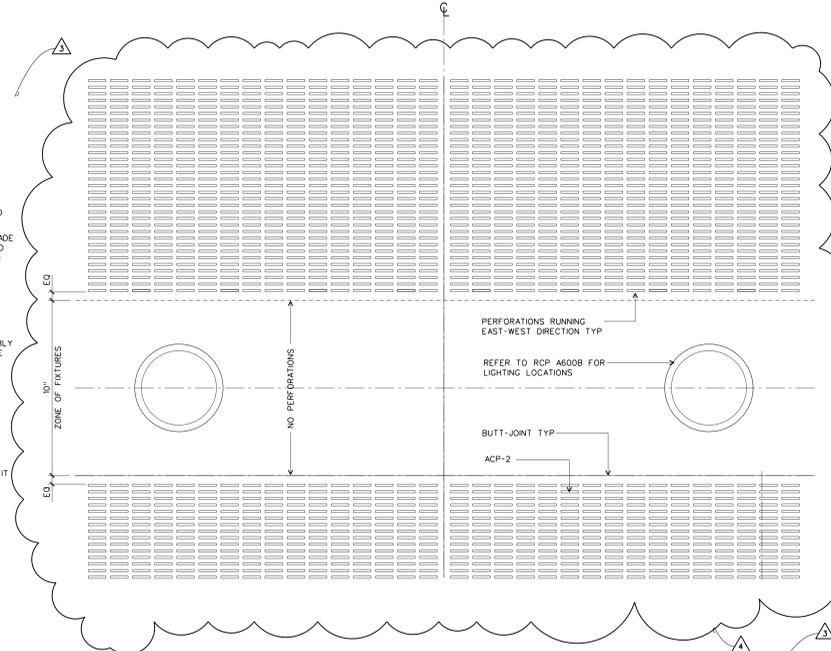


PLAN DETAIL OF PERFORATED CAFE WOOD CEILING
SCALE: 3" = 1'-0"

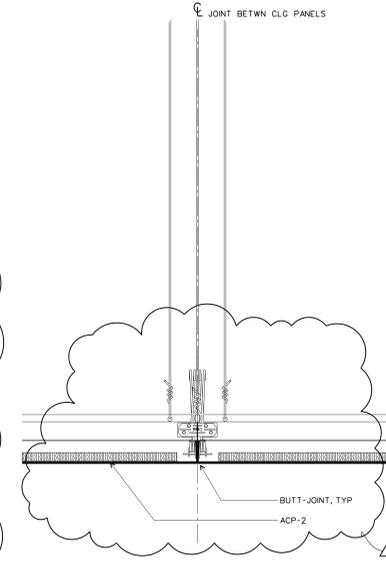


TYP JOINT AT CAFE WD CLG
SCALE: 3" = 1'-0"

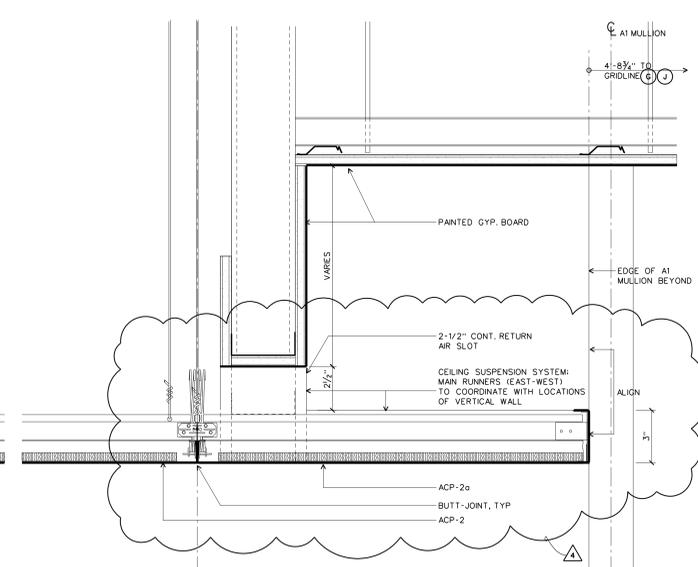


SECT DETAIL: EDGE OF WD CAFE CLG W/RETURN AIR SLOT
SCALE: 3" = 1'-0"

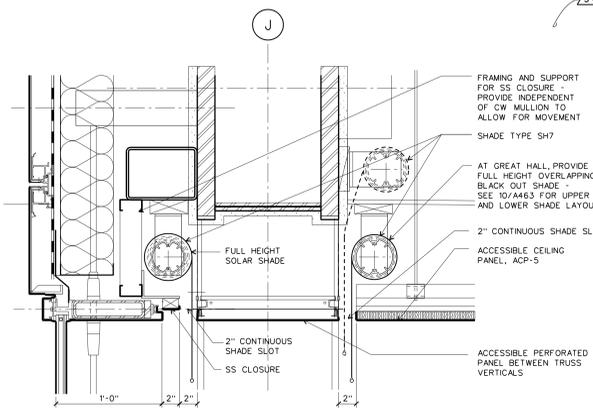


SHADE DETAIL - GREAT HALL WEST ELEV.
SCALE: 1-1/2" = 1'-0"
D-1-CEILING-3

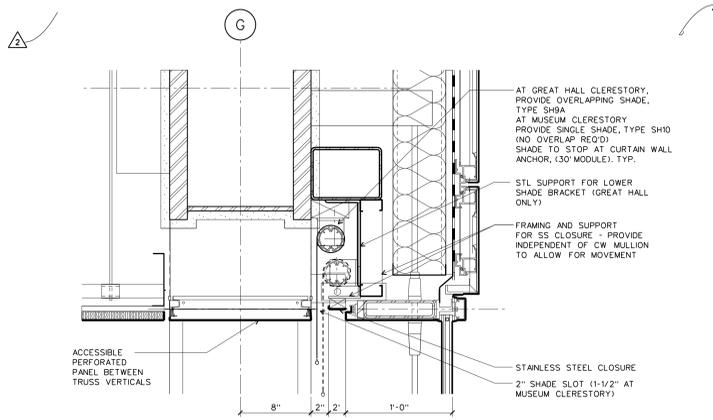


SHADE DETAIL - EAST ELEV. CLERESTORY
SCALE: 1-1/2" = 1'-0"
D-1-CEILING-3

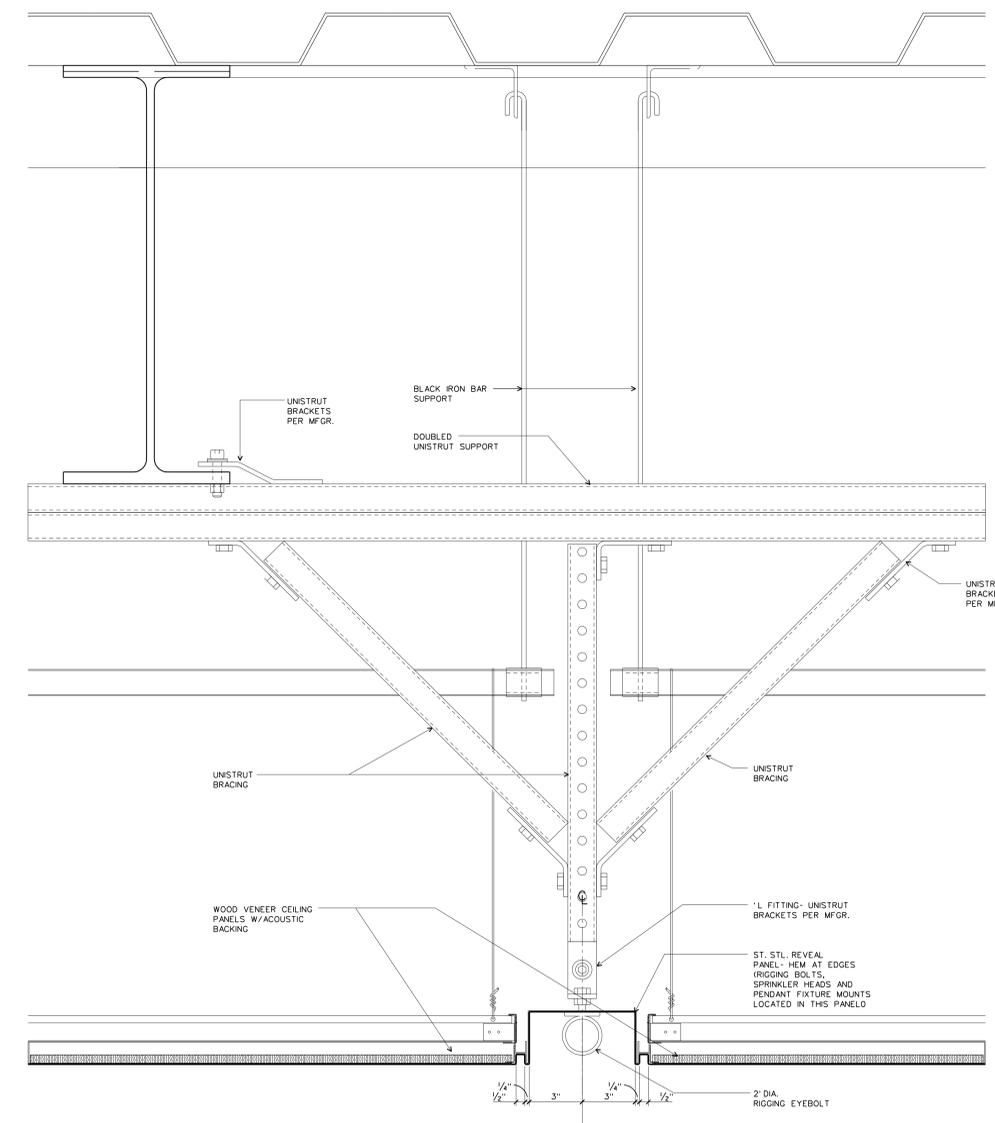

WOOD PANEL CEILING AT REVEAL PANEL
SCALE: 3" = 1'-0"
D-1-CEILING-3

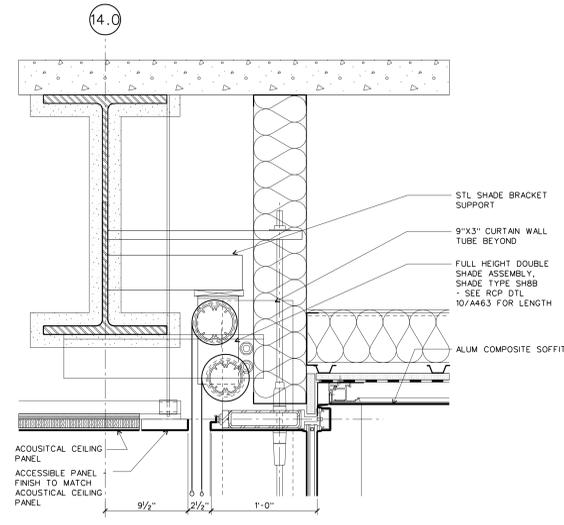

SHADE DETAIL - GREAT HALL SOUTH ELEV
SCALE: 1-1/2" = 1'-0"
D-1-CEILING-3

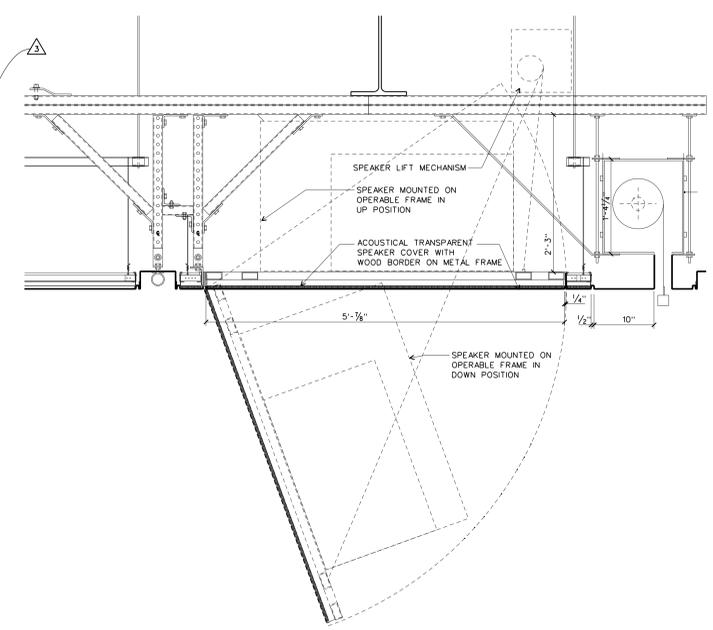

SPEAKER DETAIL - GREAT HALL
SCALE: 1" = 1'-0"
D-1-CEILING-3

FOR OFFICIAL USE ONLY