



FLATTENED EXTERIOR ELEVATION OF DESK

SCALE: 3/4" = 1'-0"

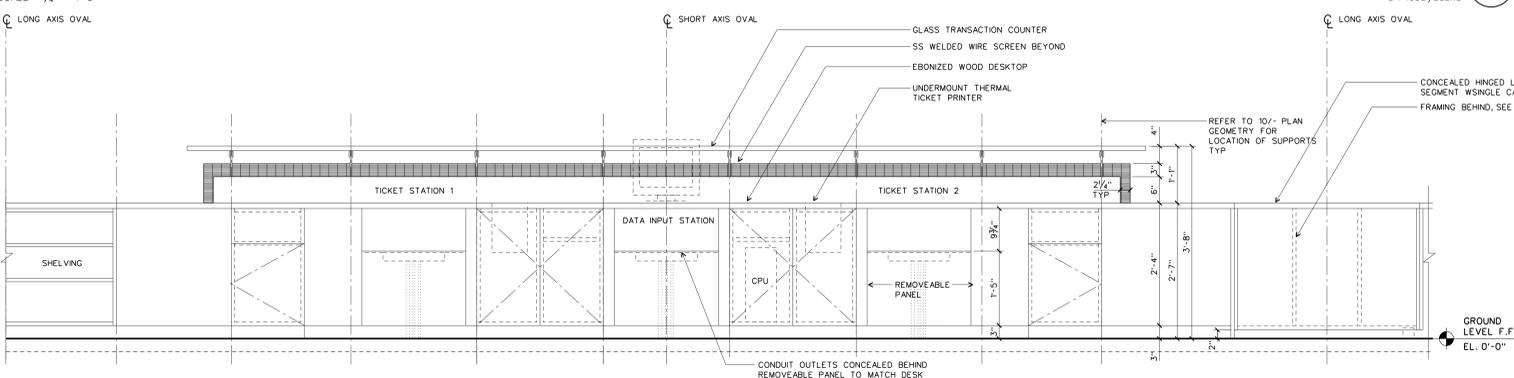


FLATTENED INTERIOR ELEVATION OF DESK

SCALE: 3/4" = 1'-0"

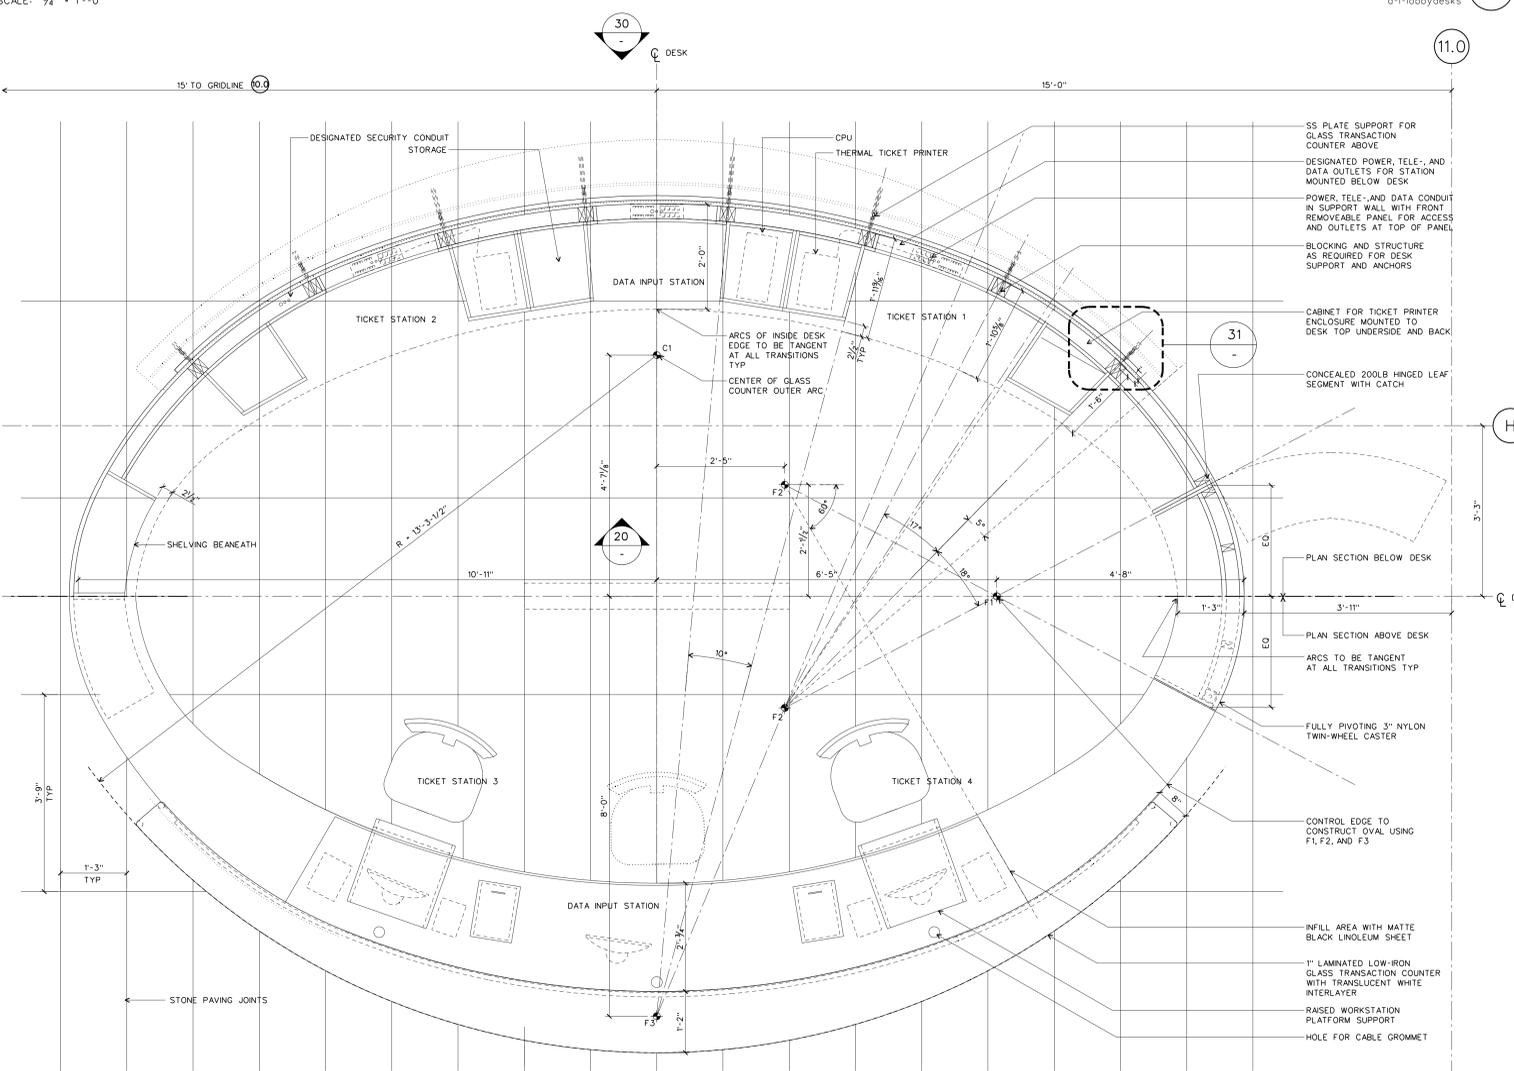


LOBBY TICKET DESK PLAN

SCALE: 3/4" = 1'-0"

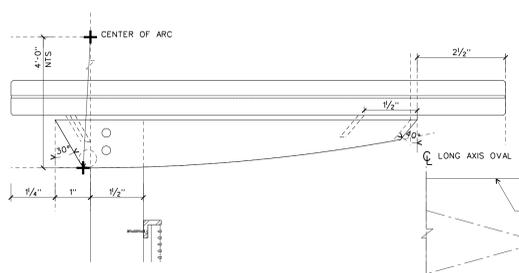


PLAN SECTION DETAIL PANEL JOINT

SCALE: 6" = 1'-0"

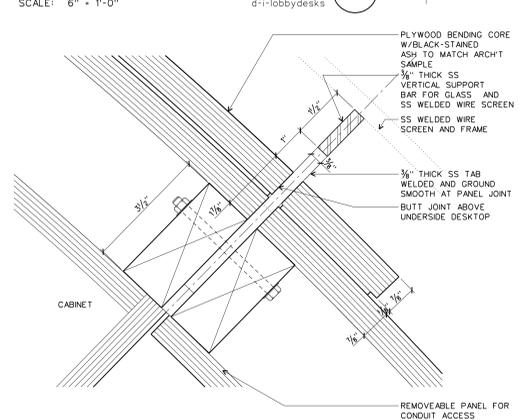


PLAN SECTION DETAIL PANEL JOINT

SCALE: 6" = 1'-0"

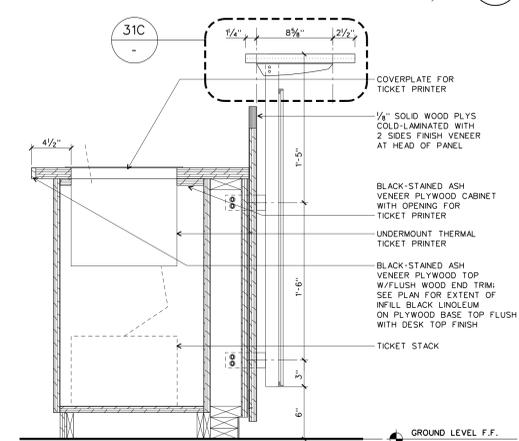


LOBBY TICKET DESK SECTION

SCALE: 1-1/2" = 1'-0"

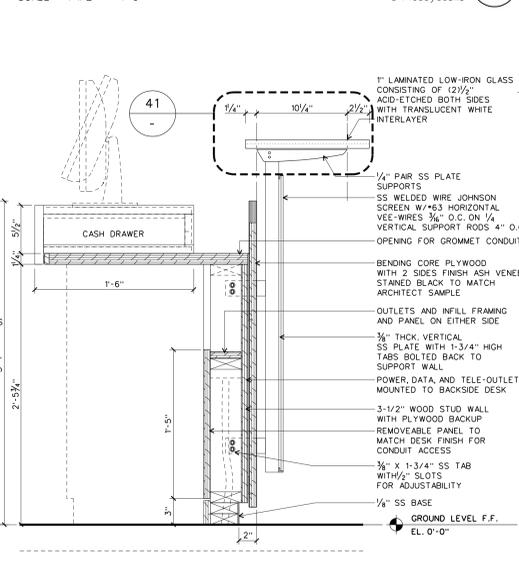


LOBBY TICKET DESK SECTION

SCALE: 1-1/2" = 1'-0"

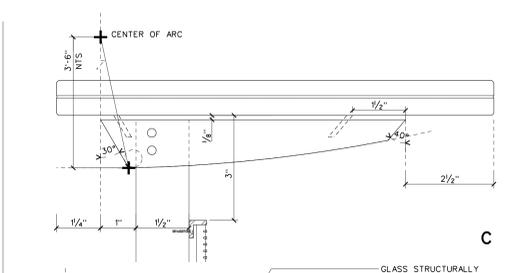


SS GLASS SUPPORT DETAIL

SCALE: 6" = 1'-0"

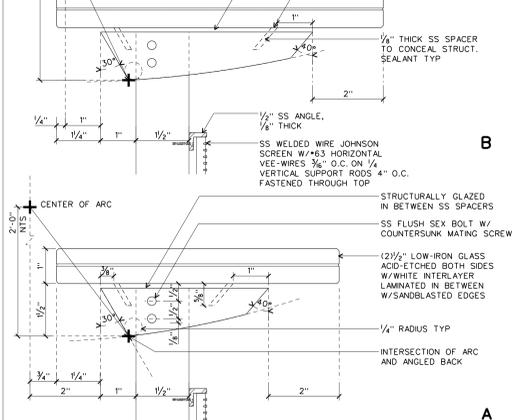


SS GLASS SUPPORT DETAIL

SCALE: 6" = 1'-0"

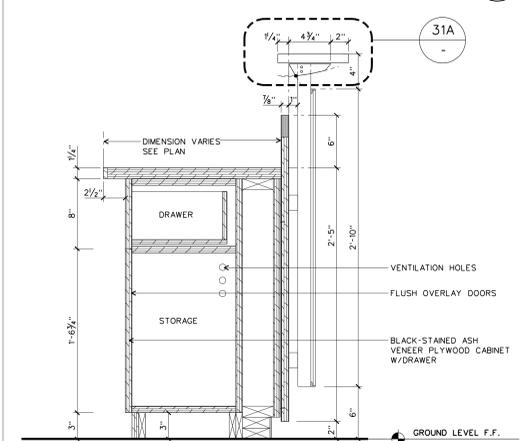

LOBBY TICKET DESK SECTION

SCALE: 1-1/2" = 1'-0"

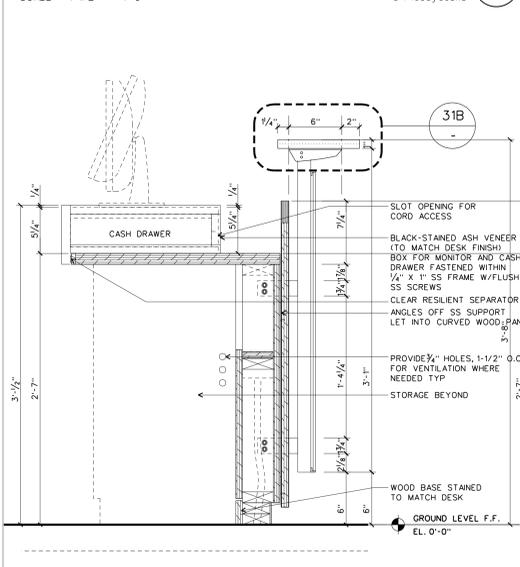

LOBBY TICKET DESK SECTION

SCALE: 1-1/2" = 1'-0"