


AS1 #24	Date
Addendum #2	11/15/02
100% Construction Documents	09/27/02
90% Progress Printing	08/30/02
100% Struct./CD Progress	07/01/02
Bridge Bldg. Substructure	06/14/02
100% Steel & Concrete CD	05/15/02
& Architectural CD Progress	
100% Design Development	03/01/02
Issue	Date

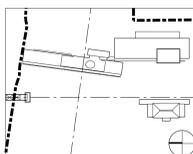

Job No. 9908

Scale 1/2"=1'-0"


Date September 27, 2002

Title **MUSEUM BUILDING
ORNAMENTAL STAIR-
PLANS AND SECTIONS**
1/3/7


Sheet No.

A500


FOR OFFICIAL USE ONLY

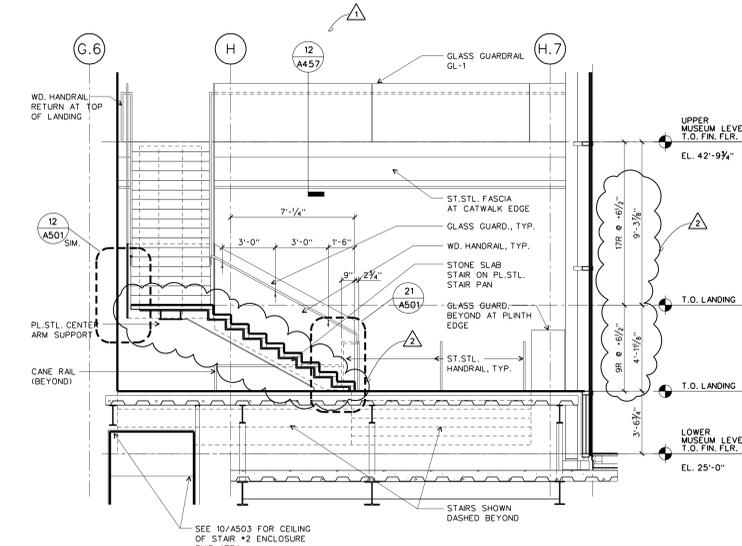


STAIR 1: E/W SECTION LOOKING SOUTH
SCALE: 1/4" = 1'-0"

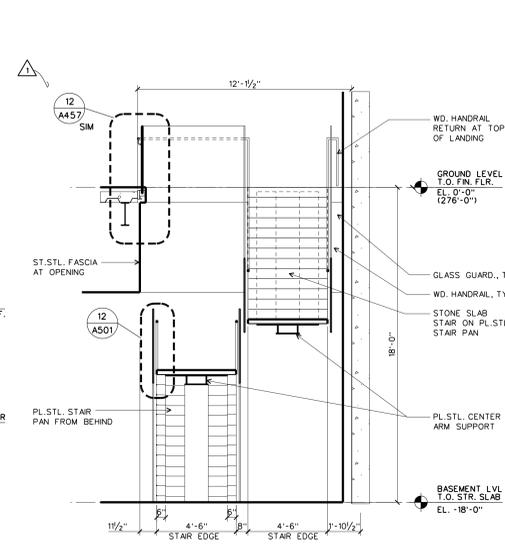


STAIR 3: E/W SECTION LOOKING NORTH
SCALE: 1/4" = 1'-0"

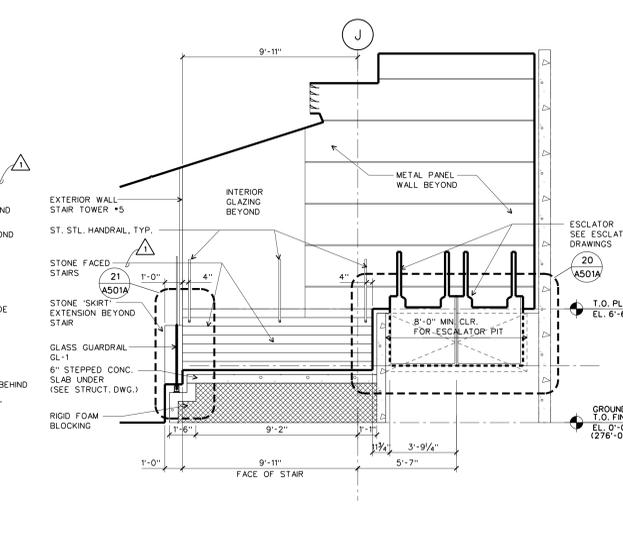


STAIR 7: E/W SECTION LOOKING SOUTH
SCALE: 1/4" = 1'-0"

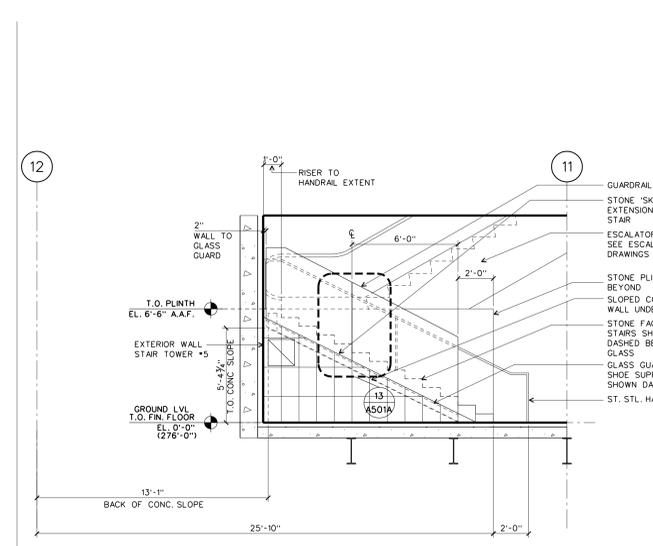


STAIR 7: ELEVATION LOOKING WEST
SCALE: 1/4" = 1'-0"

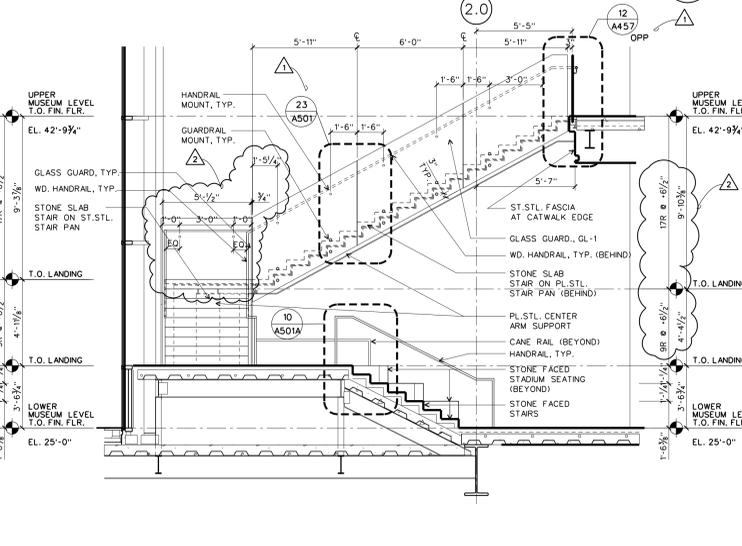


STAIR 1: N/S SECTION LOOKING EAST
SCALE: 1/4" = 1'-0"

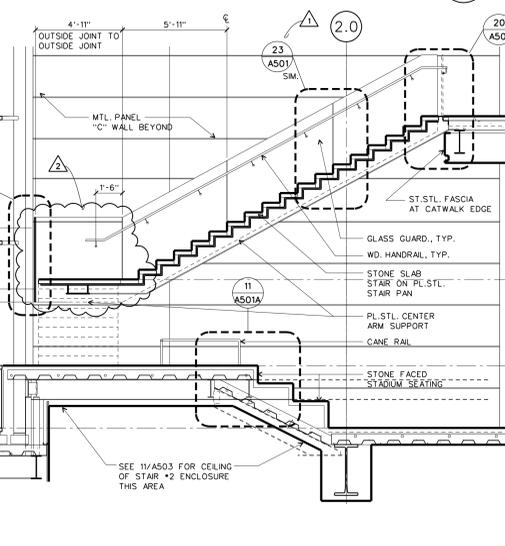


STAIR 3: N/S SECTION LOOKING EAST
SCALE: 1/4" = 1'-0"

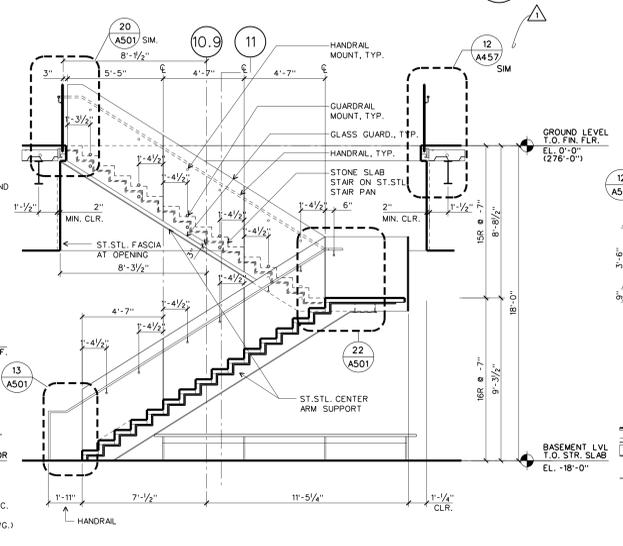


STAIR 7: N/S SECTION LOOKING EAST
SCALE: 1/4" = 1'-0"

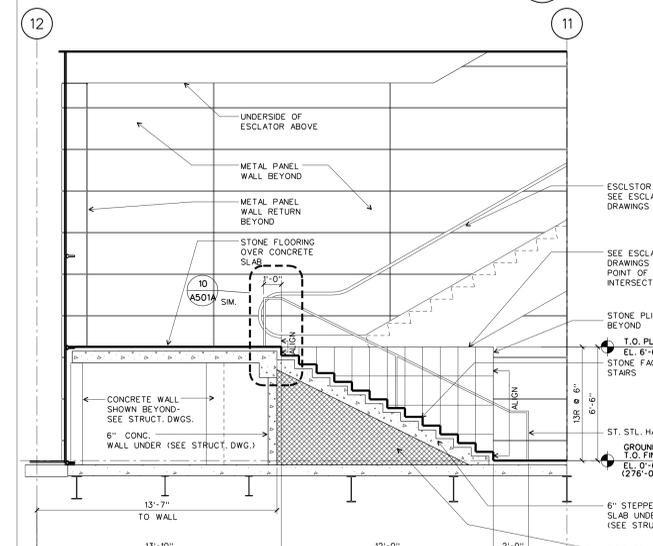


STAIR 7: N/S SECTION LOOKING WEST
SCALE: 1/4" = 1'-0"

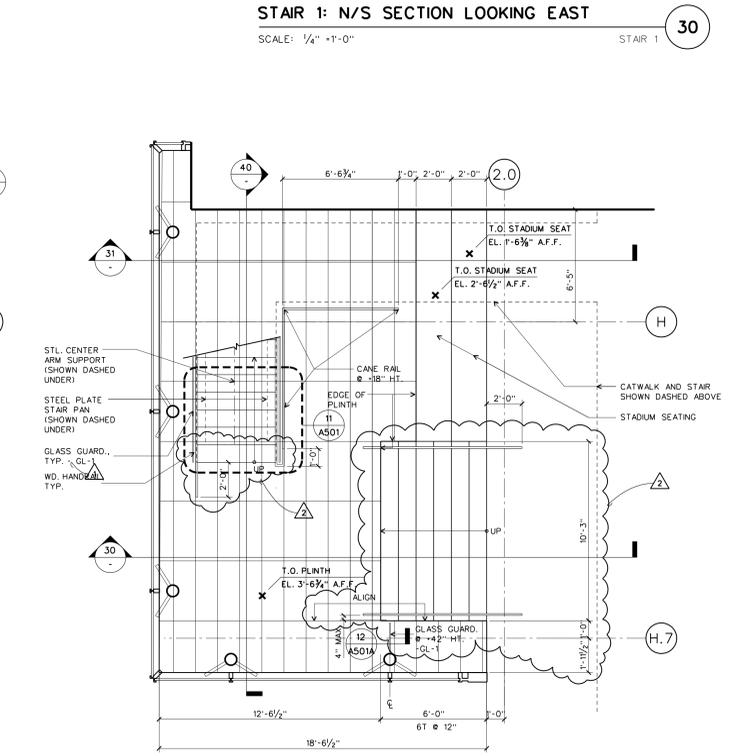


STAIR 1: MUSEUM LOWER LEVEL PLAN
SCALE: 1/4" = 1'-0"

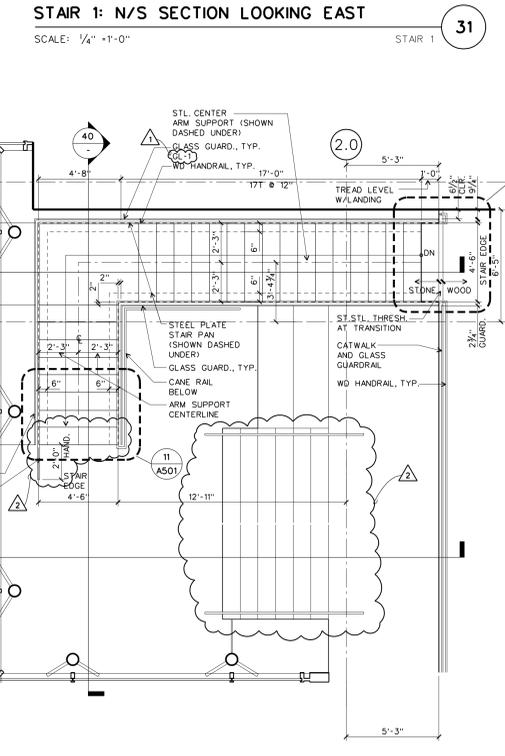

STAIR 1: MUSEUM UPPER LEVEL PLAN
SCALE: 1/4" = 1'-0"

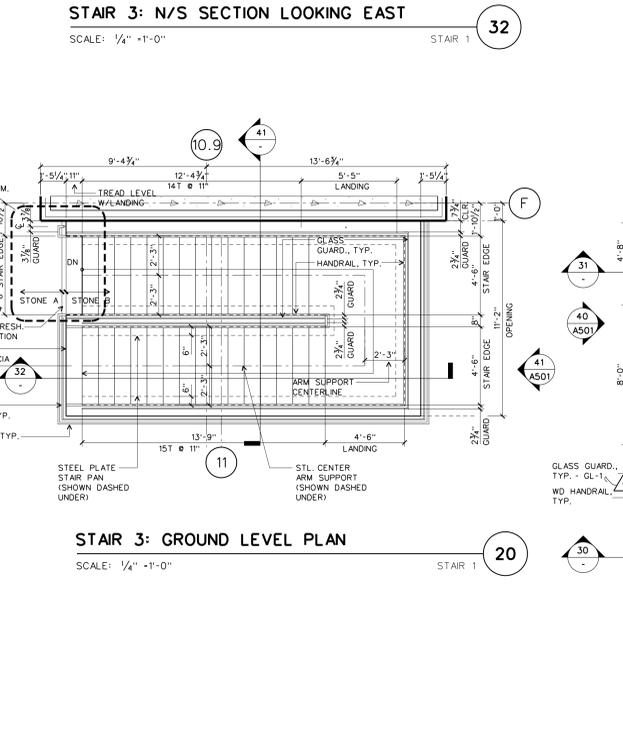

STAIR 3: GROUND LEVEL PLAN
SCALE: 1/4" = 1'-0"

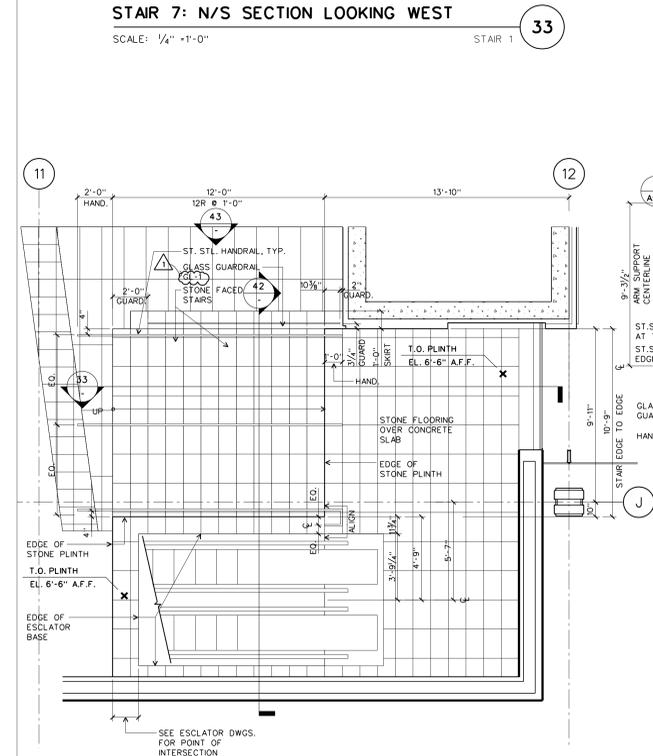

STAIR 7: GROUND LEVEL PLAN
SCALE: 1/4" = 1'-0"