


Addendum #2	11/15/02
100% Construction Documents	09/27/02
100% Struct./CD Progress	07/01/02
Issue	Date
*New Sheet. Former A501 details on A502.	

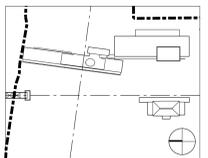


Job No. 9908
Scale 1 1/2" = 1'-0"
Date September 27, 2002
Title

**MUSEUM BUILDING
ORNAMENTAL STAIR:
DETAILS**

Sheet No.









A501

FOR OFFICIAL USE ONLY

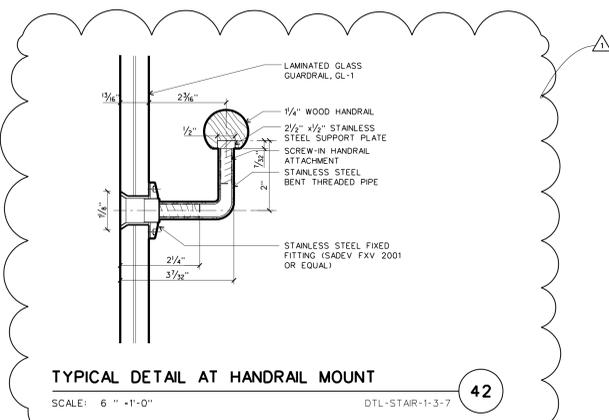

STAIR 3: PARTIAL ELEVATION- MID LANDING
SCALE: 1/4" = 1'-0" DTL-STAIR-1-3-7 41

STAIR 1: PARTIAL ELEVATION- MID LANDING
SCALE: 1/4" = 1'-0" DTL-STAIR-1-3-7 40

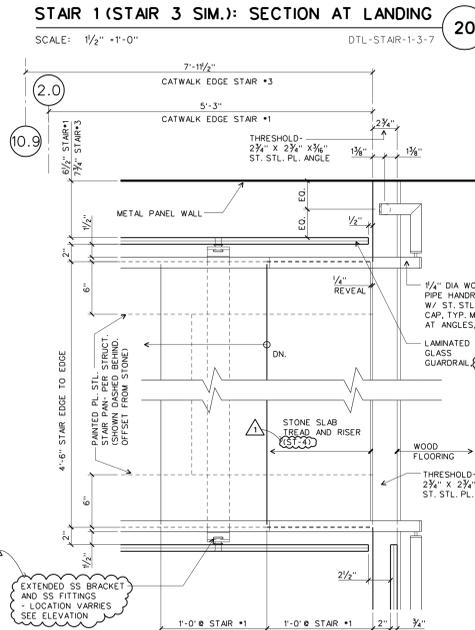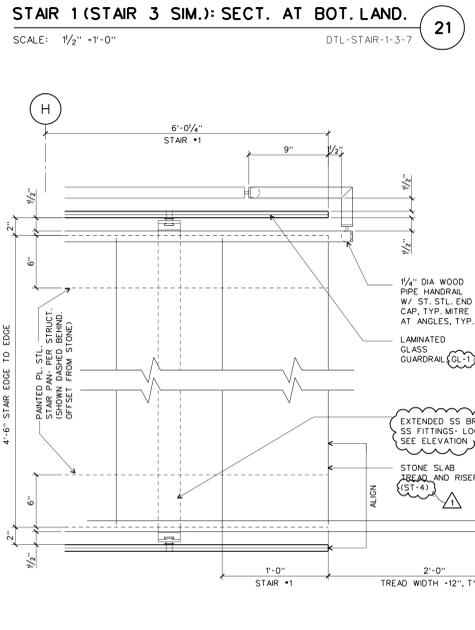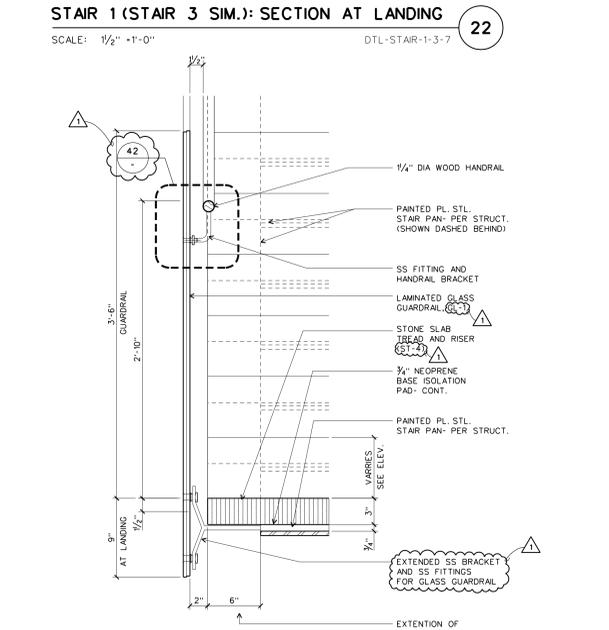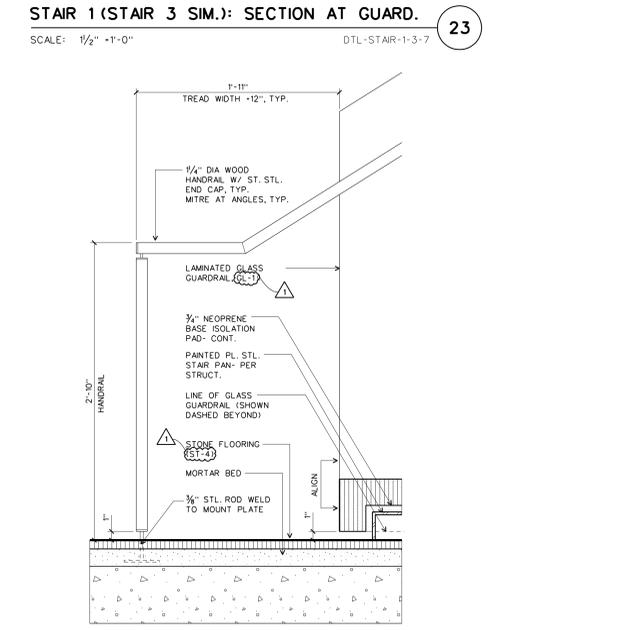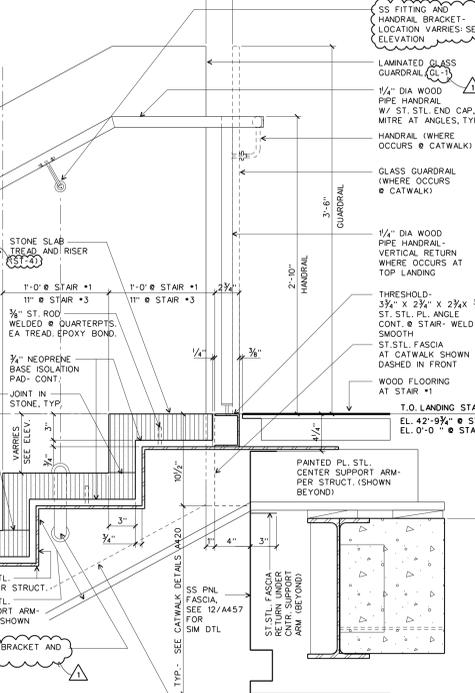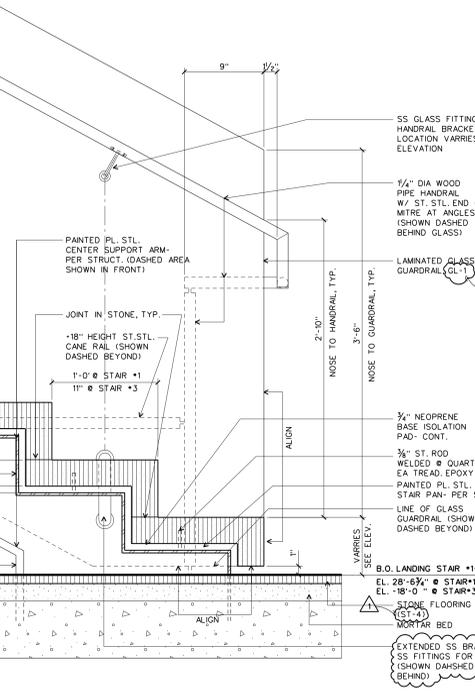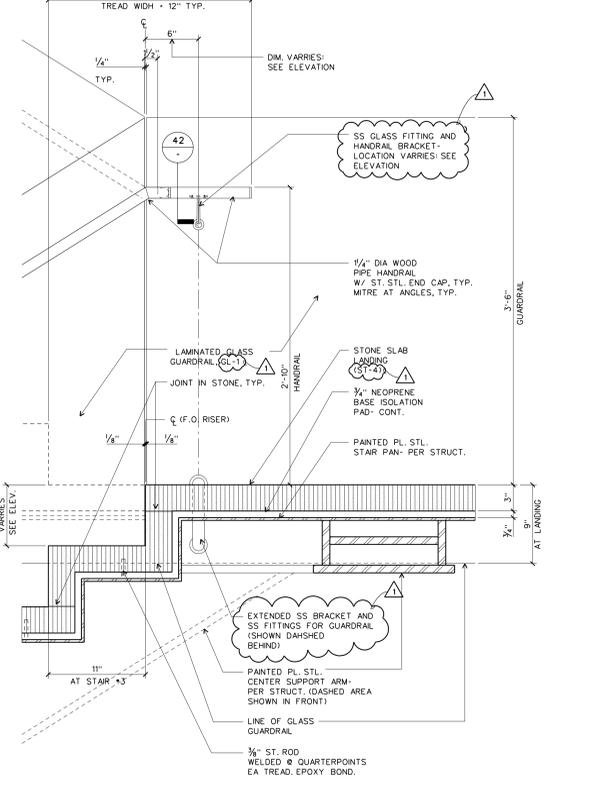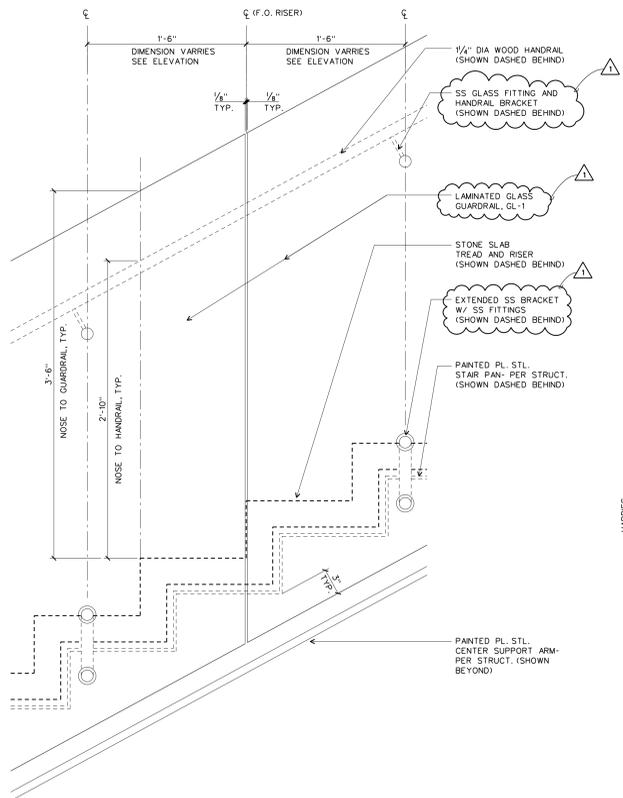

STAIR 3 (STAIR 1 SIM.): HANDRAIL AT BASE
SCALE: 1/2" = 1'-0" DTL-STAIR-1-3-7 13

STAIR 1 (STAIR 3 SIM.): SECTION AT LANDING
SCALE: 1/2" = 1'-0" DTL-STAIR-1-3-7 12

STAIR 1 (STAIR 3 SIM.): PLAN AT BOT. LAND.
SCALE: 1/2" = 1'-0" DTL-STAIR-1-3-7 11

STAIR 1 (STAIR 3 SIM.): PLAN AT LANDING
SCALE: 1/2" = 1'-0" DTL-STAIR-1-3-7 10