

**WILLIAM J. CLINTON
PRESIDENTIAL
CENTER**

LITTLE ROCK, ARKANSAS

Architect
POLSHKE PARTNERSHIP LLP
320 West 13th Street
New York, New York 10014
212.807.7171

Coordinating Architects
POLK STANLEY YEARY ARCHITECTS LTD
700 South Schiller Street
Little Rock, Arkansas 72201
501.378.0878

WITSELL EVANS RASCO
901 West Third Street
Little Rock, Arkansas 72201
501.374.5300

WOODS CARADINE ARCHITECTS
2200 South Main Street
Little Rock, Arkansas 72206
501.374.4060

Landscape Architects
HARGREAVES ASSOCIATES
118 Magazine Street
Cambridge, Massachusetts 02139
617.661.0070

LANDSCAPE ARCHITECTURE, Inc.
2300 Cottontale Lane Suite 202
Little Rock, Arkansas 72202
501.374.5610

Structural Engineer
LESLIE E. ROBERTSON ASSOC., RLLP
30 Broad Street, 47th Floor
New York, New York 10004
212.750.9000


MEP Engineers
FLACK + KURTZ, Inc.
475 Fifth Avenue
New York, New York 10017
212.532.9600

CROMWELL ARCHITECTS ENGINEERS
101 South Spring Street
Little Rock, Arkansas 72201
501.372.2900

Curtainwall Consultant
R. A. HEINTGES ARCHITECTS
126 Fifth Avenue, 9th Floor
New York, New York 10011
212.652-2968

Seal

100% Construction Documents	09/27/02
90% Progress Printing	08/30/02
100% Struct./ CD Progress	07/01/02
Bridge Bldg. Substructure	06/14/02
100% Steel & Concrete CD	05/15/02
& Architectural CD Progress	
100% Design Development	03/01/02
Issue	Date
*Issued orig. A501/Former A502 dls on A505	

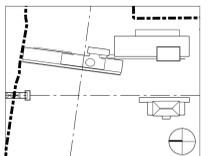


Job No. 9908
Scale 1/4" = 1'-0"
Date September 27, 2002
Title

**MUSEUM BUILDING
STAIR 2:
PLANS AND SECTIONS**

Sheet No.


A502

FOR OFFICIAL USE ONLY

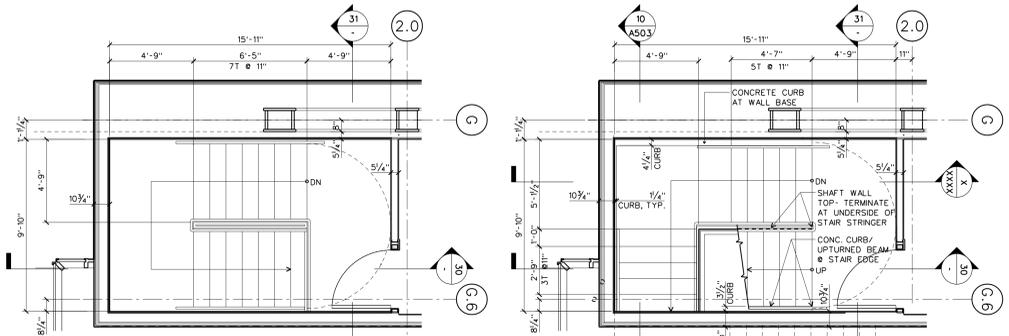


STAIR 2: MUSEUM UPPER LEVEL PLAN
SCALE: 1/4" = 1'-0" STAIR 2 **41**

STAIR 2: MUSEUM LOWER LEVEL PLAN
SCALE: 1/4" = 1'-0" STAIR 2 **40**

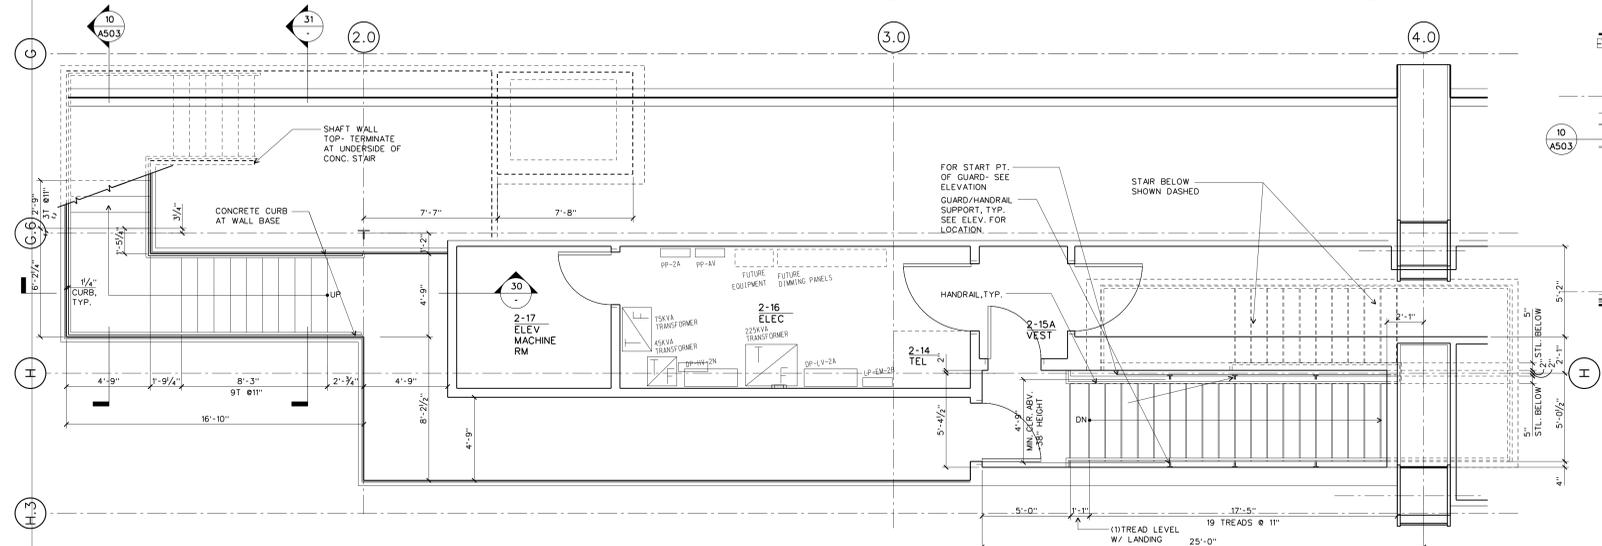


STAIR 2: SECOND LEVEL PLAN
SCALE: 1/4" = 1'-0" STAIR 2 **32**

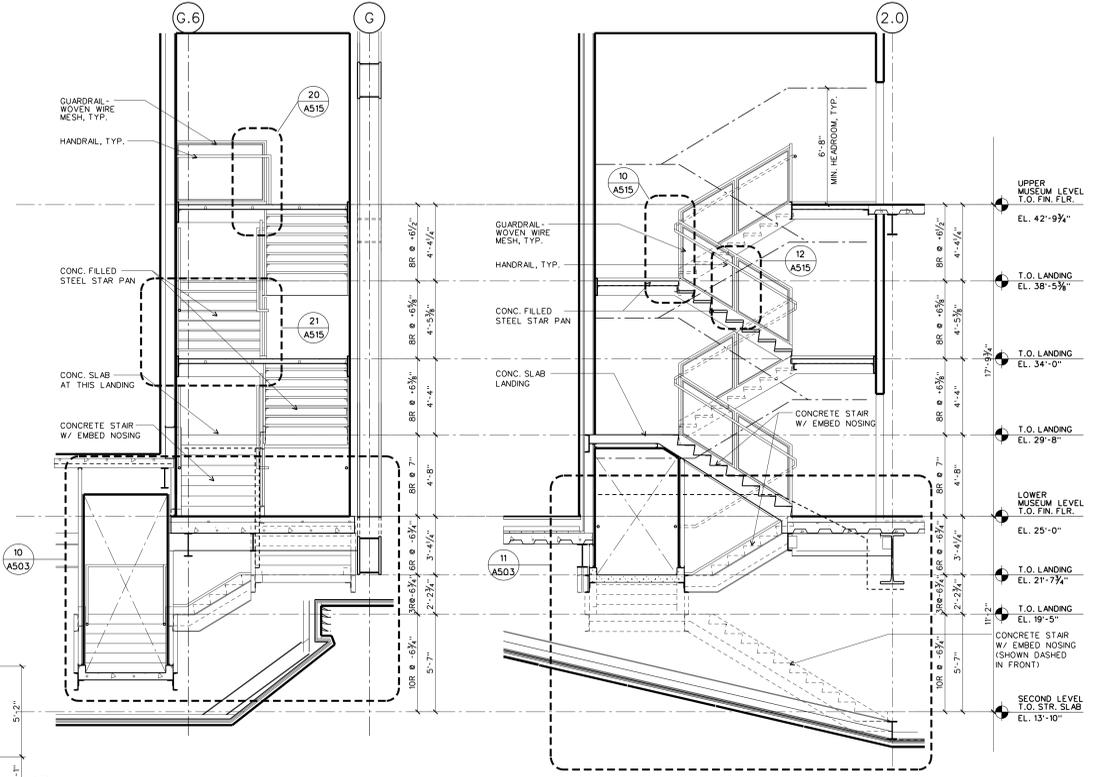


STAIR 2: E/W SECTION LOOKING NORTH
SCALE: 1/4" = 1'-0" STAIR 2 **31**

STAIR 2: N/S SECTION LOOKING EAST
SCALE: 1/4" = 1'-0" STAIR 2 **30**

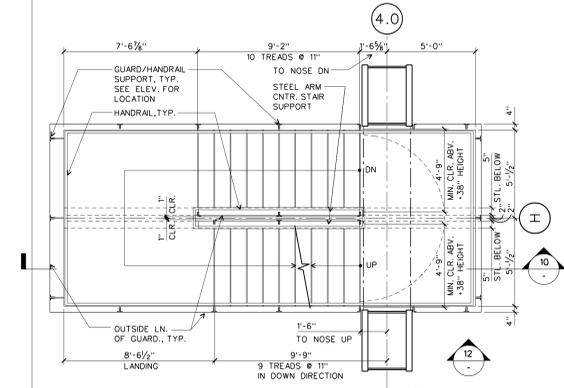


STAIR 2: PLAN LANDING 1
SCALE: 1/4" = 1'-0" STAIR 2 **21**

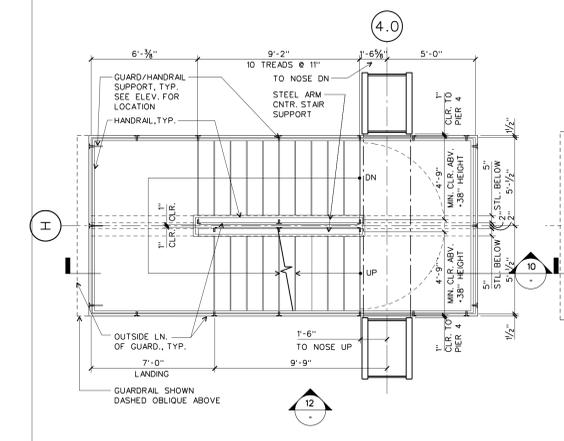


STAIR 2: PLAN LANDING 2
SCALE: 1/4" = 1'-0" STAIR 2 **14**


STAIR 2: PLAN LANDING 3
SCALE: 1/4" = 1'-0" STAIR 2 **13**

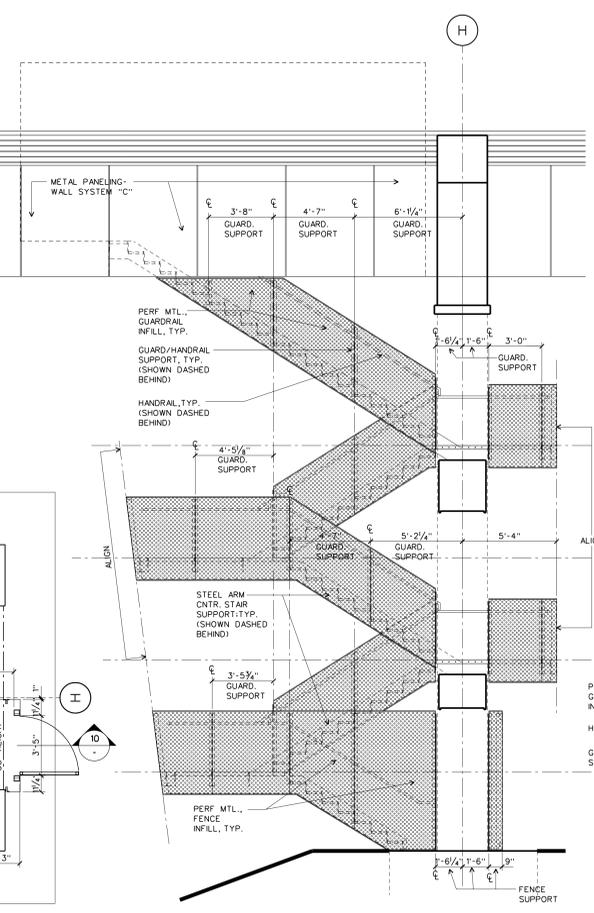

STAIR 2: ELEVATION
SCALE: 1/4" = 1'-0" STAIR 2 **12**

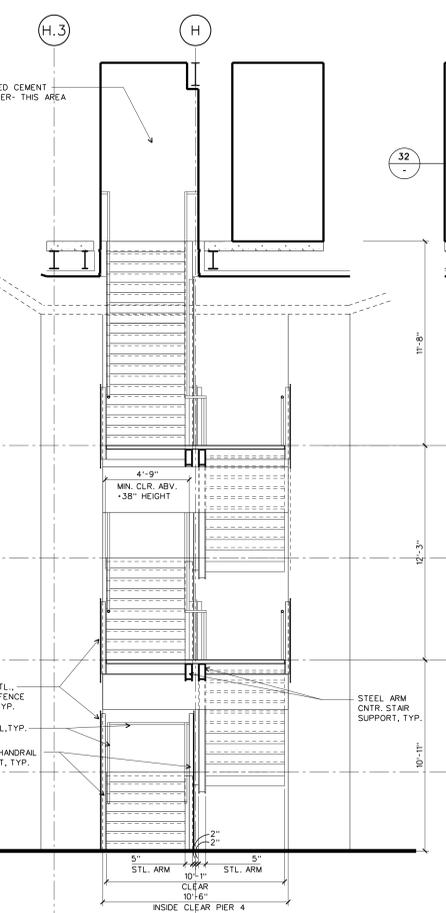

STAIR 2: E/W SECTION LOOKING NORTH
SCALE: 1/4" = 1'-0" STAIR 2 **11**

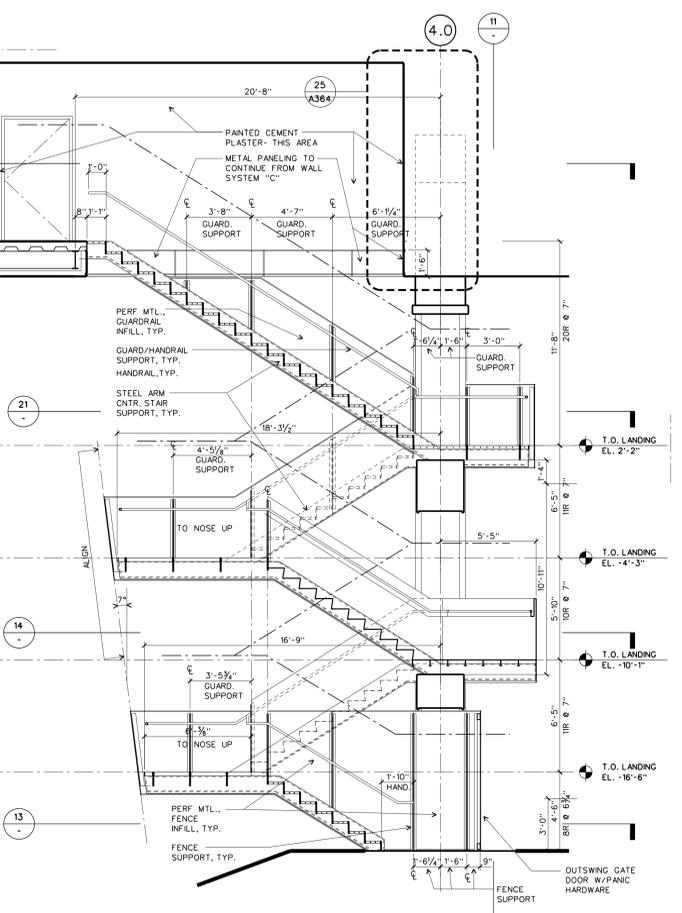

STAIR 2: N/S SECTION LOOKING EAST
SCALE: 1/4" = 1'-0" STAIR 2 **10**