




SECTION DETAIL AT WALL
1 1/2" = 1'-0"
33

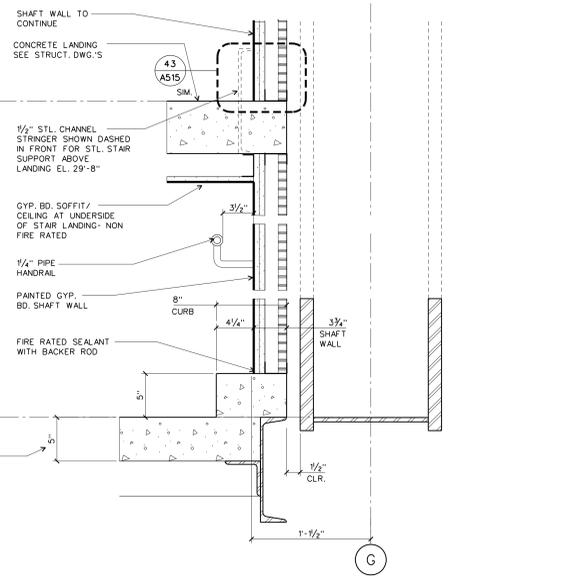


SECTION DETAIL AT CURB
1 1/2" = 1'-0"
32

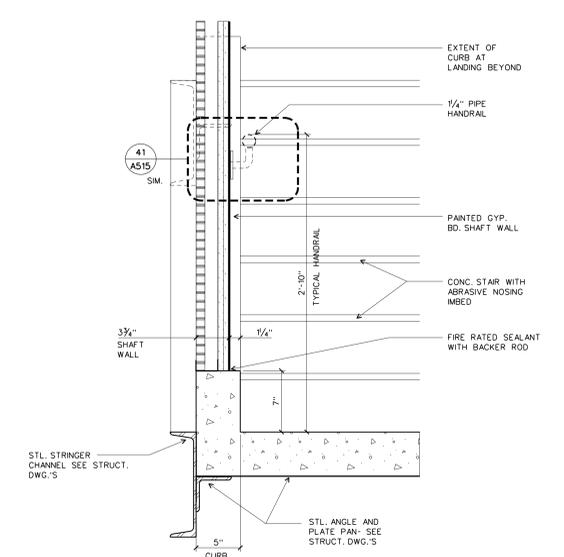


SECTION DETAIL AT WALL, TYPICAL
1 1/2" = 1'-0"
23

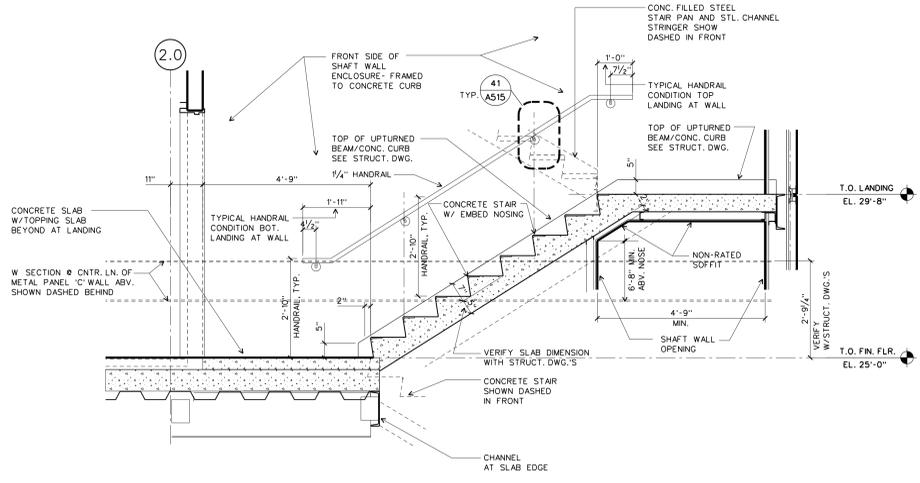


STAIR 2: N/S SECTION LOOKING WEST
SCALE: 1/2" = 1'-0"
21

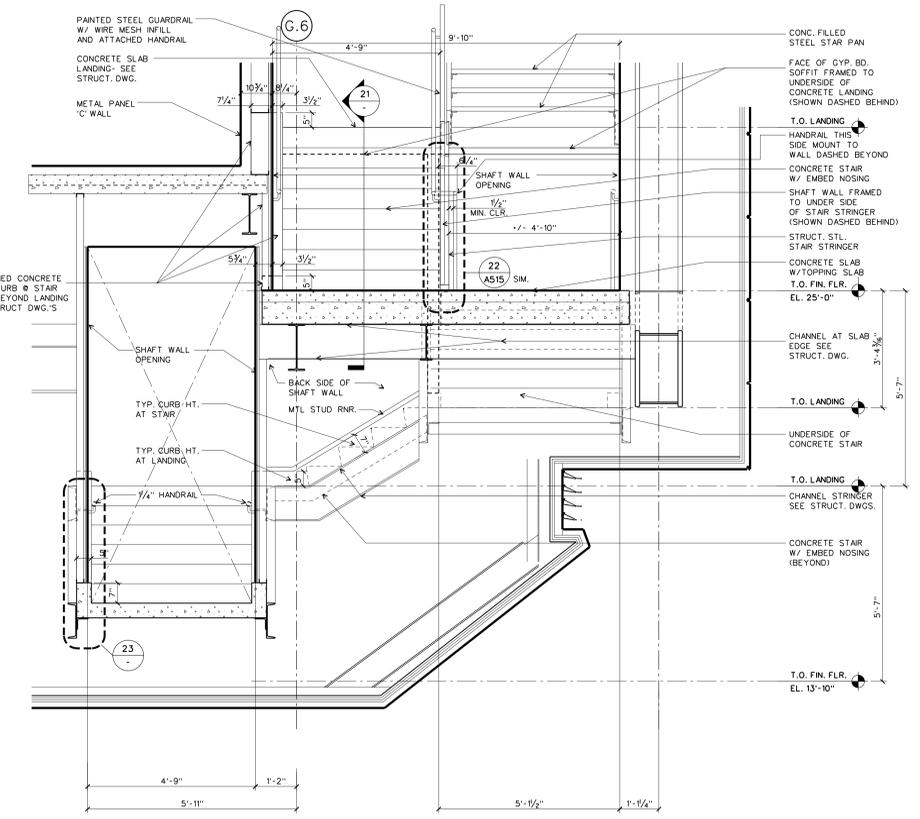


STAIR 2: E/W SECTION LOOKING NORTH
SCALE: 1/2" = 1'-0"
20

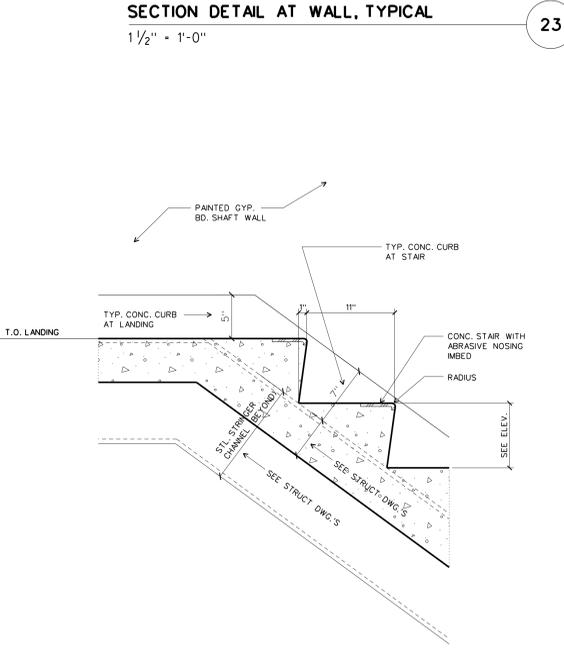

SECTION DETAIL THRU STAIR
1 1/2" = 1'-0"
13

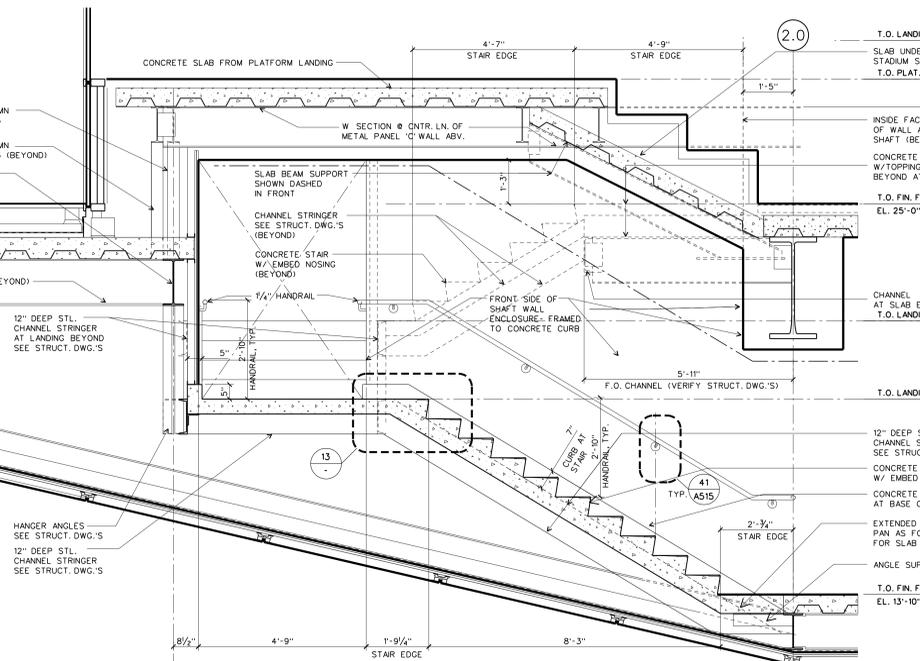

STAIR 2: N/S SECTION LOOKING EAST
SCALE: 1/2" = 1'-0"
11

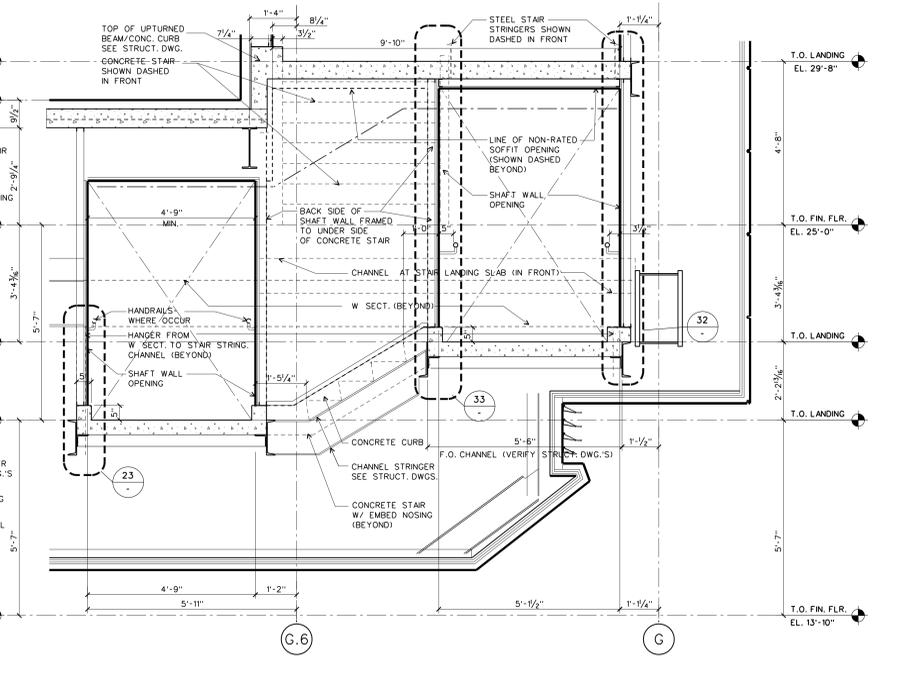

STAIR 2: E/W SECTION LOOKING NORTH
SCALE: 1/2" = 1'-0"
10