

**WILLIAM J. CLINTON  
PRESIDENTIAL  
CENTER**

LITTLE ROCK, ARKANSAS

**Architect**  
POLLSHEK PARTNERSHIP LLP  
320 West 13th Street  
New York, New York 10014  
212.807.7171

**Coordinating Architects**  
POLK STANLEY YEARY ARCHITECTS LTD  
700 South Schiller Street  
Little Rock, Arkansas 72201  
501.378.0878

WITSELL EVANS RASCO  
901 West Third Street  
Little Rock, Arkansas 72201  
501.374.5300

WOODS CARADINE ARCHITECTS  
2200 South Main Street  
Little Rock, Arkansas 72206  
501.374.4060

**Landscape Architects**  
HARGREAVES ASSOCIATES  
118 Magazine Street  
Cambridge, Massachusetts 02139  
617.661.0070

LANDSCAPE ARCHITECTURE, Inc.  
2300 Cottondale Lane Suite 202  
Little Rock, Arkansas 72202  
501.374.5810

**Structural Engineer**  
LESLIE E. ROBERTSON ASSOC., RLLP  
30 Broad Street, 47th Floor  
New York, New York 10004  
212.750.9000


**MEP Engineers**  
FLACK + KURTZ, Inc.  
475 Fifth Avenue  
New York, New York 10017  
212.532.9600

CROMWELL ARCHITECTS ENGINEERS  
101 South Spring Street  
Little Rock, Arkansas 72201  
501.372.2900

**Curtainwall Consultant**  
R. A. HEINTGES ARCHITECTS  
126 Fifth Avenue, 9th Floor  
New York, New York 10011  
212.652.2968

Seal

Issue	Date
100% Construction Documents	09/27/02
90% Progress Printing	08/30/02
100% Struct./ CD Progress	07/01/02
Bridge Bldg. Substructure	06/14/02
100% Steel & Concrete CD	05/15/02
& Architectural CD Progress	
100% Design Development	03/01/02
Issue	Date
*Issued orig. A503/Former A506	01/12/03

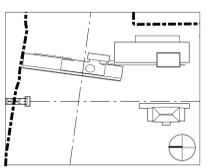


Job No. 9908  
Scale AS NOTED  
Date September 27, 2002  
Title


**MUSEUM BUILDING  
STAIR 5: PLANS  
AND SECTIONS**

Sheet No. **A506**


FOR OFFICIAL USE ONLY

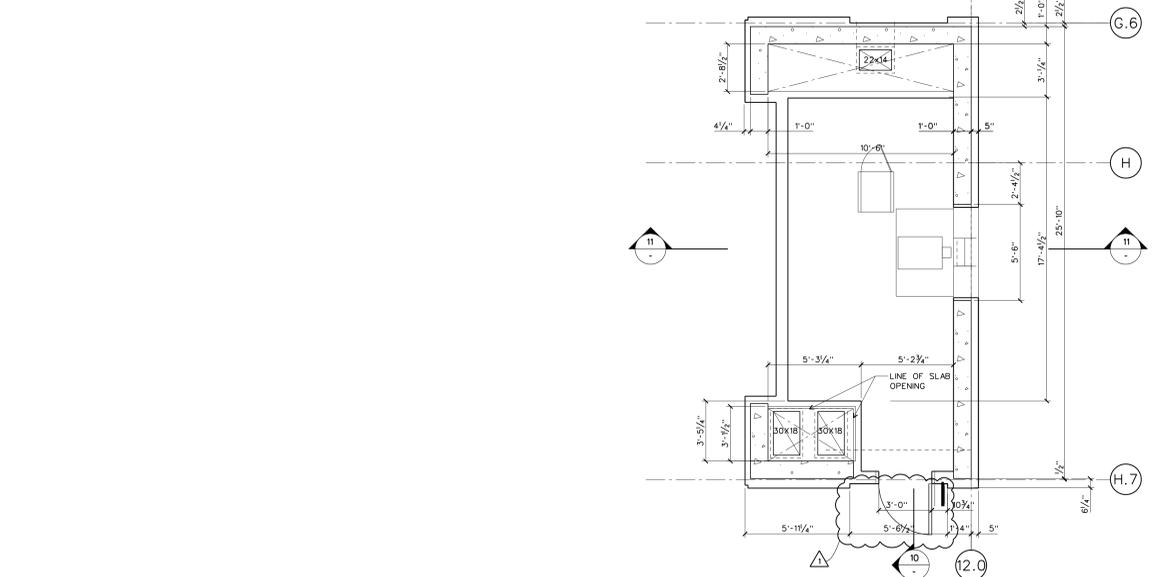


**STAIR 5: MUSEUM UPPER LEVEL PLAN**  
SCALE: 1/4" = 1'-0"  
PLANS/STAIR 5 30

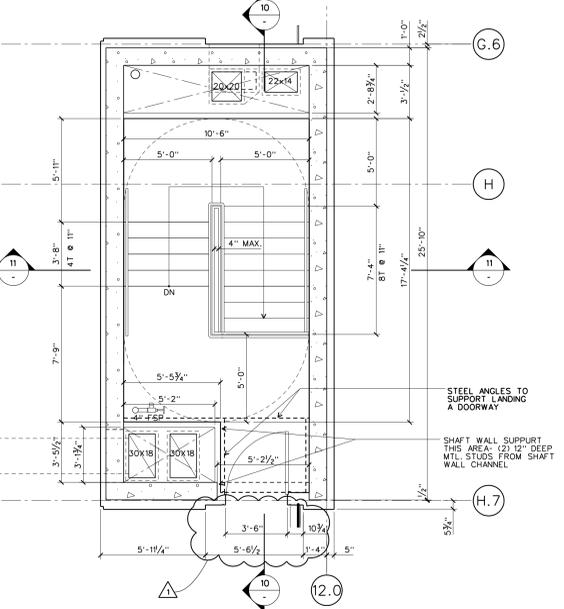


**STAIR 5: MUSEUM LOWER LEVEL PLAN**  
SCALE: 1/4" = 1'-0"  
PLANS/STAIR 5 21

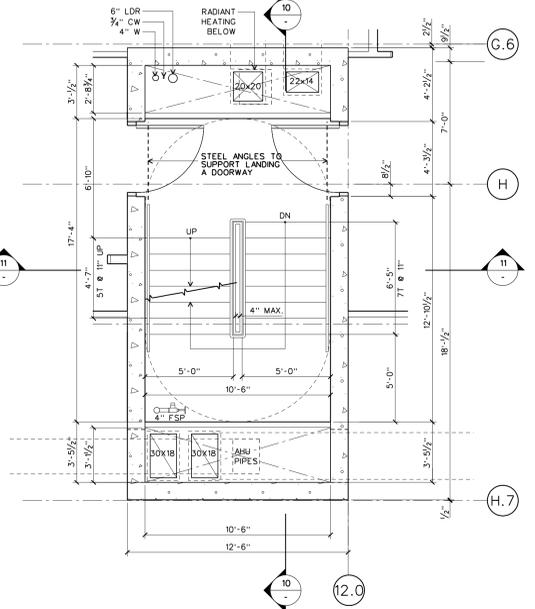


**STAIR 5: SECOND LEVEL PLAN**  
SCALE: 1/4" = 1'-0"  
PLANS/STAIR 5 20

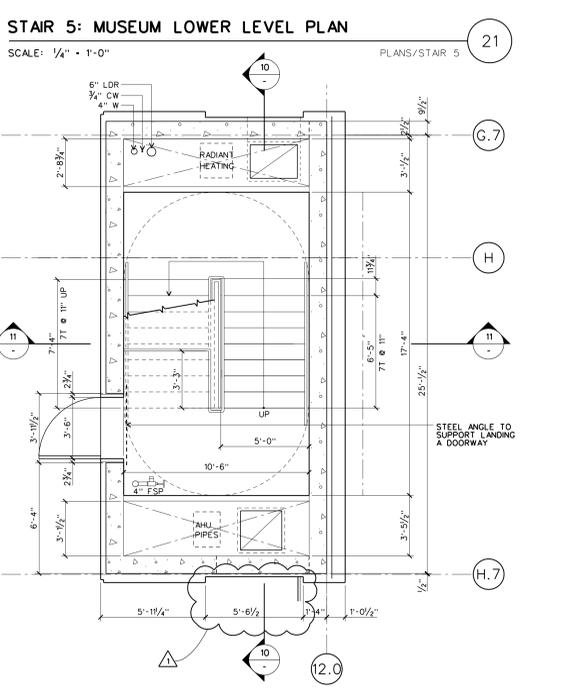

**STAIR 5: GROUND LEVEL PLAN**  
SCALE: 1/4" = 1'-0"  
PLANS/STAIR 5 13

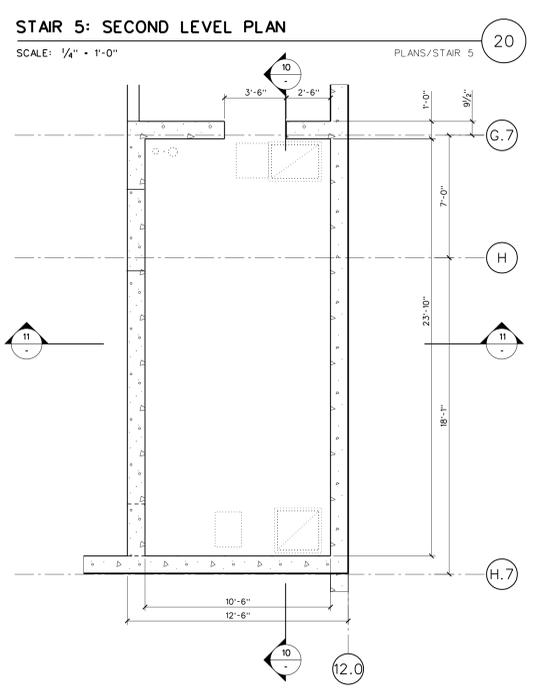

**STAIR 5: BASEMENT LEVEL PLAN**  
SCALE: 1/4" = 1'-0"  
PLANS/STAIR 5 12

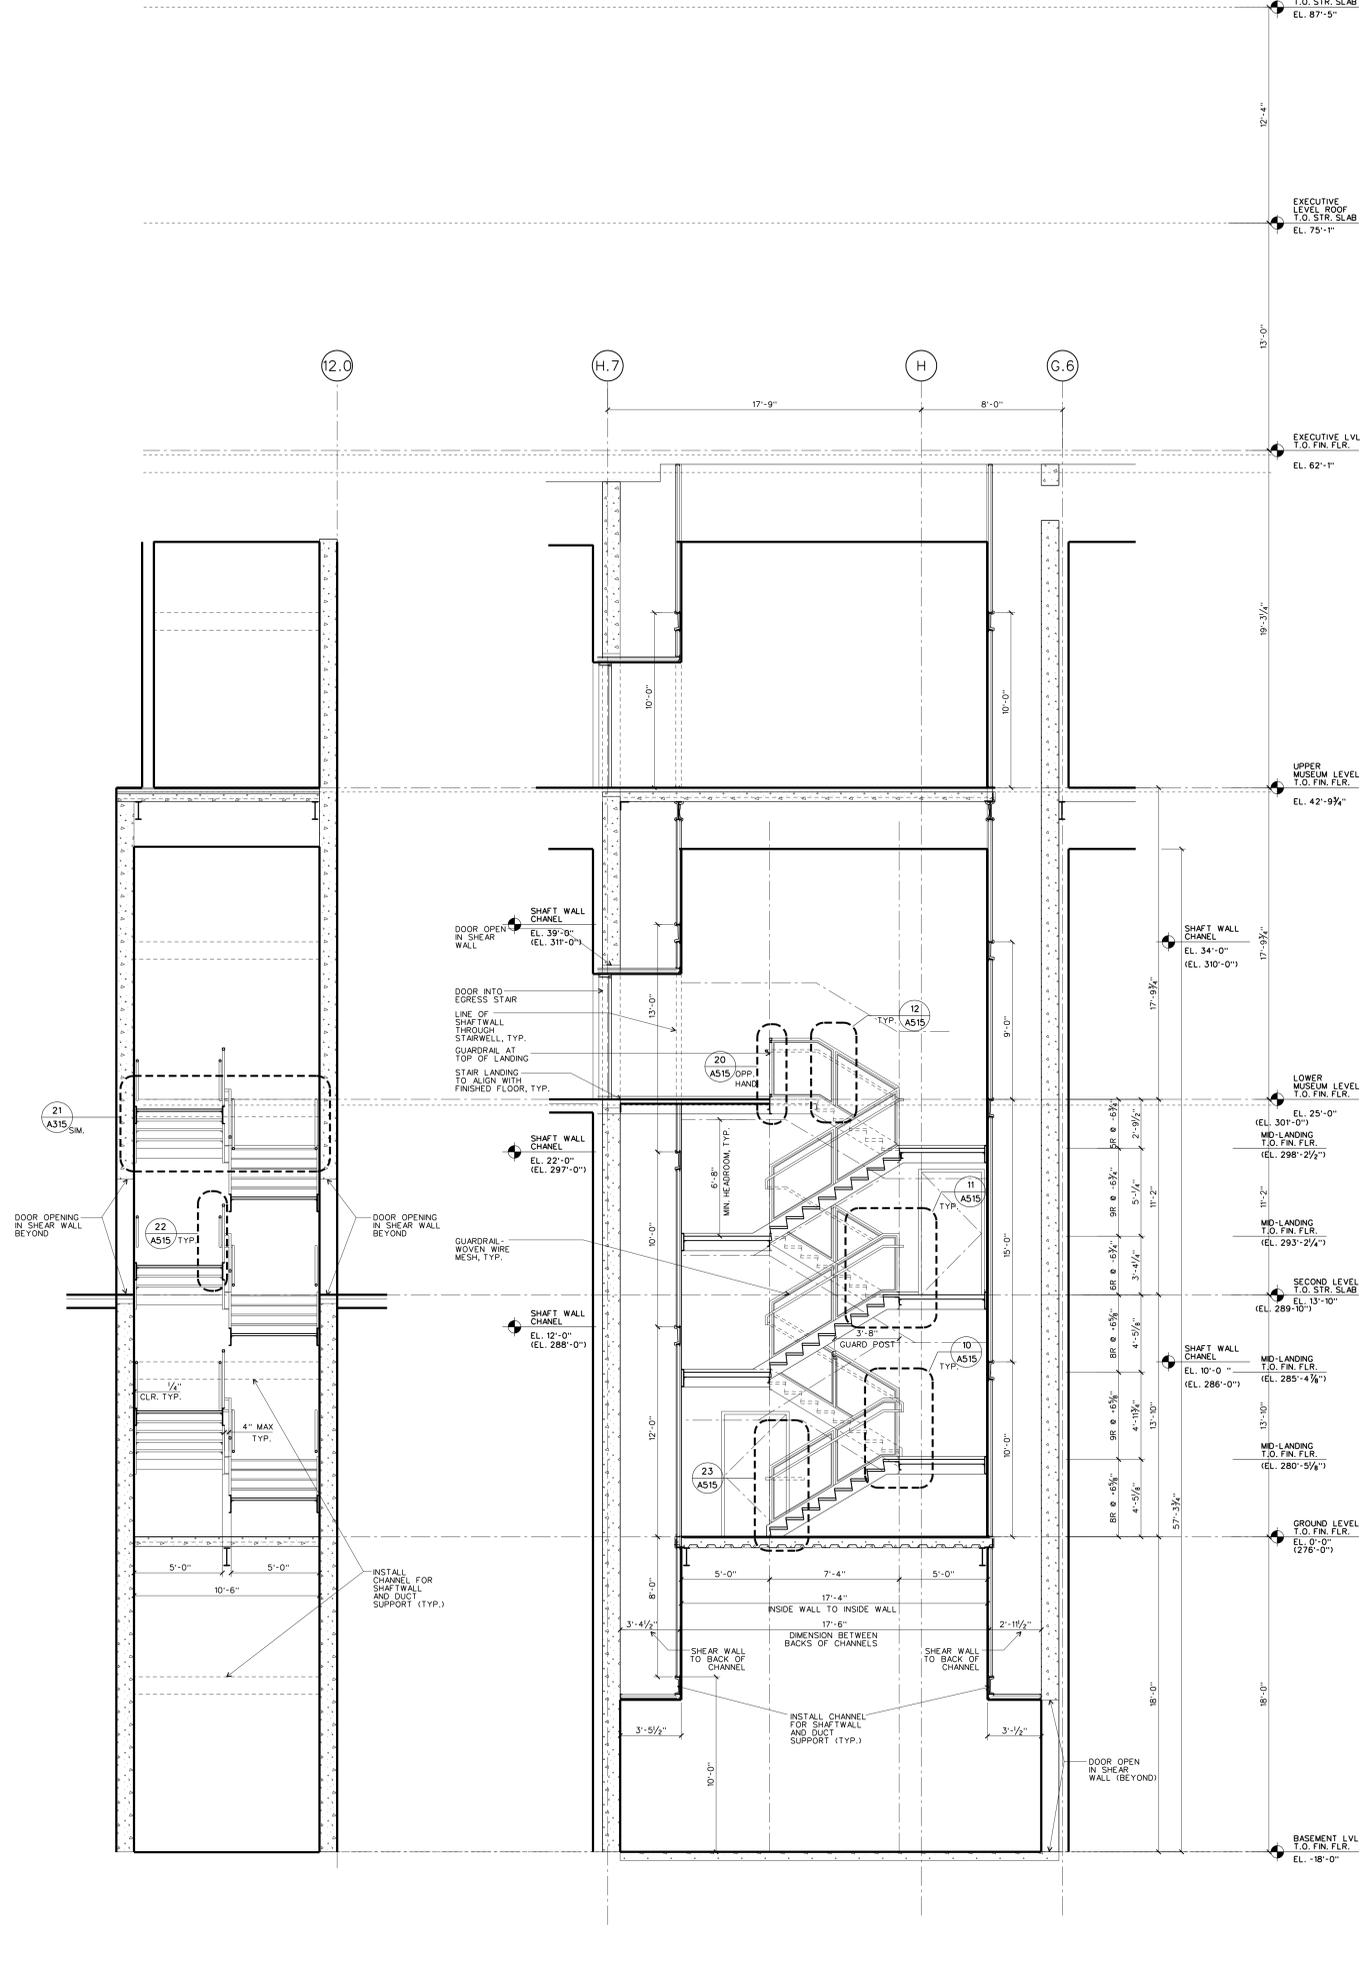

**STAIR 5: N/S SECTION LOOKING EAST**  
SCALE: 1/4" = 1'-0"  
PLANS/STAIR 5 11

**STAIR 5: E/W SECTION LOOKING NORTH**  
SCALE: 1/4" = 1'-0"  
PLANS/STAIR 5 10