


Addendum #	Date
100% Construction Documents	09/27/02
90% Progress Printing	08/30/02
100% Struct./ CD Progress	07/01/02
Bridge Bldg. Substructure	06/14/02
100% Steel & Concrete CD	05/15/02
& Architectural CD Progress	
100% Design Development*	03/01/02

*Issued originally as A504


Job No.	Scale	Date	Title
9908	1/4" = 1'-0"	September 27, 2002	MUSEUM BUILDING STAIR 6: PLANS AND SECTIONS

Sheet No.


A507

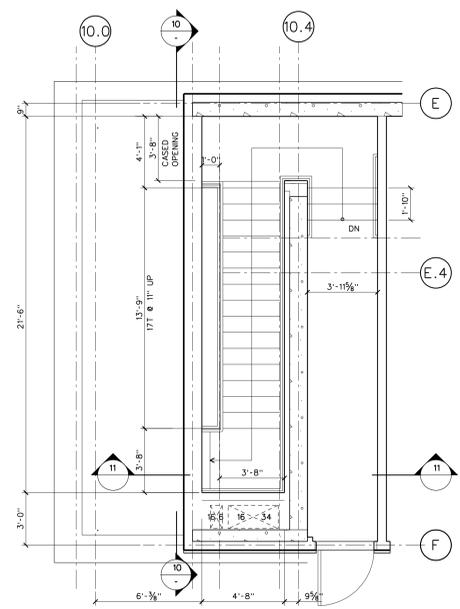


STAIR 6: MECH LEVEL PLAN
SCALE: 1/4" = 1'-0" **31**

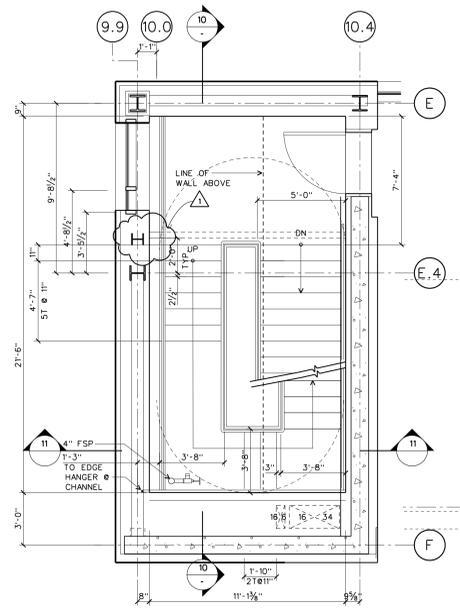


STAIR 6: EXEC LEVEL PLAN
SCALE: 1/4" = 1'-0" **30**

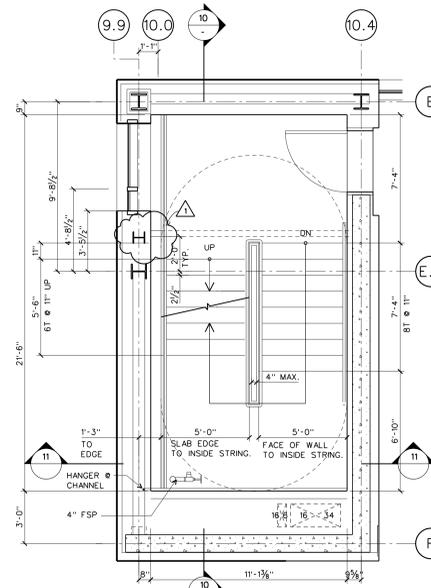


STAIR 6: INTERMEDIATE LEVEL PLAN
SCALE: 1/4" = 1'-0" **22**

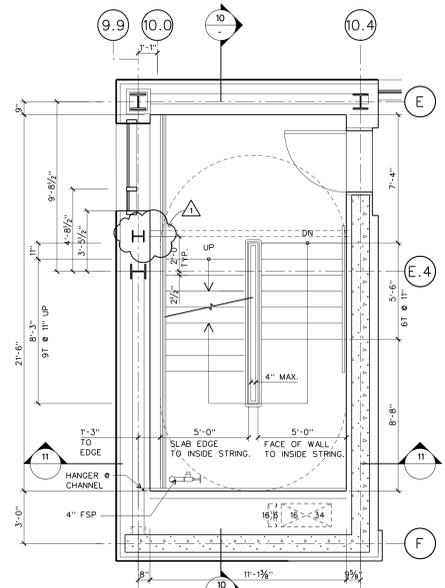


STAIR 6: UPPER MUSEUM LEVEL
SCALE: 1/4" = 1'-0" **21**

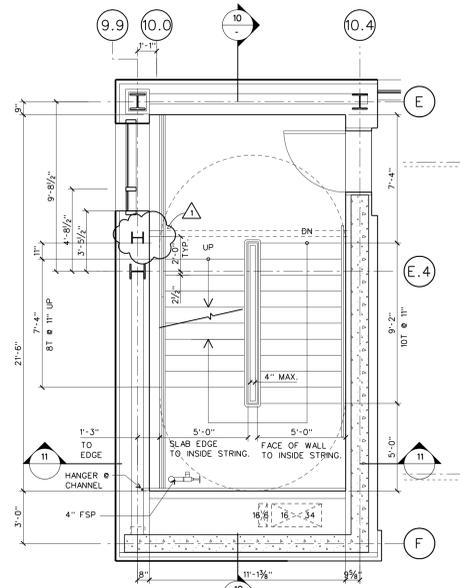


STAIR 6: MUSEUM LOWER LEVEL
SCALE: 1/4" = 1'-0" **20**

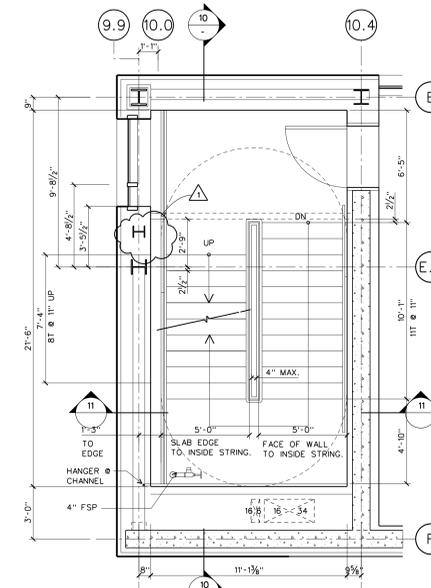


STAIR 6: SECOND LEVEL PLAN
SCALE: 1/4" = 1'-0" **14**

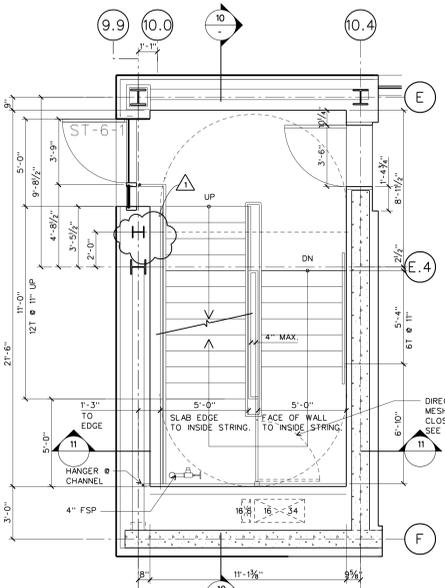


STAIR 6: GROUND LEVEL PLAN
SCALE: 1/4" = 1'-0" **13**

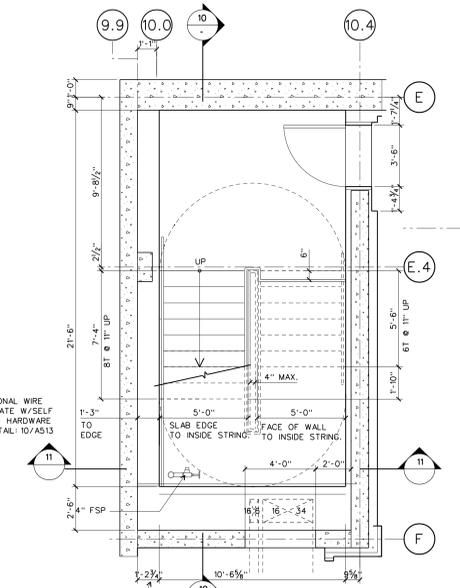


STAIR 6: BASEMENT LEVEL PLAN
SCALE: 1/4" = 1'-0" **12**

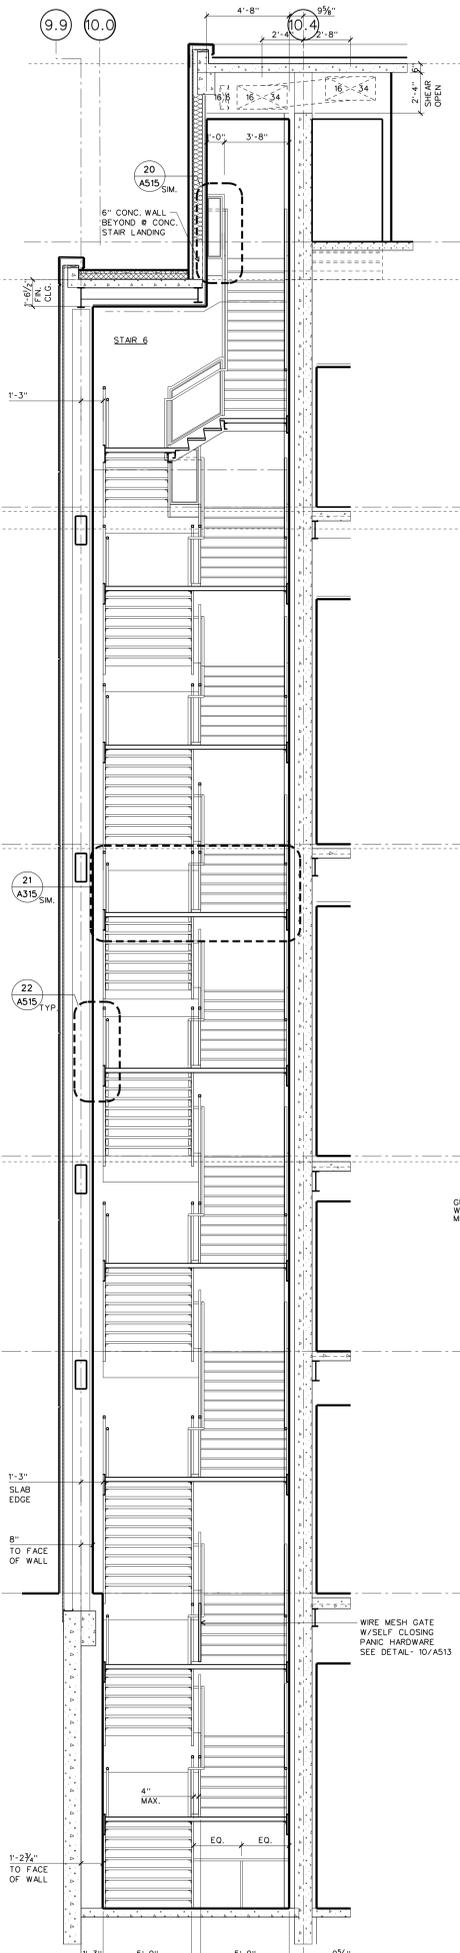

STAIR 6: N/S SECTION
SCALE: 1/4" = 1'-0" **11**

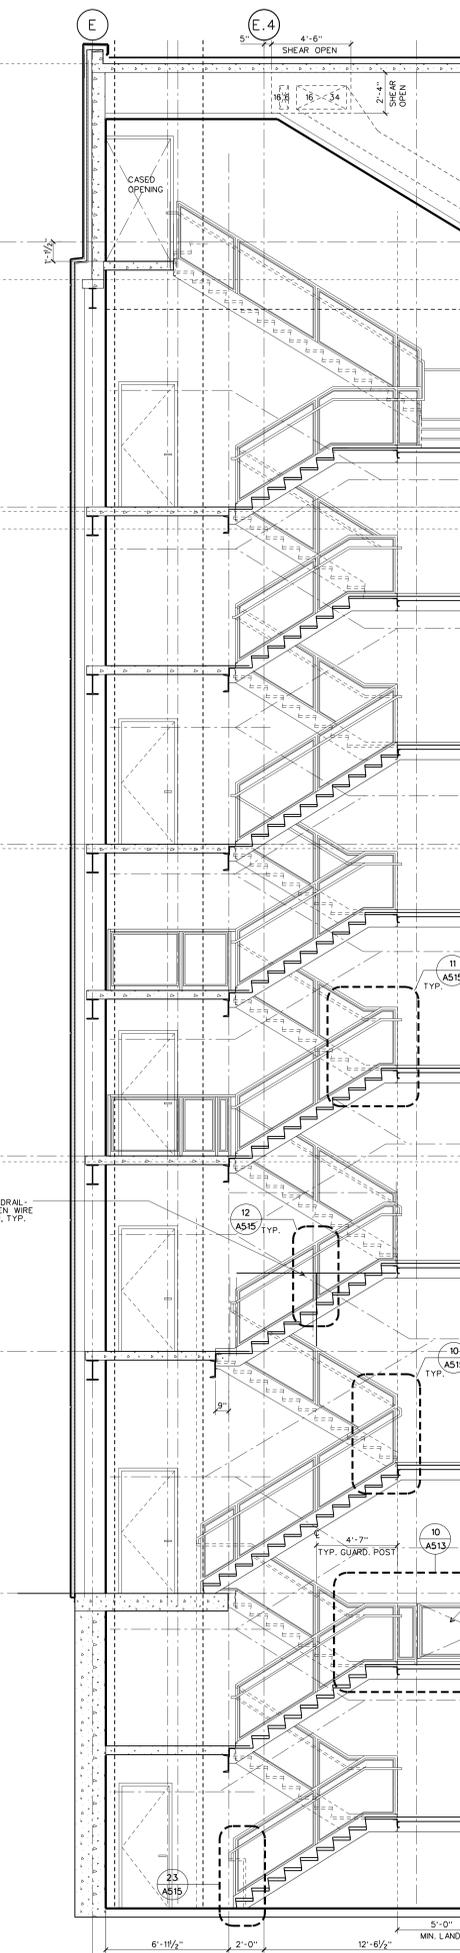

STAIR 6: E/W SECTION
SCALE: 1/4" = 1'-0" **10**

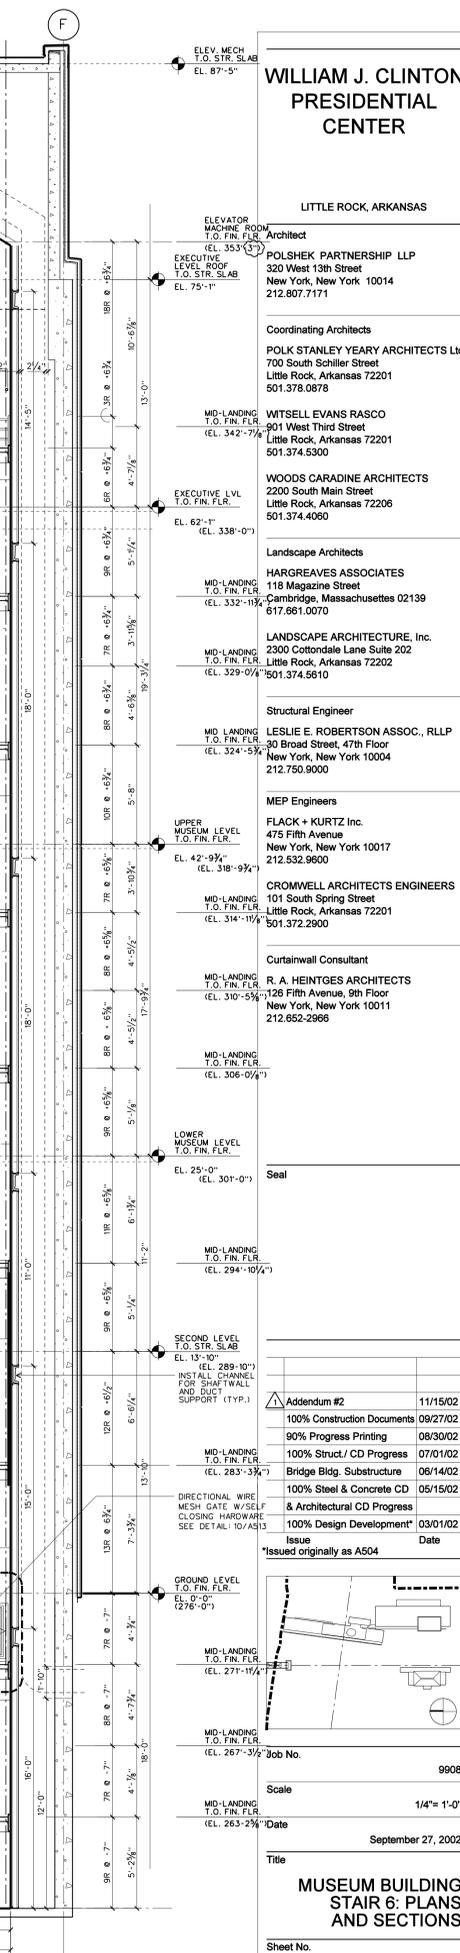

10