




TYP. WALL BRACKET - PLAN DETAIL 40
SCALE: 3" = 1'-0" D-FIRE-STAIR

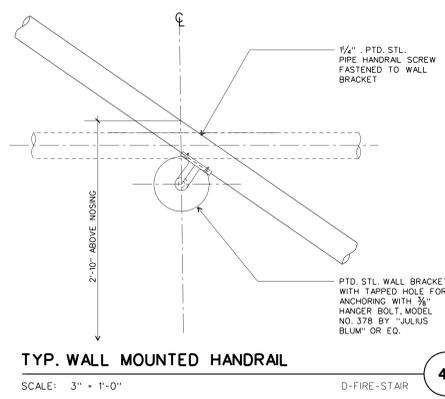


TYP. WALL MOUNTED HANDRAIL 41
SCALE: 3" = 1'-0" D-FIRE-STAIR

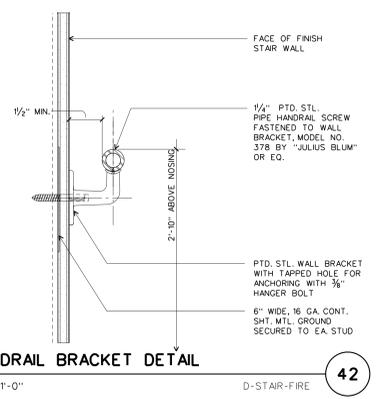


TYP. HANDRAIL BRACKET DETAIL 42
SCALE: 3" = 1'-0" D-STAIR-FIRE

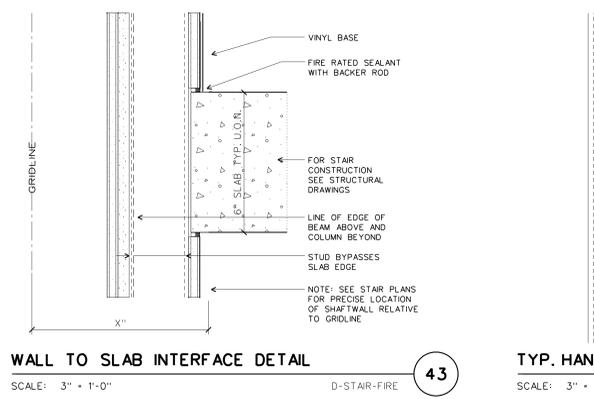


WALL TO SLAB INTERFACE DETAIL 43
SCALE: 3" = 1'-0" D-STAIR-FIRE

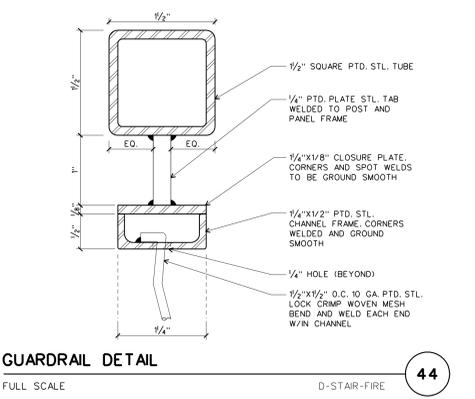


GUARDRAIL DETAIL 44
FULL SCALE D-STAIR-FIRE

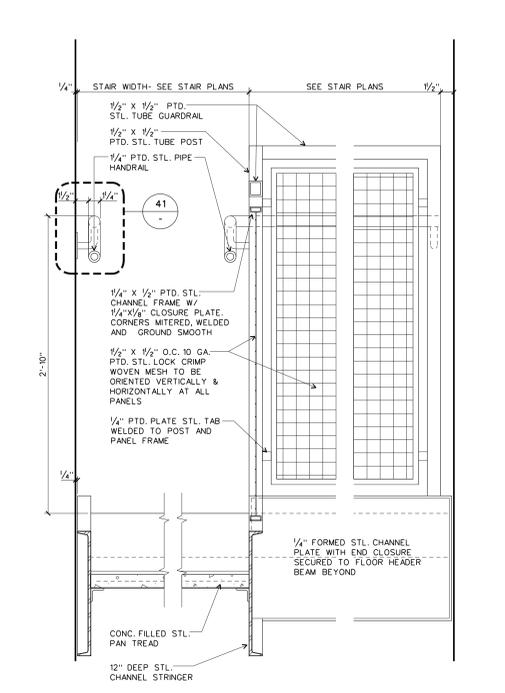


HAND / GUARDRAIL AT UPPER FLOOR LANDING (ALIGNED) 20
SCALE: 1/2" = 1'-0" D-STAIR-FIRE

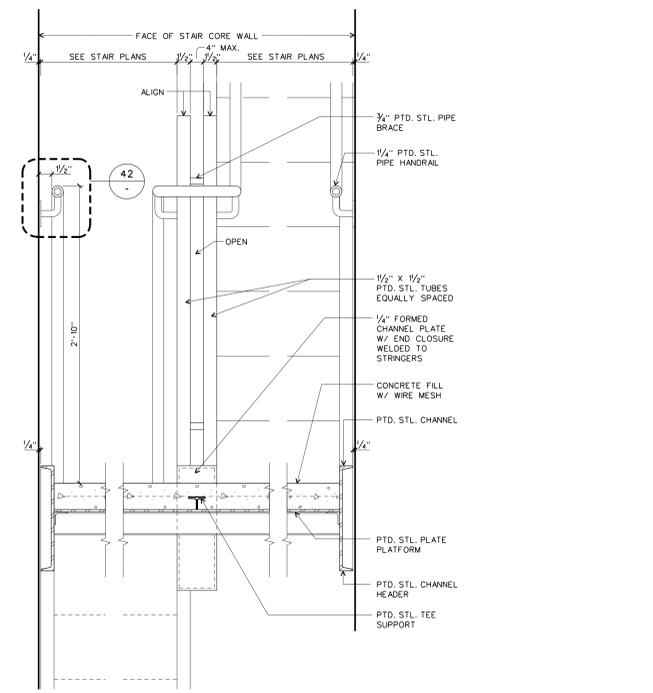


HAND / GUARDRAIL AT INTERMEDIATE LANDING (OFFSET) 21
SCALE: 1/2" = 1'-0" D-STAIR-FIRE

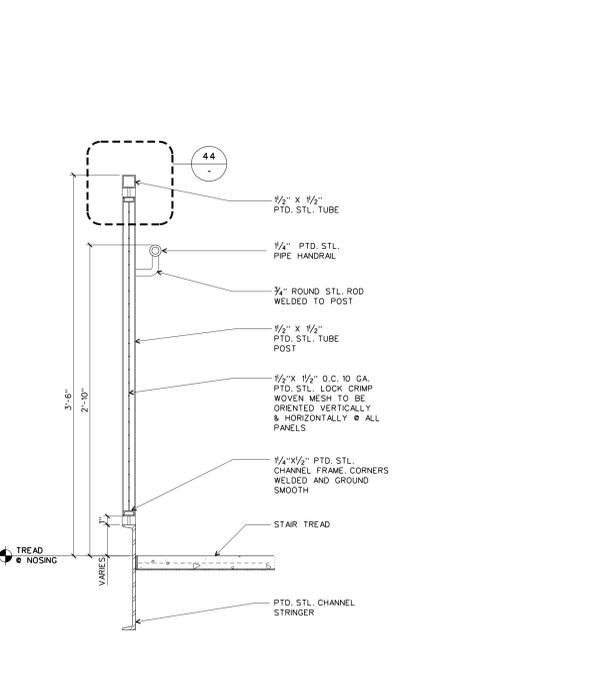


HAND / GUARDRAIL - TYPICAL SECTION 22
SCALE: 1/2" = 1'-0" D-STAIR-FIRE

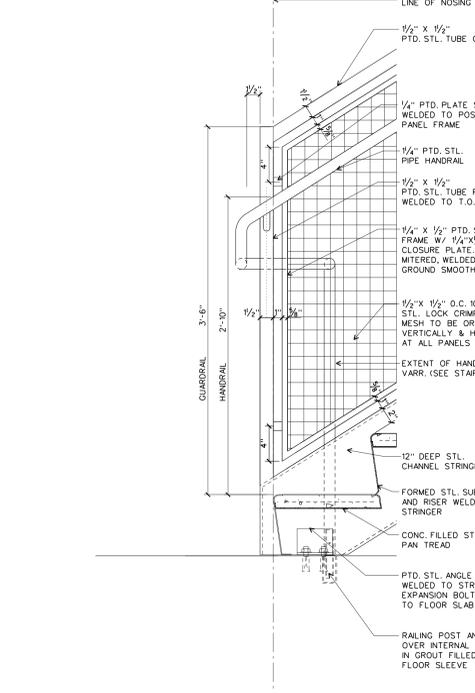


HAND / GUARDRAIL AT STAIR BOTTOM 23
SCALE: 1/2" = 1'-0" D-STAIR-FIRE

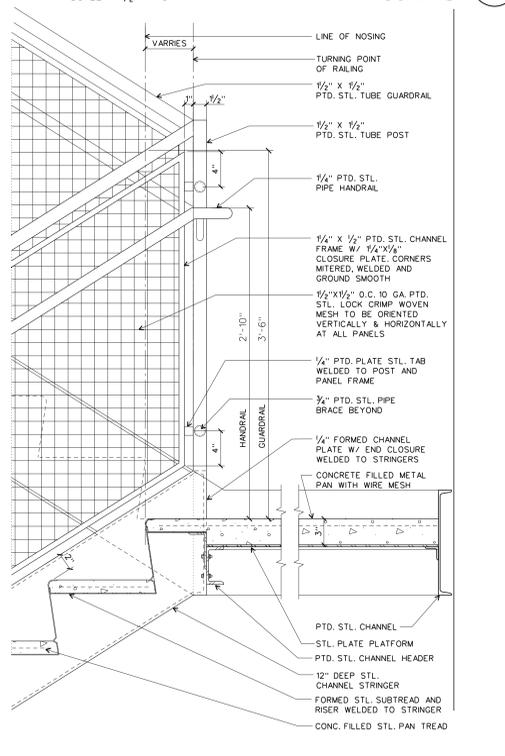


HAND / GUARDRAIL AT INTERMEDIATE LANDING (ALIGNED) 20
SCALE: 1/2" = 1'-0" D-FIRE-STAIR

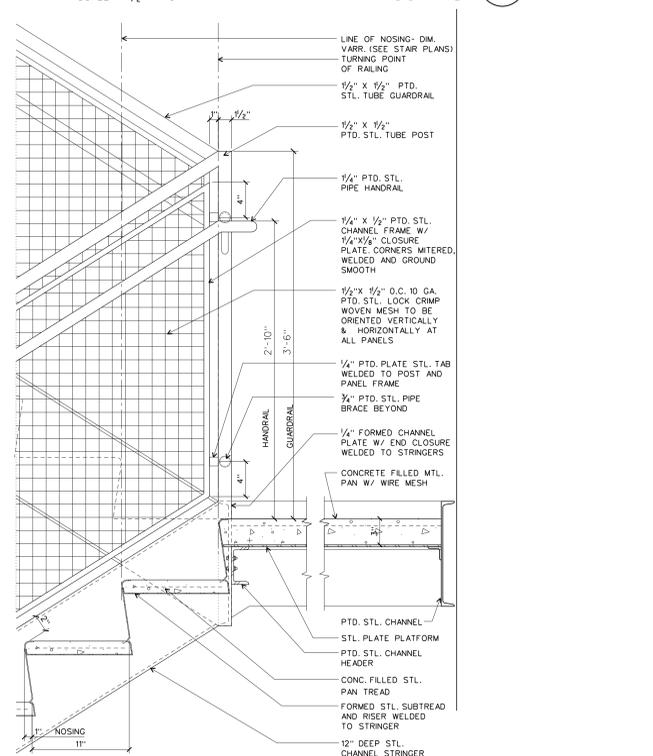

HAND / GUARDRAIL AT INTERMEDIATE LANDING (OFFSET) 21
SCALE: 1/2" = 1'-0" D-FIRE-STAIR

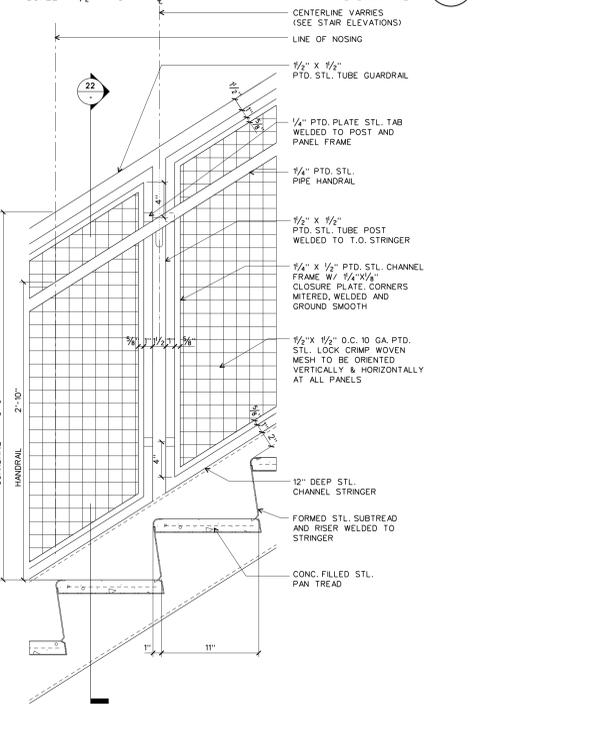

HAND / GUARDRAIL TYPICAL POST DETAIL 22
SCALE: 1/2" = 1'-0" D-STAIR-FIRE

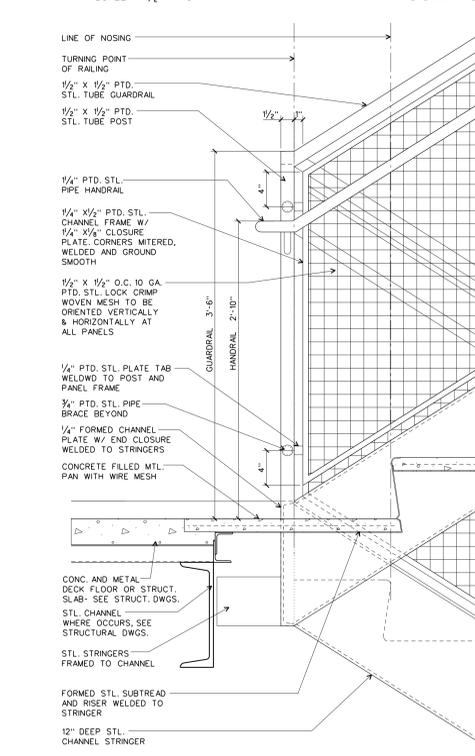

HAND / GUARDRAIL AT FLOOR LANDING 23
SCALE: 1/2" = 1'-0" D-STAIR-FIRE