

**WILLIAM J. CLINTON
PRESIDENTIAL
CENTER**

LITTLE ROCK, ARKANSAS

Architect
POLISHEK PARTNERSHIP LLP
320 West 13th Street
New York, New York 10014
212.807.7171

Coordinating Architects
POLK STANLEY YEARY ARCHITECTS LTD
700 South Schiller Street
Little Rock, Arkansas 72201
501.378.0878

WITSELL EVANS RASCO
901 West Third Street
Little Rock, Arkansas 72201
501.374.5300

WOODS CARADINE ARCHITECTS
2200 South Main Street
Little Rock, Arkansas 72206
501.374.4960

Landscape Architects
HARGREAVES ASSOCIATES
118 Magazine Street
Cambridge, Massachusetts 02139
617.661.0070

LANDSCAPE ARCHITECTURE, Inc.
2300 Cottondale Lane Suite 202
Little Rock, Arkansas 72202
501.374.5810

Structural Engineer
LESLIE E. ROBERTSON ASSOC., RLLP
30 Broad Street, 47th Floor
New York, New York 10004
212.750.9000


MEP Engineers
FLACK + KURTZ Inc.
475 Fifth Avenue
New York, New York 10017
212.532.9600

CROMWELL ARCHITECTS ENGINEERS
101 South Spring Street
Little Rock, Arkansas 72201
501.372.2900

Curtainwall Consultant
R. A. HEINTGES ARCHITECTS
126 Fifth Avenue, 9th Floor
New York, New York 10011
212.652-2968

Seal

Issue	Date
ASI #30	04/12/04
ASI #20	08/06/03
ASI #18	04/18/03
100% Construction Documents	09/27/02

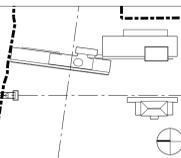

Job No. 9908

Scale AS NOTED

Date September 27, 2002


Title

ESCALATOR PLANS
AND DETAILS

Sheet No.

A521.1


FOR OFFICIAL USE ONLY

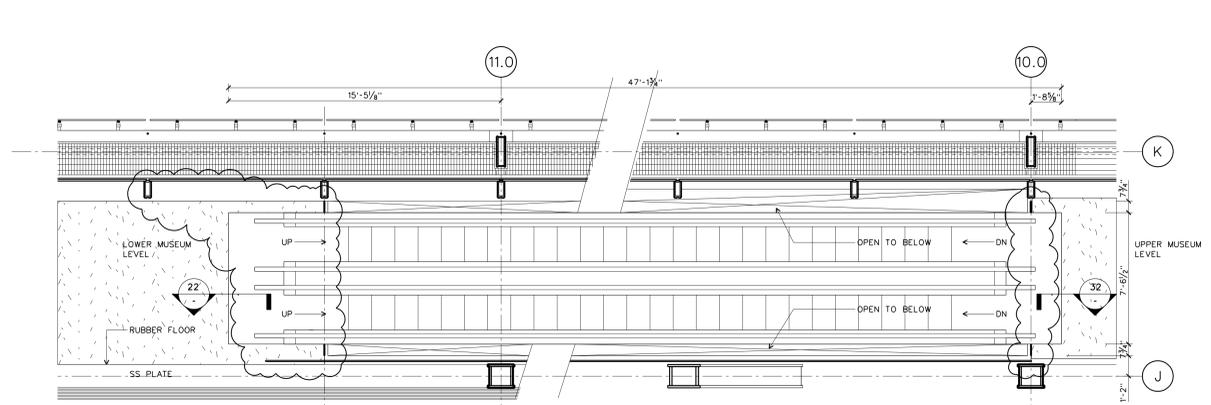

PLAN DETAIL AT ESCALATOR 2 - LOWER MUSEUM LEVEL TO UPPER MUSEUM LEVEL

SCALE: 1/4" = 1'-0"


d-escalator-dtls 40

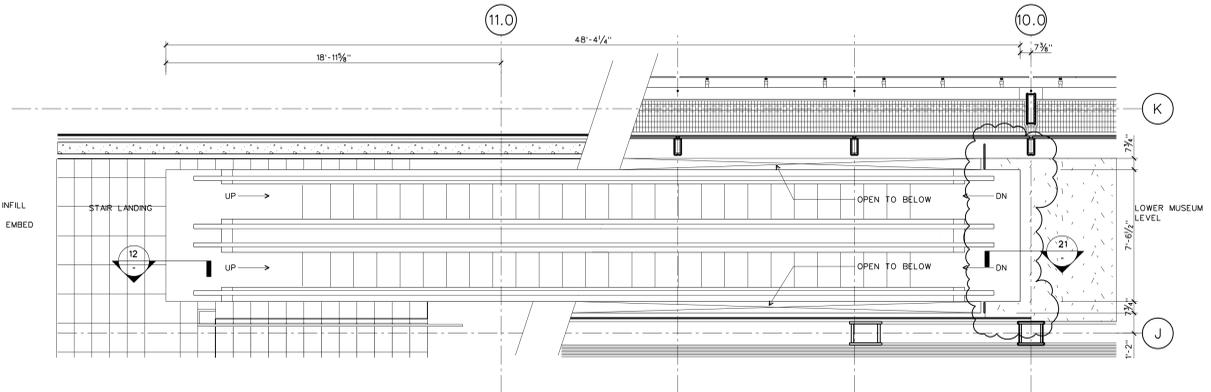

PLAN DETAIL AT ESCALATOR 1 - GROUND FLOOR TO LOWER MUSEUM LEVEL

SCALE: 1/4" = 1'-0"


d-escalator-dtls 30

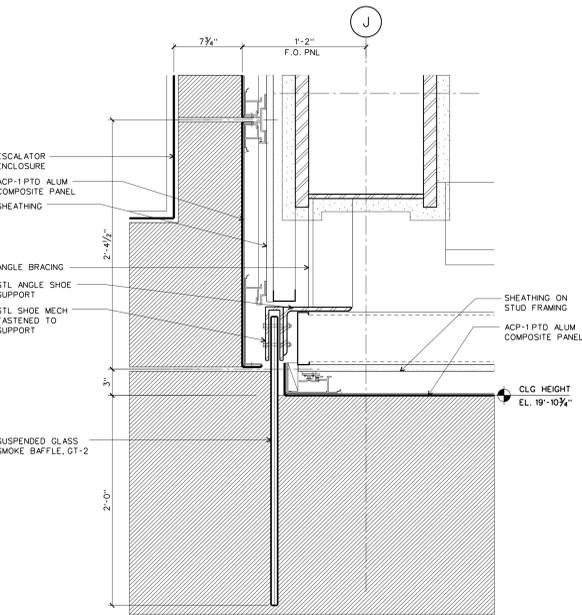

DETAIL AT SMOKE BAFFLE

SCALE: 1-1/2" = 1'-0"


d-escalator-dtls 32

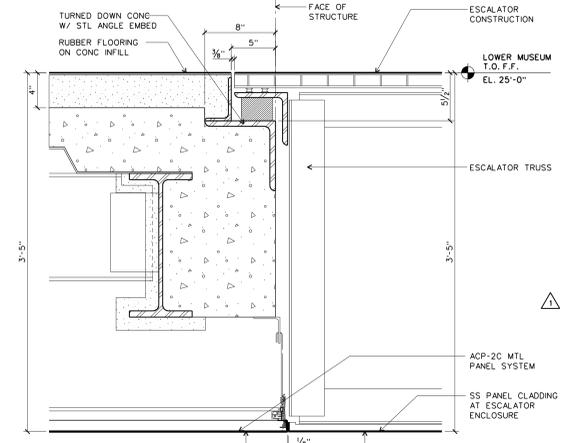

SILL DETAIL AT LOWER MUSEUM LEVEL

SCALE: 1-1/2" = 1'-0"


d-escalator-dtls 22

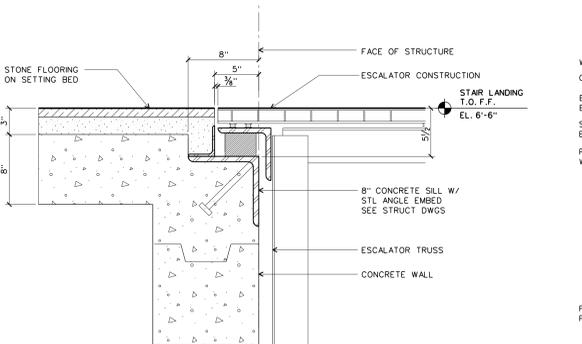

SILL DETAIL AT STAIR LANDING

SCALE: 1-1/2" = 1'-0"


d-escalator-dtls 12

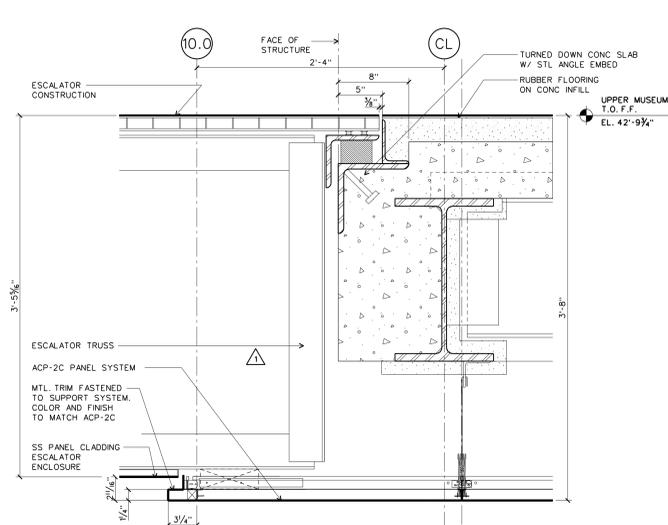

SILL DETAIL AT UPPER MUSEUM LEVEL

SCALE: 1-1/2" = 1'-0"


d-escalator-dtls 31

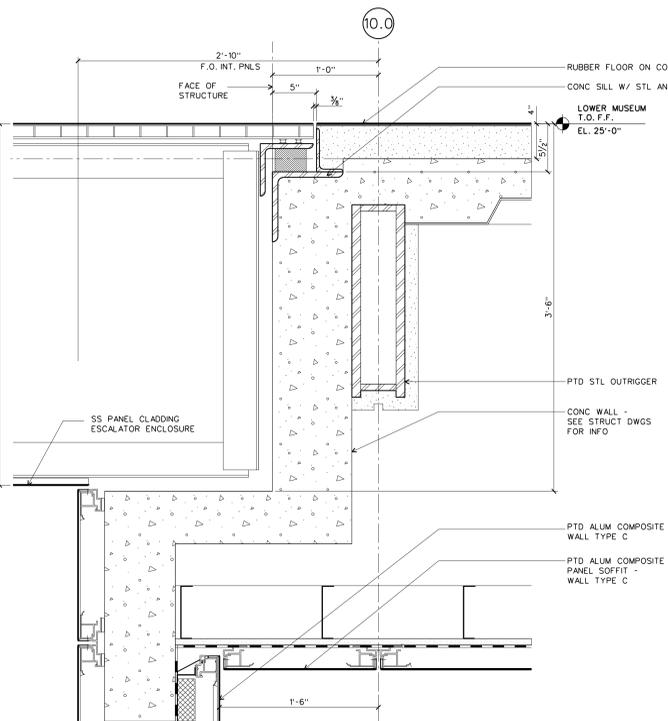

SILL DETAIL AT LOWER MUSEUM LEVEL

SCALE: 1-1/2" = 1'-0"


d-escalator-dtls 21

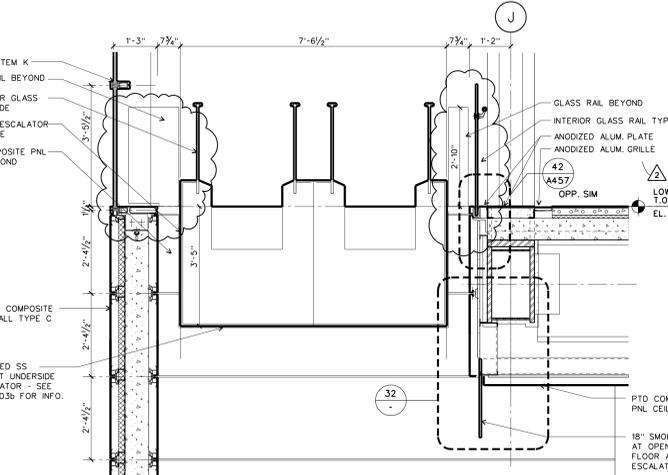

DETAIL SECTION AT LOWER ESCALATOR

SCALE: 1/2" = 1'-0"

d-escalator-dtls 11

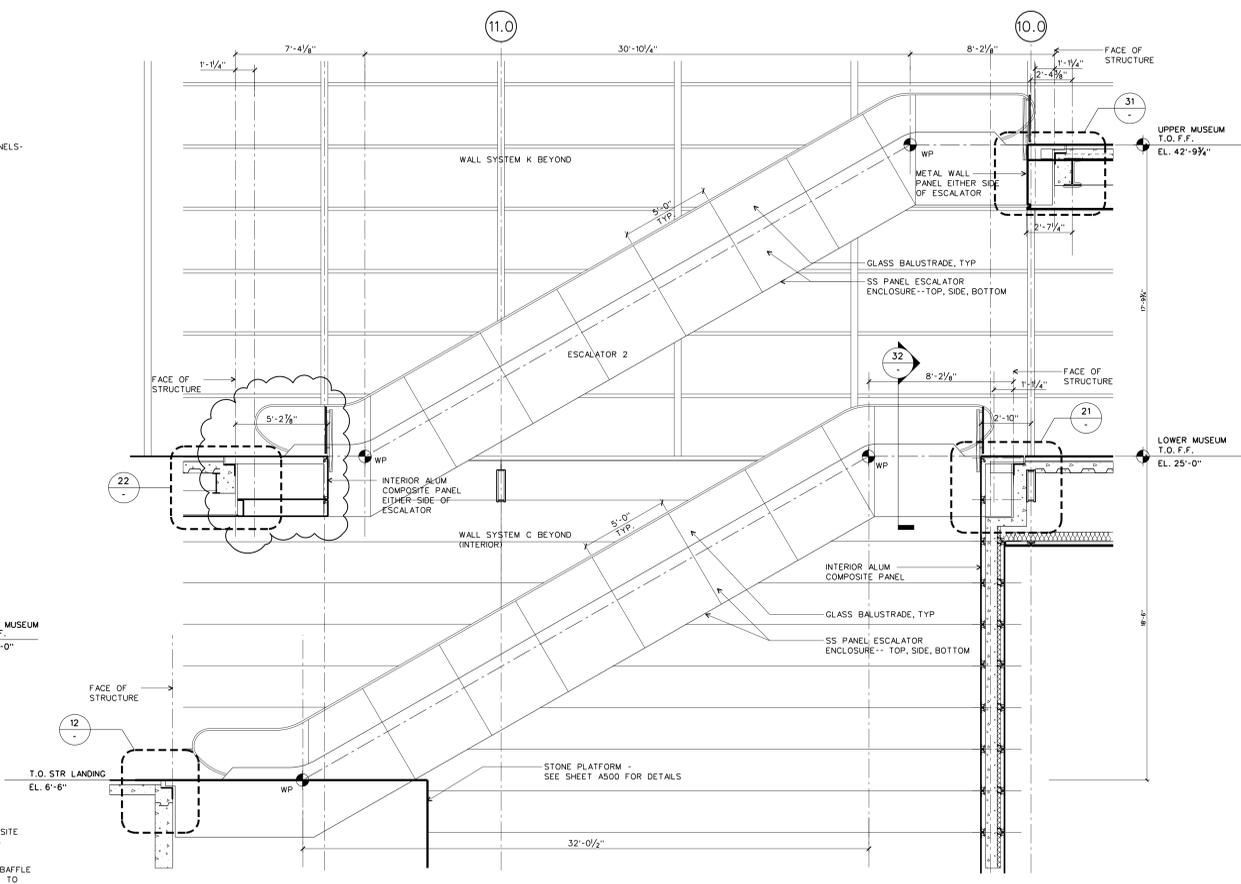

DETAIL SECTION OF ESCALATORS LOOKING WEST

SCALE: 1/4" = 1'-0"

d-escalator-dtls 10