




NORTH

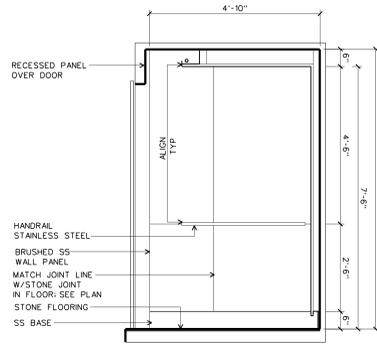

EAST

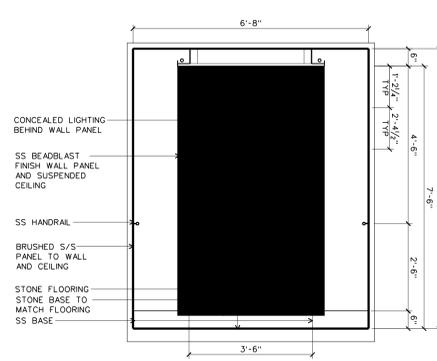

SOUTH

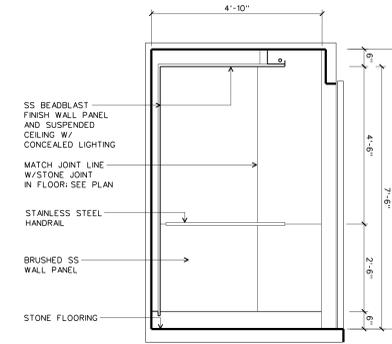

WEST

INTERIOR CAB ELEVATIONS



SCALE: 1/2" = 1'-0"

D-ELEVATORP1.DGN 31

ELEVATOR P1 & P2 MACHINE ROOM PLAN

SCALE: 1/4" = 1'-0"


D-ELEVATORP1.DGN 30

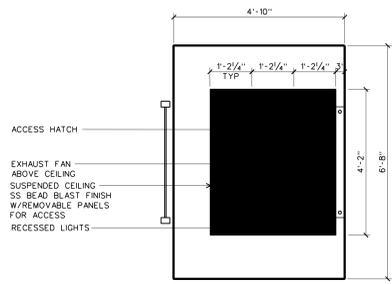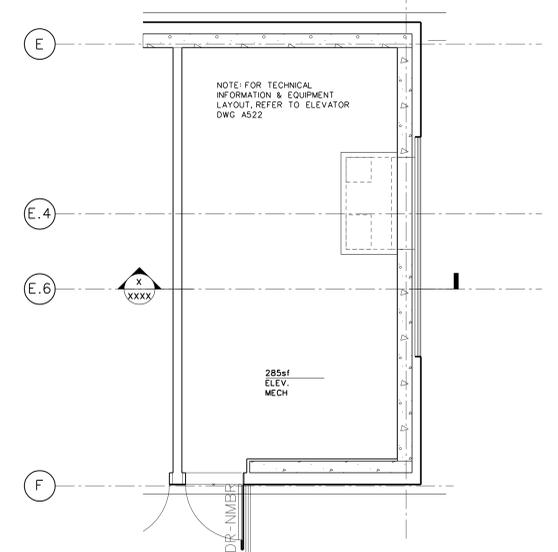

REFLECTED CAB CEILING PLAN

SCALE: 1/2" = 1'-0"


D-ELEVATORP1.DGN 23

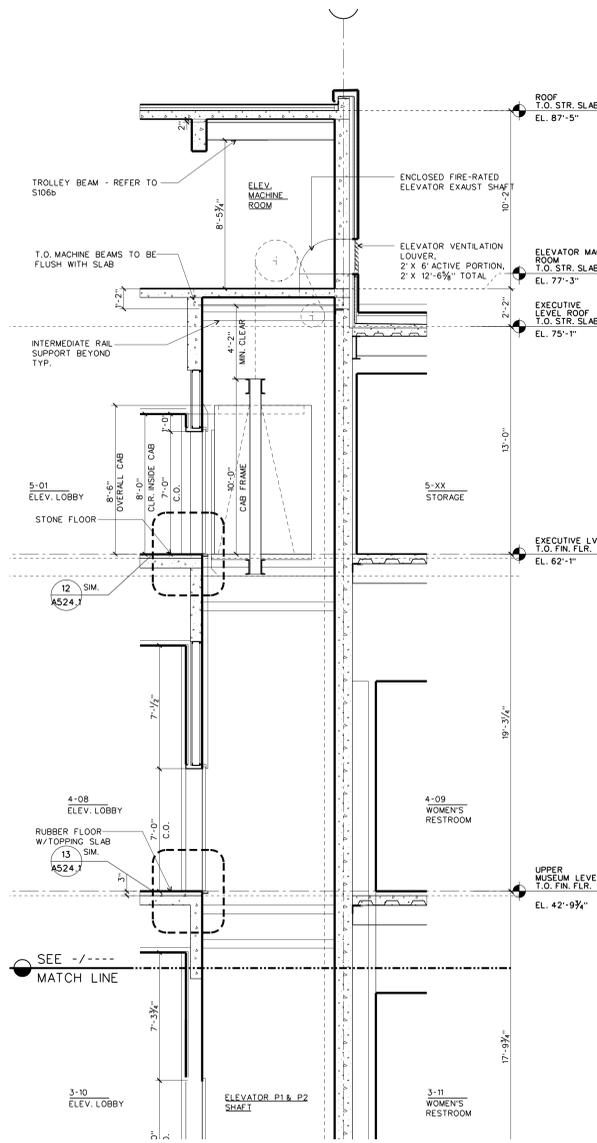

SECTION ELEVATION: LWR MUSEUM LVL TO MACHINE RM LVL

SCALE: 1/4" = 1'-0"

D-ELEVATORP1.DGN 12

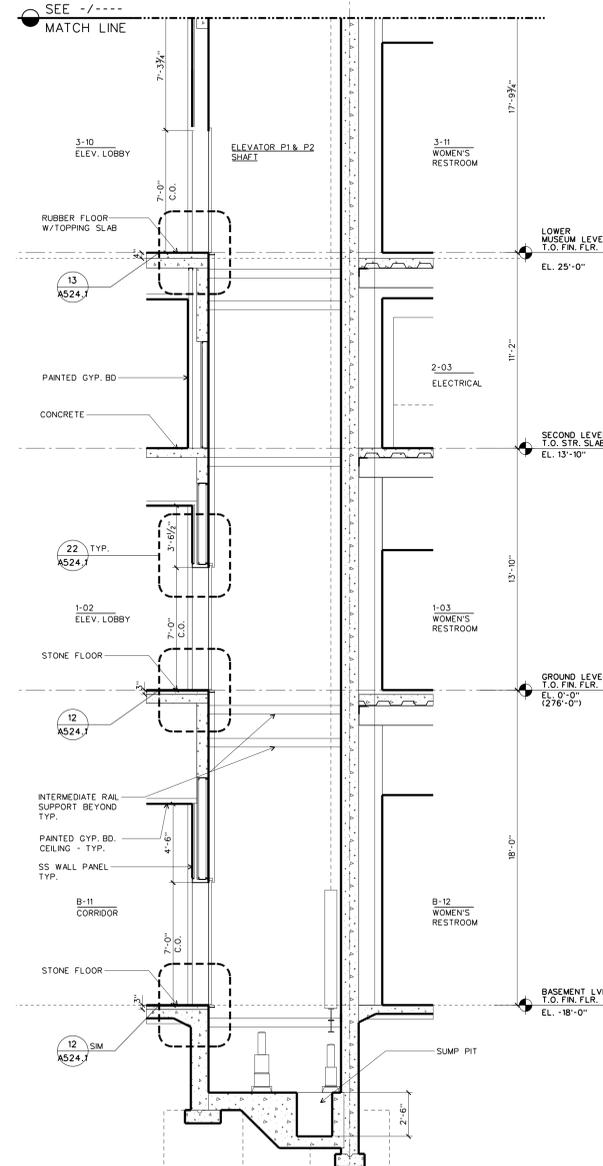

SECTION ELEVATION: BASEMENT TO LWR MUSEUM LEVEL


SCALE: 1/4" = 1'-0"

D-ELEVATORP1.DGN 11

TYP. ELEVATOR HOISTWAY PLAN

SCALE: 1/4" = 1'-0"


D-ELEVATORP1.DGN 20

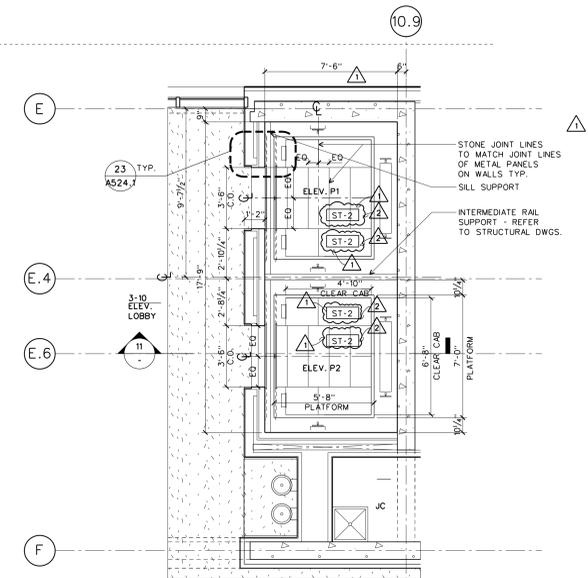

ELEVATOR PIT PLAN

SCALE: 1/4" = 1'-0"

D-ELEVATORP1.DGN 10

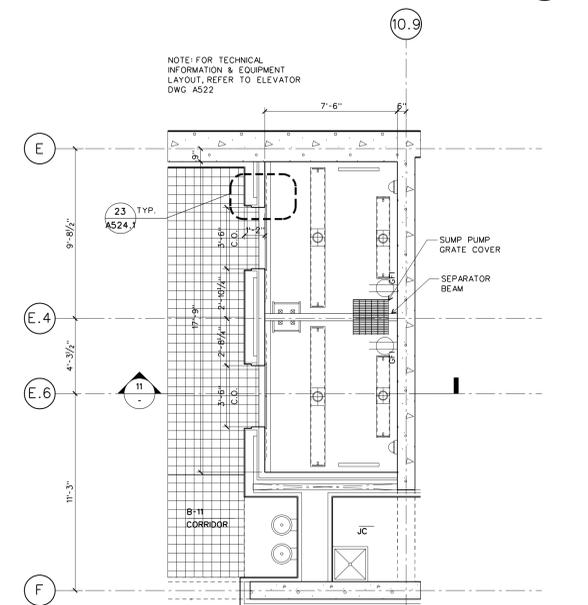

WILLIAM J. CLINTON
PRESIDENTIAL
CENTER

LITTLE ROCK, ARKANSAS

Architect
POLSHKE PARTNERSHIP LLP
320 West 13th Street
New York, New York 10014
212.807.7171

Coordinating Architects
POLK STANLEY YEARY ARCHITECTS LTD
700 South Schiller Street
Little Rock, Arkansas 72201
501.378.0878

WITSELL EVANS RASCO
901 West Third Street
Little Rock, Arkansas 72201
501.374.5300

WOODS CARADINE ARCHITECTS
2200 South Main Street
Little Rock, Arkansas 72206
501.374.4960

Landscape Architects
HARGREAVES ASSOCIATES
118 Magazine Street
Cambridge, Massachusetts 02139
617.661.0070

LANDSCAPE ARCHITECTURE, Inc.
2300 Cottondale Lane Suite 202
Little Rock, Arkansas 72202
501.374.5810

Structural Engineer
LESLIE E. ROBERTSON ASSOC., RLLP
30 Broad Street, 47th Floor
New York, New York 10004
212.750.9000


MEP Engineers
FLACK + KURTZ, Inc.
475 Fifth Avenue
New York, New York 10017
212.532.9600

CROMWELL ARCHITECTS ENGINEERS
101 South Spring Street
Little Rock, Arkansas 72201
501.372.2900

Curtainwall Consultant
R. A. HEINTGES ARCHITECTS
126 Fifth Avenue, 9th Floor
New York, New York 10011
212.652-2968

Seal

Revision	Date
AS1 #24	10/24/03
Addendum #6	12/04/02
100% Construction Documents	09/27/02
90% Progress Printing	08/30/02
100% Struct./CD Progress	07/01/02
Issue	
Issued originally as A440	

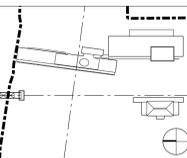

Job No. 9908

Scale AS NOTED

Date September 27, 2002

Title

ELEVATOR P1/P2:
PLANS, SECTIONS,
INTERIOR ELEVATIONS

Sheet No.

A522.1

FOR OFFICIAL USE ONLY