

100% Construction Documents	09/27/02
90% Progress Printing	08/30/02
ASI #05	08/20/02
100% Struct./ CD Progress	07/01/02
Bridge Bldg. Substructure	06/14/02
100% Steel & Concrete CD	05/15/02
& Architectural CD Progress	
100% Design Development	03/01/02
Issue	Date



Job No. 9908


Scale 1/2" = 1'-0"

Date September 27, 2002

Title INTERIOR ELEVATIONS: RESTROOMS SERVICE CORE

Sheet No.

A527


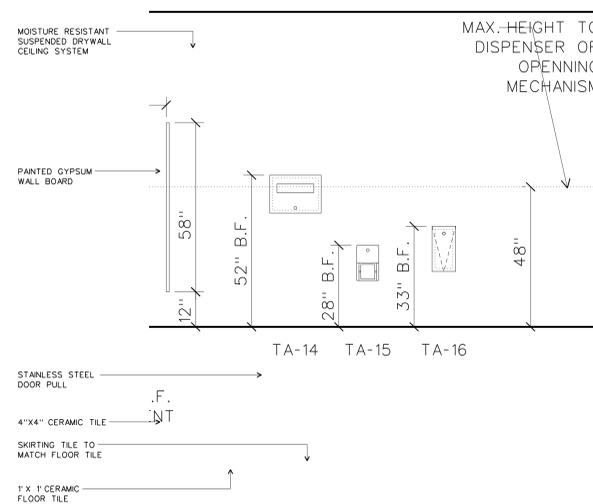


MEN'S RESTROOM: NORTH ELEVATION TYP.

SCALE: 1/2" = 1'-0"

I-ELEV BATH

21

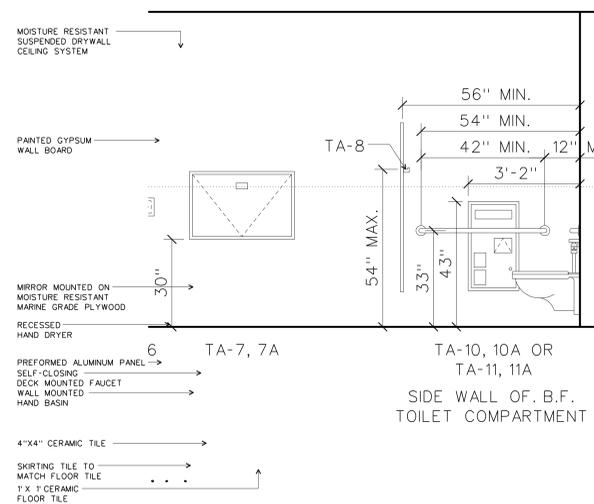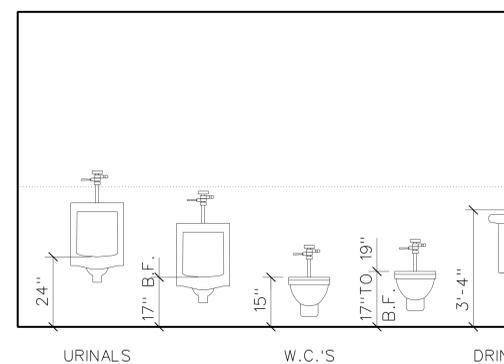

MEN'S RESTROOM: WEST ELEVATION TYP.

SCALE: 1/2" = 1'-0"

I-ELEV BATH

20


TOILET ACCESSORY SCHEDULE						
ITEM#	DESCRIPTION	MFR	MODEL #	FINISH	MOUNT	REMARKS
1A	PAPER TOWEL DISPENSER & WASTE RECEPTACLE	BOBRICK	B-3803	SATIN FINISH STAINLESS STEEL	RECESSED	5 3/4" MIN. RECESSED DEPTH
2	SANITARY NAPKIN & TAMPON VENDOR	BOBRICK	B-3500	SATIN FINISH STAINLESS STEEL	RECESSED	4" MIN. RECESSED DEPTH
3	SOAP DISPENSER	BOBRICK	B-8221	STAINLESS STEEL	LAVATORY	-
4A	MIRROR WITH FRAME AND SHELF	BOBRICK	B-166-2436	SATIN FINISH STAINLESS STEEL	SURFACE	SPECIFY SIZE

MEN'S RESTROOM: SOUTH ELEVATION TYP.

SCALE: 1/2" = 1'-0"

I-ELEV BATH

11

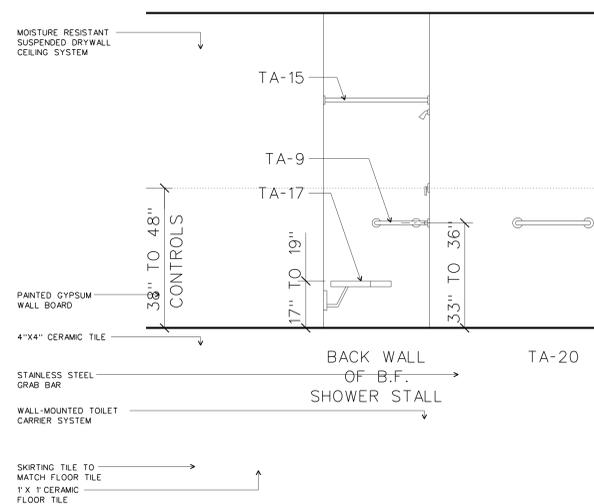

MEN'S RESTROOM: EAST ELEVATION TYP.

SCALE: 1/2" = 1'-0"

I-ELEV BATH

10