


ASI # 24	10/24/03
ASI # 22	08/01/03
ASI # 20	08/06/03
ASI # 12	02/07/02

100% Construction Documents	09/27/02
90% Progress Printing	08/30/02
100% Struct./ CD Progress	07/01/02
100% Steel & Concrete CD	05/15/02
& Architectural CD Progress	
100% Design Development	03/01/02
Issue	Date
Issued originally on A526 & A527	

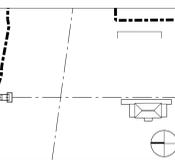


Job No. 9908

Scale 1/4"=1'-0"


Date September 27, 2002

Title **MUSEUM BUILDING RESTROOMS: PLANS AND ELEVATIONS**


Sheet No.

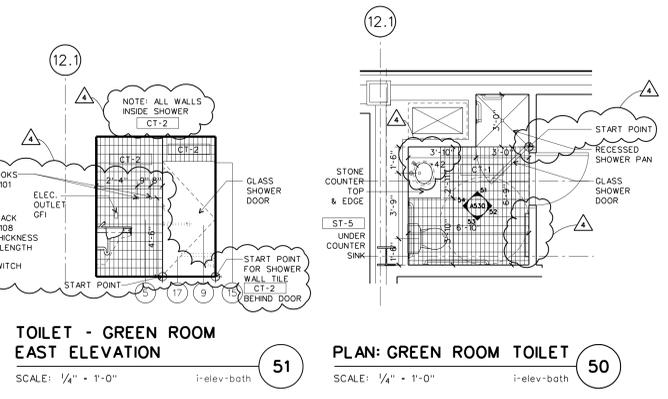


TOILET - GREEN ROOM NORTH ELEVATION SCALE: 1/4" = 1'-0" i-elev-bath 54
TOILET - GREEN ROOM WEST ELEVATION SCALE: 1/4" = 1'-0" i-elev-bath 53
TOILET - GREEN ROOM SOUTH ELEVATION SCALE: 1/4" = 1'-0" i-elev-bath 52
TOILET - GREEN ROOM EAST ELEVATION SCALE: 1/4" = 1'-0" i-elev-bath 51
PLAN: GREEN ROOM TOILET SCALE: 1/4" = 1'-0" i-elev-bath 50

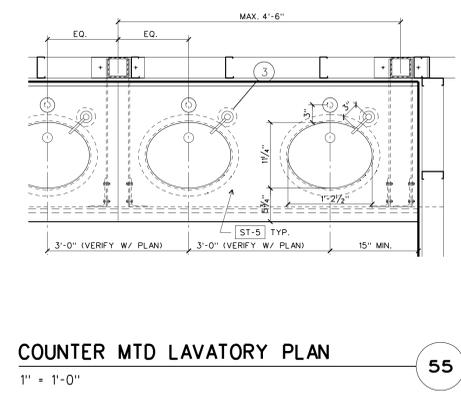


COUNTER MTD LAVATORY SECTION SCALE: 1" = 1'-0" 56
COUNTER MTD LAVATORY PLAN SCALE: 1" = 1'-0" 55

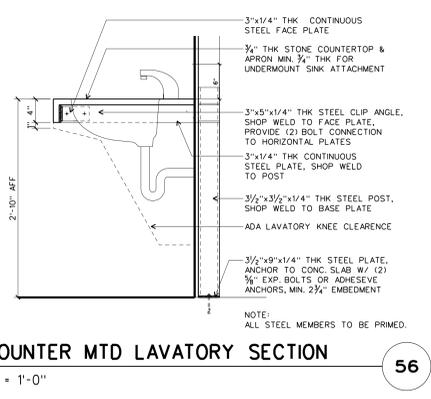


COUNTER MTD LAVATORY SECTION SCALE: 1" = 1'-0" 56

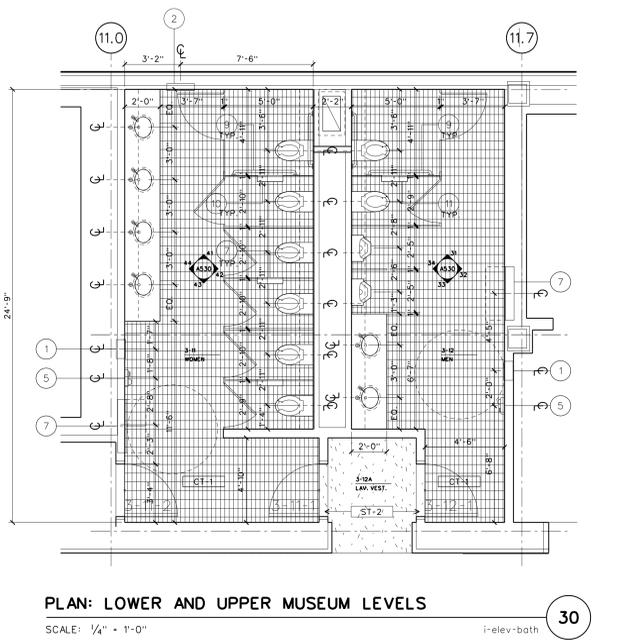


PLAN: LOWER AND UPPER MUSEUM LEVELS SCALE: 1/4" = 1'-0" i-elev-bath 30

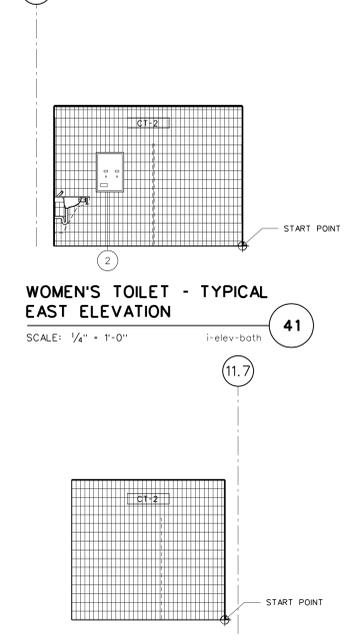


WOMEN'S TOILET - TYPICAL NORTH ELEVATION SCALE: 1/4" = 1'-0" i-elev-bath 44
WOMEN'S TOILET - TYPICAL WEST ELEVATION SCALE: 1/4" = 1'-0" i-elev-bath 43
WOMEN'S TOILET - TYPICAL SOUTH ELEVATION SCALE: 1/4" = 1'-0" i-elev-bath 42
WOMEN'S TOILET - TYPICAL EAST ELEVATION SCALE: 1/4" = 1'-0" i-elev-bath 41
MENS TOILET - TYPICAL NORTH ELEVATION SCALE: 1/4" = 1'-0" i-elev-bath 34
MENS TOILET - TYPICAL WEST ELEVATION SCALE: 1/4" = 1'-0" i-elev-bath 33
MENS TOILET - TYPICAL SOUTH ELEVATION SCALE: 1/4" = 1'-0" i-elev-bath 32
MENS TOILET - TYPICAL EAST ELEVATION SCALE: 1/4" = 1'-0" i-elev-bath 31

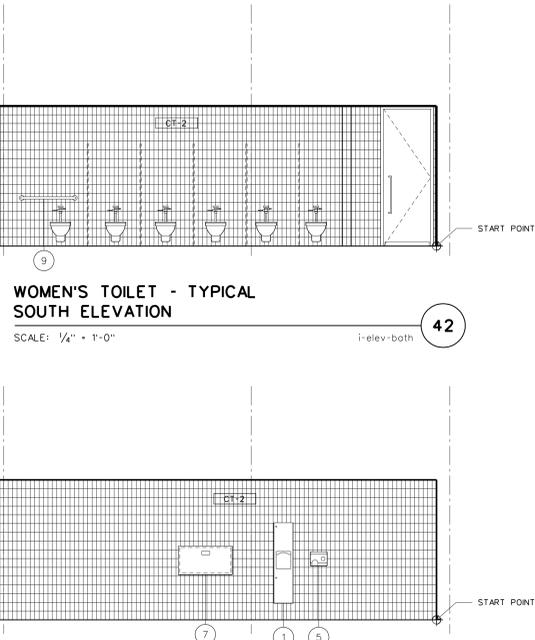

WOMEN'S TOILET - GROUND LEVEL NORTH ELEVATION SCALE: 1/4" = 1'-0" i-elev-bath 24
WOMEN'S TOILET - GROUND LEVEL WEST ELEVATION SCALE: 1/4" = 1'-0" i-elev-bath 23
WOMEN'S TOILET - GROUND LEVEL SOUTH ELEVATION SCALE: 1/4" = 1'-0" i-elev-bath 22
WOMEN'S TOILET - GROUND LEVEL EAST ELEVATION SCALE: 1/4" = 1'-0" i-elev-bath 21
MENS TOILET - GROUND LEVEL NORTH ELEVATION SCALE: 1/4" = 1'-0" i-elev-bath 14
MENS TOILET - GROUND LEVEL WEST ELEVATION SCALE: 1/4" = 1'-0" i-elev-bath 13
MENS TOILET - GROUND LEVEL SOUTH ELEVATION SCALE: 1/4" = 1'-0" i-elev-bath 12
MENS TOILET - GROUND LEVEL EAST ELEVATION SCALE: 1/4" = 1'-0" i-elev-bath 11

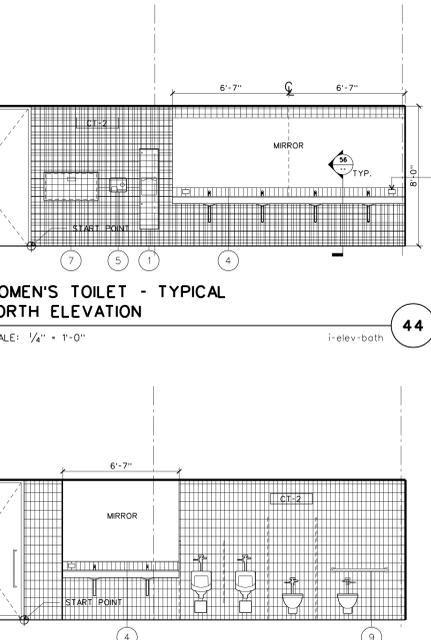

WOMEN'S TOILET - GROUND LEVEL NORTH ELEVATION SCALE: 1/4" = 1'-0" i-elev-bath 24
WOMEN'S TOILET - GROUND LEVEL WEST ELEVATION SCALE: 1/4" = 1'-0" i-elev-bath 23
WOMEN'S TOILET - GROUND LEVEL SOUTH ELEVATION SCALE: 1/4" = 1'-0" i-elev-bath 22
WOMEN'S TOILET - GROUND LEVEL EAST ELEVATION SCALE: 1/4" = 1'-0" i-elev-bath 21
MENS TOILET - GROUND LEVEL NORTH ELEVATION SCALE: 1/4" = 1'-0" i-elev-bath 14
MENS TOILET - GROUND LEVEL WEST ELEVATION SCALE: 1/4" = 1'-0" i-elev-bath 13
MENS TOILET - GROUND LEVEL SOUTH ELEVATION SCALE: 1/4" = 1'-0" i-elev-bath 12
MENS TOILET - GROUND LEVEL EAST ELEVATION SCALE: 1/4" = 1'-0" i-elev-bath 11

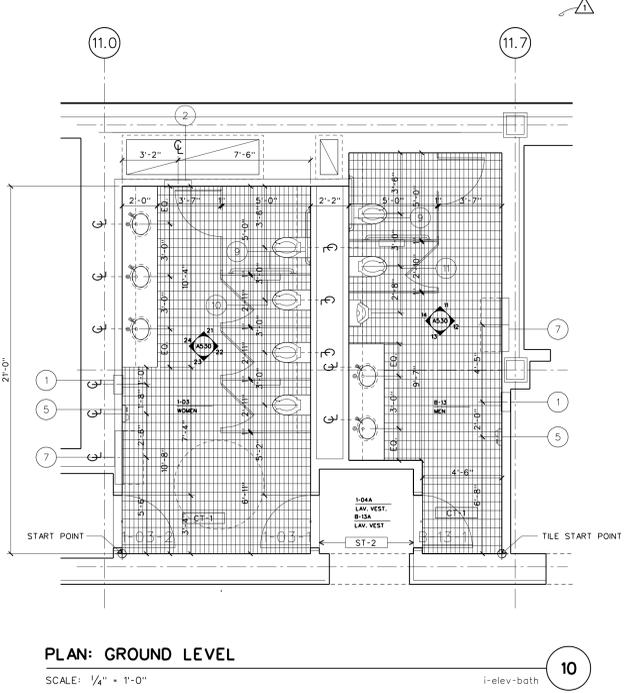

PLAN: GROUND LEVEL SCALE: 1/4" = 1'-0" i-elev-bath 10