

**WILLIAM J. CLINTON
PRESIDENTIAL
CENTER**

LITTLE ROCK, ARKANSAS

Architect

POLSHEK PARTNERSHIP LLP
320 West 13th Street
New York, New York 10014
212.807.7171

Coordinating Architects

POLK STANLEY YEARY ARCHITECTS Ltd
700 South Schiller Street
Little Rock, Arkansas 72201
501.378.0878

WITSELL EVANS RASCO
901 West Third Street
Little Rock, Arkansas 72201
501.374.5300

WOODS CARADINE ARCHITECTS
2200 South Main Street
Little Rock, Arkansas 72206
501.374.4060

Landscape Architects

HARGREAVES ASSOCIATES
118 Magazine Street
Cambridge, Massachusetts 02139
617.661.0070

LANDSCAPE ARCHITECTURE, Inc.
2300 Cottondale Lane Suite 202
Little Rock, Arkansas 72202
501.374.5810

Structural Engineer

LESLIE E. ROBERTSON ASSOC., RLLP
30 Broad Street, 47th Floor
New York, New York 10004
212.750.9000

MEP Engineers

FLACK + KURTZ, Inc.
475 Fifth Avenue
New York, New York 10017
212.532.9600

CROMWELL ARCHITECTS ENGINEERS


101 South Spring Street
Little Rock, Arkansas 72201
501.372.2900

Curtainwall Consultant

R. A. HEINTGES ARCHITECTS
126 Fifth Avenue, 9th Floor
New York, New York 10011
212.652-2968

Seal

Issue	Date
ASI #22	08/01/03
Addendum #7	12/20/02
Addendum #2	11/15/02

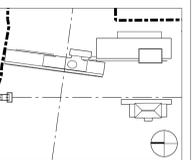

Job No. 9908

Scale 1/4" = 1'-0"


Date September 27, 2002

Title **ENLARGED CORE
PLANS, SECOND
& LOWER MUSEUM
LEVELS**

Sheet No.

A541


FOR OFFICIAL USE ONLY

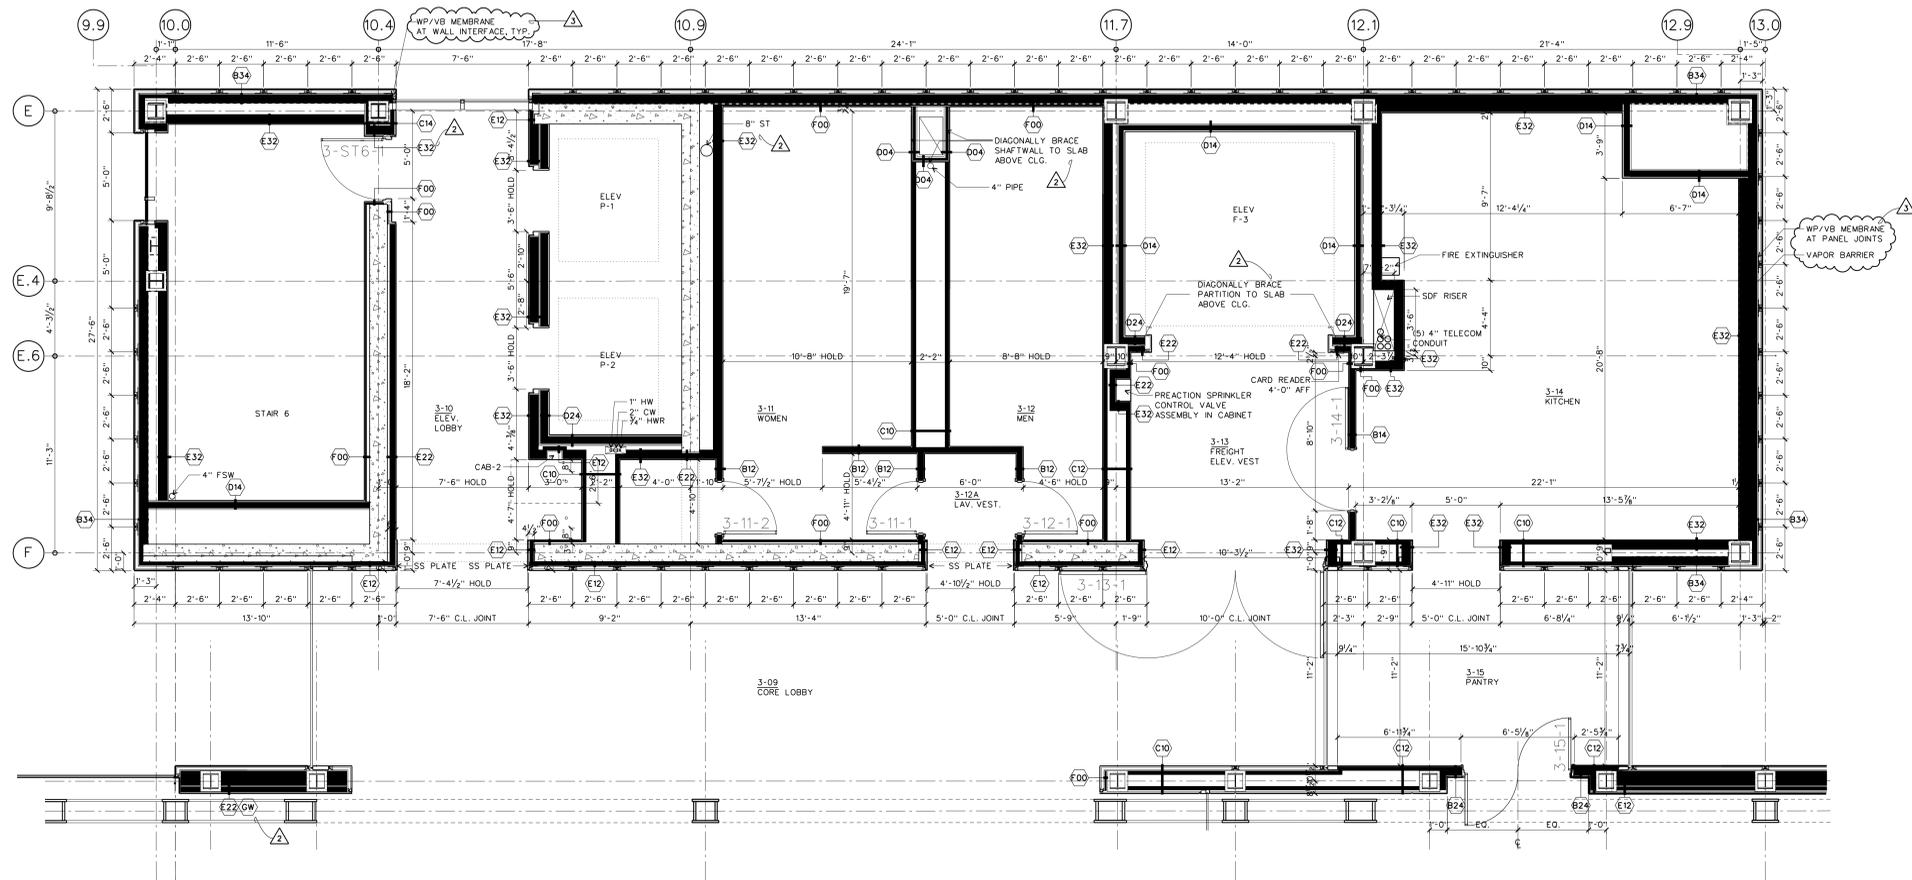

MAIN CORE: PLAN AT LOWER MUSEUM LEVEL

SCALE: 1/4" = 1'-0"

base/core 2.dgn 20

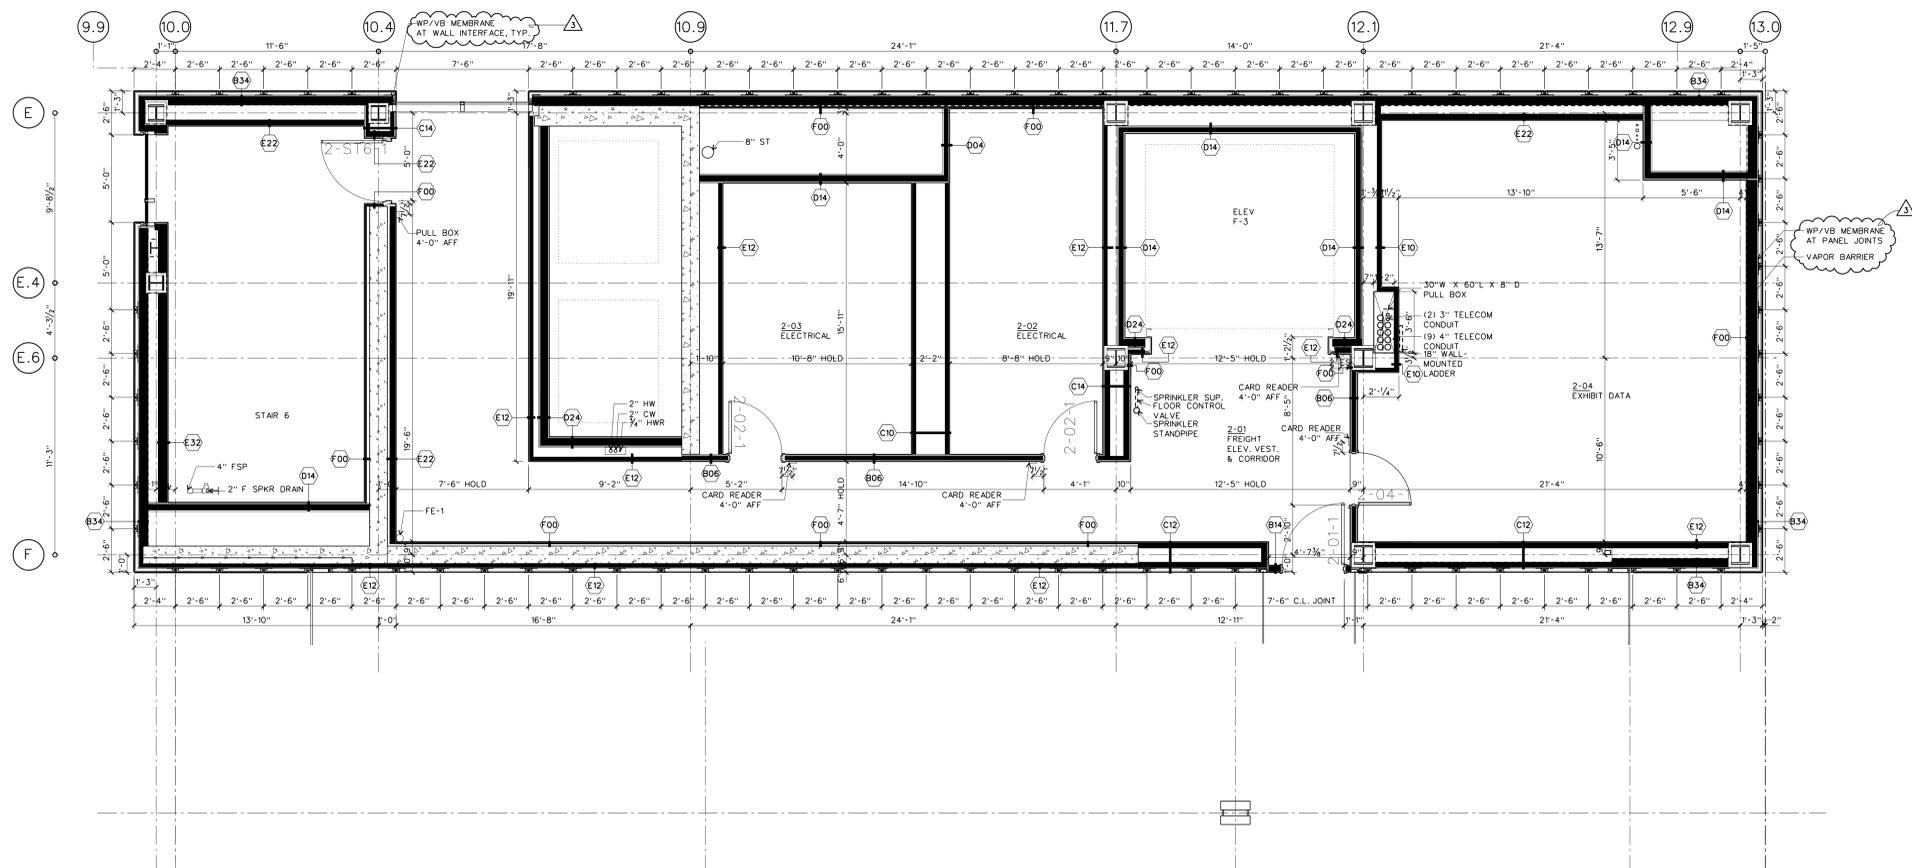

MAIN CORE: PLAN AT SECOND LEVEL

SCALE: 1/4" = 1'-0"

base/core 2.dgn 10