


Issue	Date
ASI #22	08/01/03
Addendum #7	12/20/02
Addendum #2	11/15/02

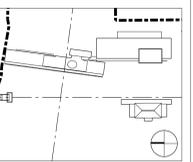

Job No. 9908

Scale 1/4" = 1'-0"


Date September 27, 2002

Title

**ENLARGED
NORTH CORE
PLANS**

Sheet No.


A543

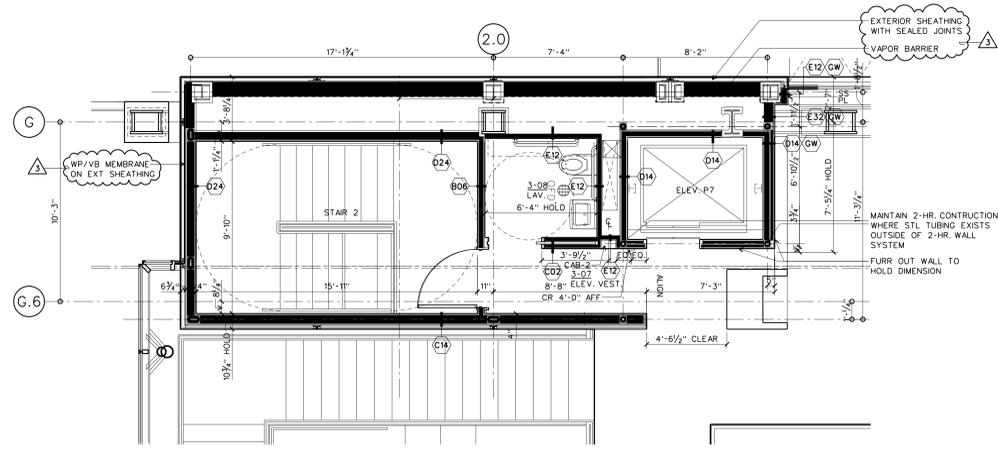

NORTH CORE: PLAN AT UPPER MUSEUM LEVEL

SCALE: 1/4" = 1'-0"


details/d-core-n01.dgn

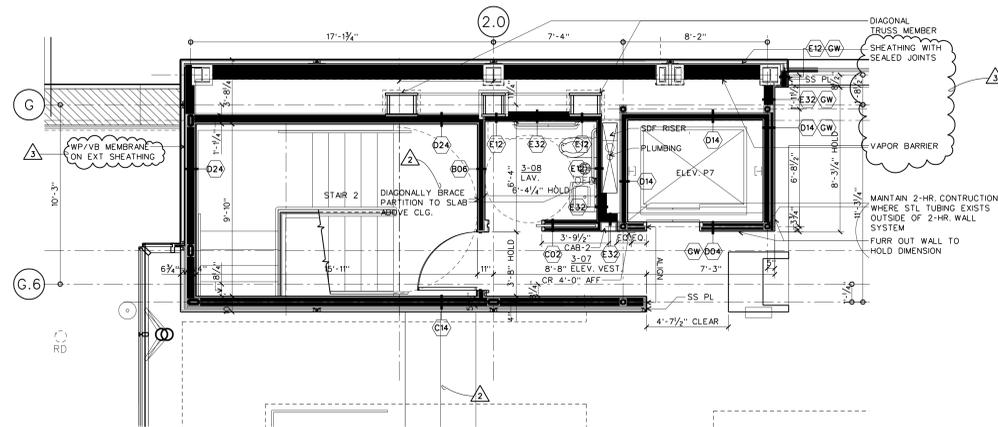

NORTH CORE: PLAN AT LOWER MUSEUM LEVEL

SCALE: 1/4" = 1'-0"

details/d-core-n01.dgn

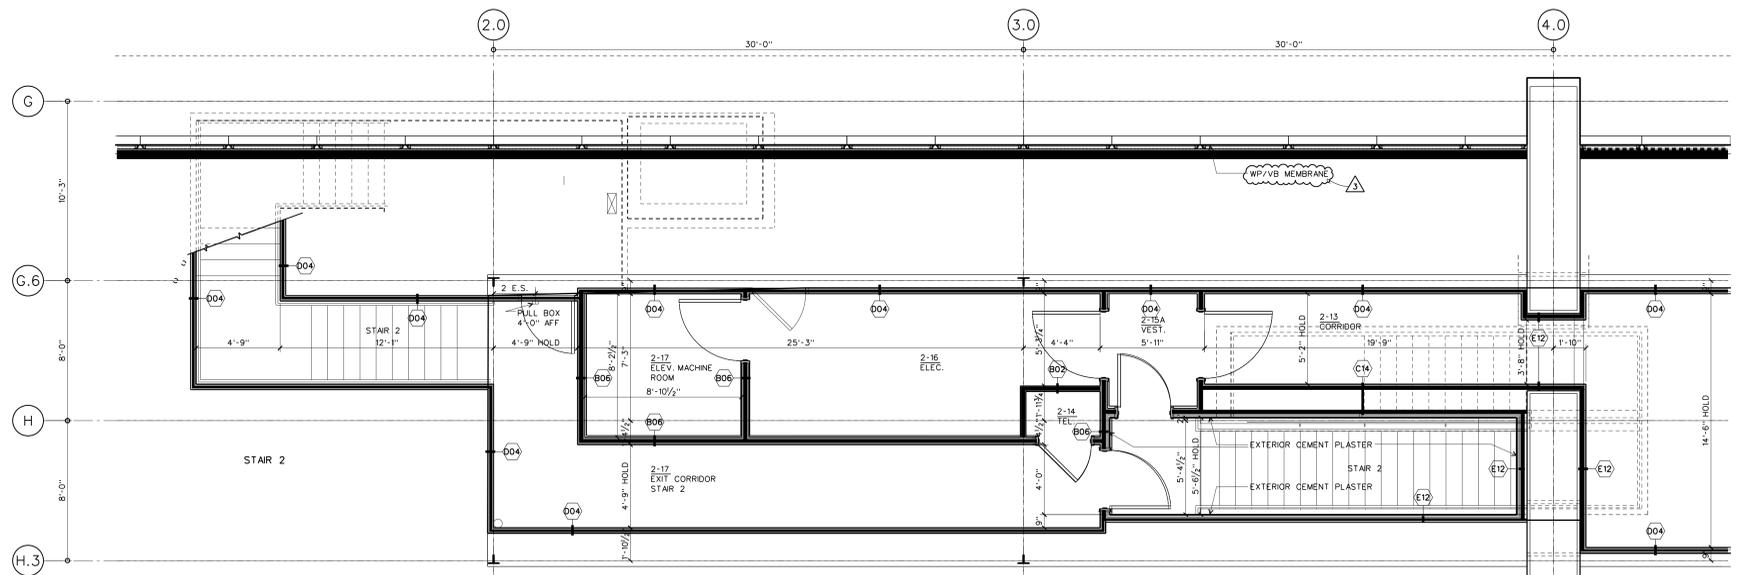

NORTH CORE: PLAN AT SERVICE LEVEL

SCALE: 1/4" = 1'-0"

details/d-core-n01.dgn